

Myers Surveying Company, Inc.

2740 East Main Street, Columbus 43209 (Bexley), Ohio

614-235-8677

FAX:614-235-4559


A Boundary Survey prepared for and certified to:

Luke S. Blazek

Legal Description: Situated in The State of Ohio, County of Franklin, City of Westerville, Being Part of Lot 12 of Sunbury Road - Walnut Street Subdivision, Plat Book 21, Page 16.

Applicant:

Posted Address: Sunbury Rd., Columbus, Ohio

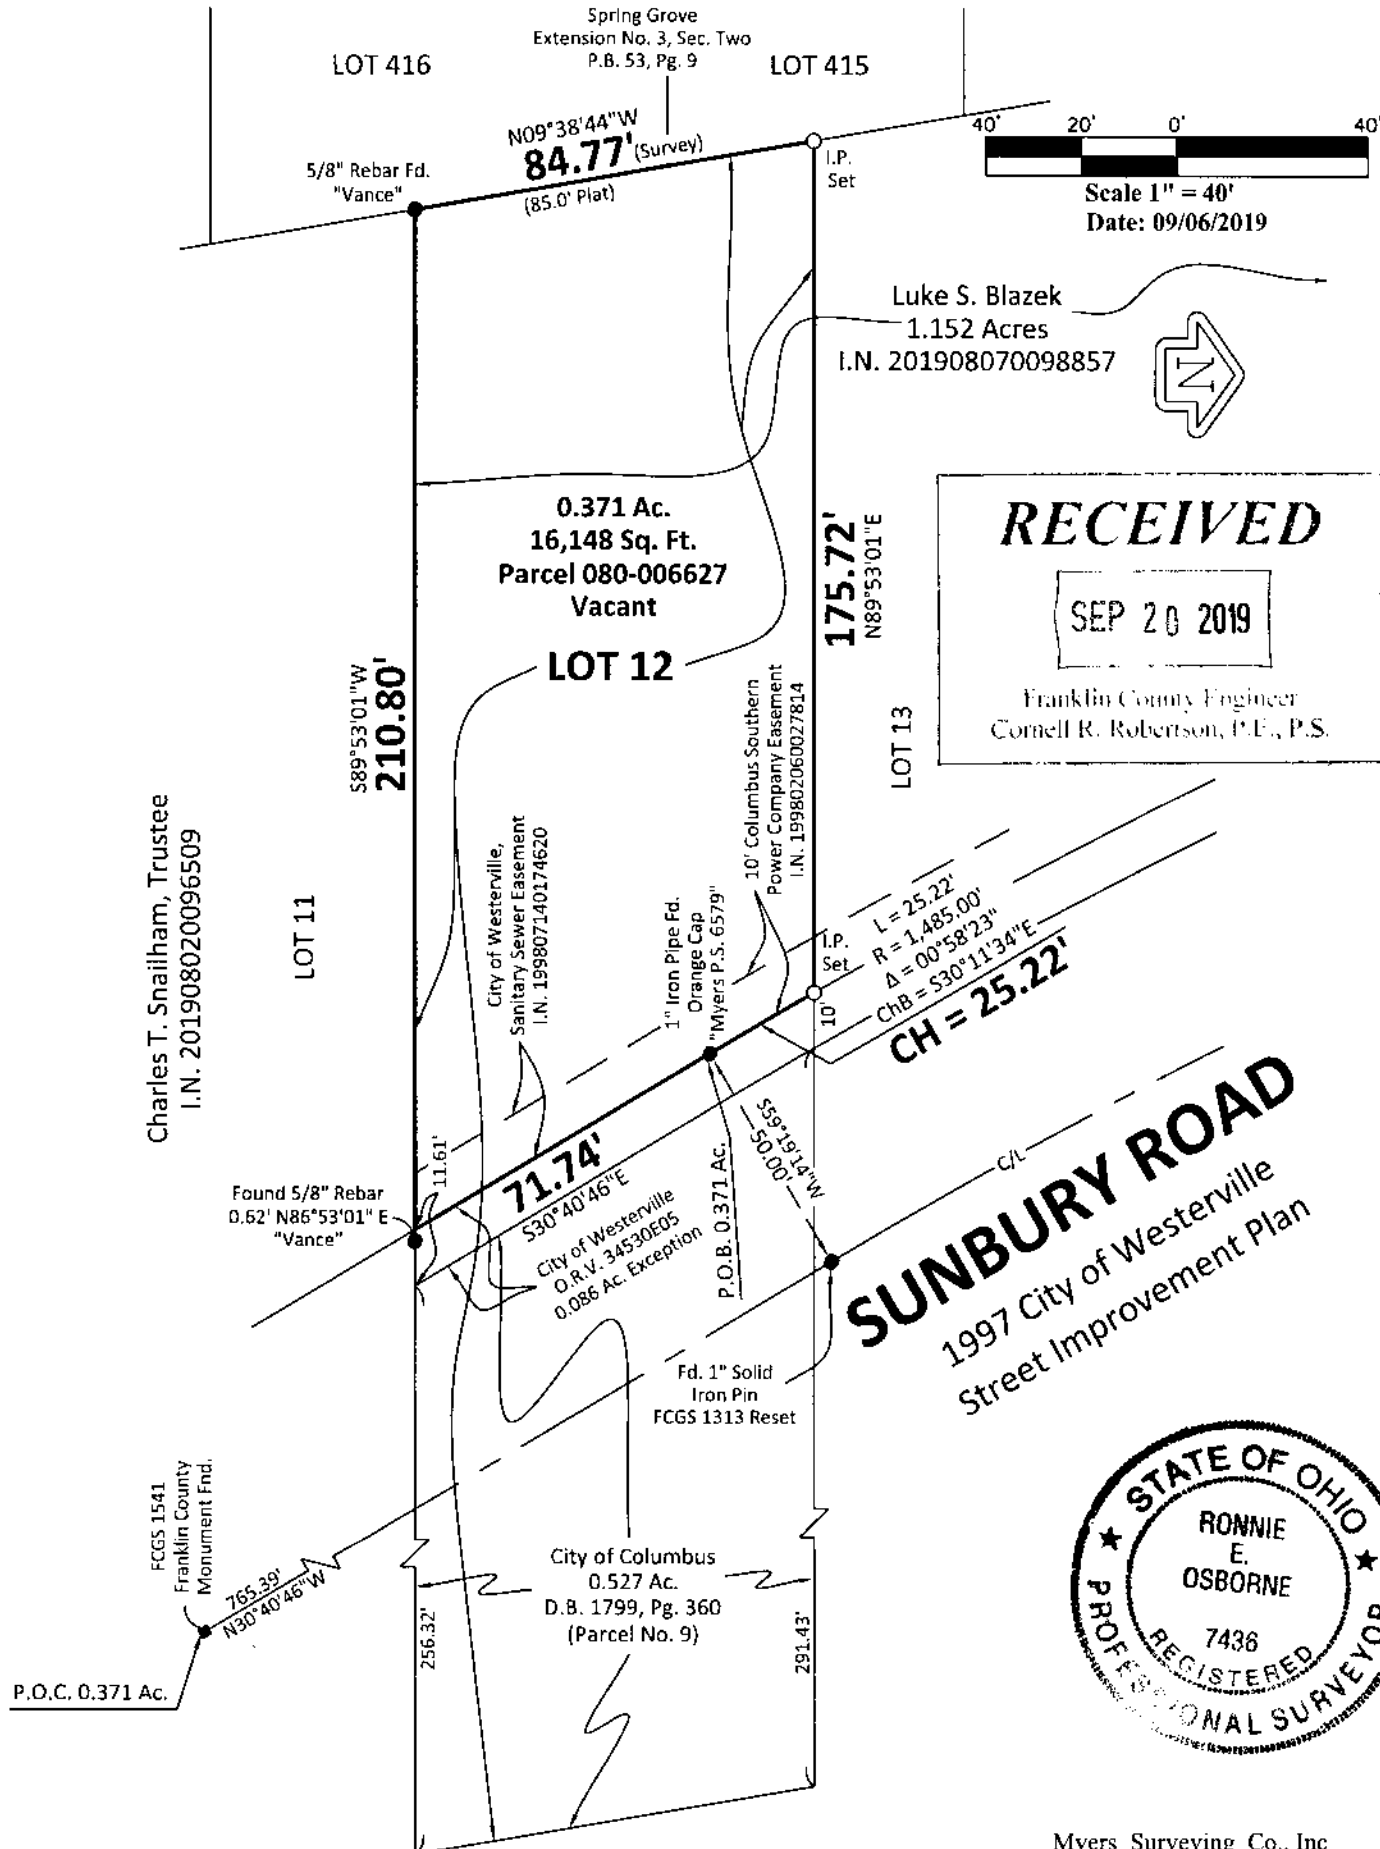

SUNBURY ROAD
 1997 City of Westerville
 Street Improvement Plan



Myers Surveying Co., Inc
 By *Ronnie E. Osborne*
 Professional Surveyor

We hereby certify that the foregoing Boundary Survey was prepared from actual field measurements in accordance with Chapter 4733-37 Ohio Administrative Code. Iron pipes set are 30"x1" O.D. with an orange plastic plug inscribed "MYERS P.S. 6579", unless otherwise noted. Basis of bearings is the East line of Spring Grove Extension No. 3, Section Two held as North 09°38'44" West per Plat Book 53, Page 9.

Myers Order No.-1-08/20/2019	Rec.	Field	DWG.	Ltr.	Ck.
------------------------------	------	-------	------	------	-----