

Myers Surveying Company, Inc.

2740 East Main Street, Columbus 43209 (Bexley), Ohio
614-235-8677 FAX:614-235-4559


A Boundary Survey prepared for and certified to:

Luke S. Blazek


Legal Description: Situated in The State of Ohio, County of Franklin, City of Westerville, Being Part of Lot 15 of Sunbury Road-Walnut Street Subdivision, Plat Book 21, Page 16

Applicant:

Posted Address: Sunbury Road, Westerville, Ohio

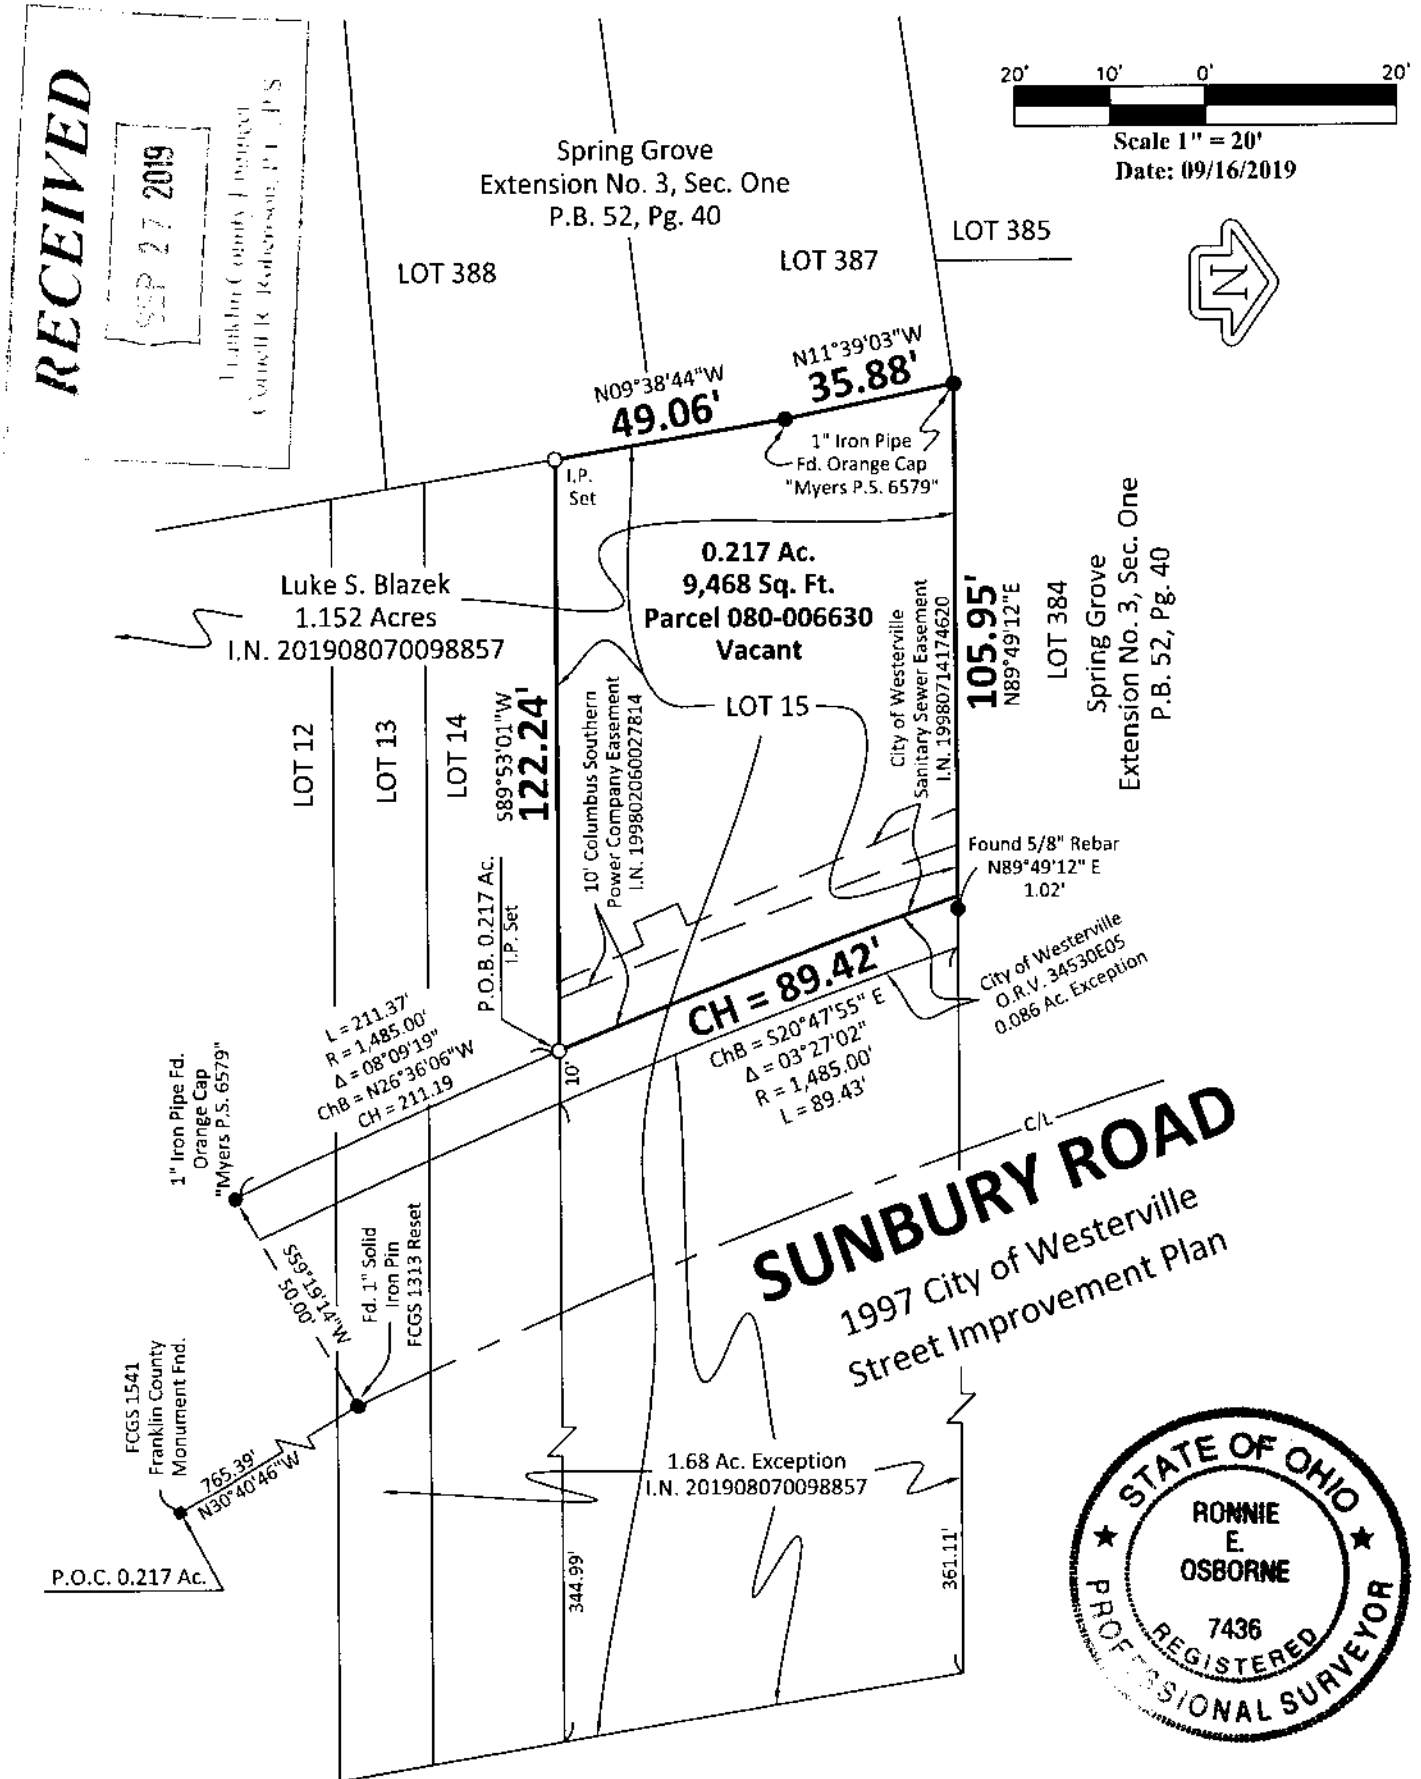

RECEIVED
 SEP 27 2019
 Franklin County Engineer
 Council R. Robinson, P.E., P.S.

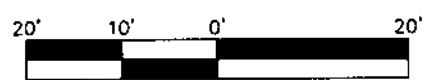

Scale 1" = 20'
 Date: 09/16/2019



Myers Surveying Co., Inc
 By *Ronnie E. Osborne*
 Professional Surveyor

We hereby certify that the foregoing Boundary Survey was prepared from actual field measurements in accordance with Chapter 4733-37 Ohio Administrative Code. Iron pipes set are 30"x1" O.D. with an orange plastic plug inscribed "MYERS P.S. 6579", unless otherwise noted. Basis of bearings is the east line of Spring Grove Extension No. 3, Section Two held as North 09°38'44" West per Plat Book 53, Page 9.

Myers Order No.-1-08/20/2019	Rec.	Field	DWG.	Ltr.	Ck.
------------------------------	------	-------	------	------	-----