

Myers Surveying Company, Inc.

2740 East Main Street, Columbus 43209 (Bexley), Ohio
614-235-8677 FAX:614-235-4559

A Boundary Survey prepared for and certified to:


867 High Street Condominium Association

Legal Description: Situated in The State of Ohio, County of Franklin, City of Worthington, Being Part of Lots 28 and 37 of the Town Plat of Worthington, as shown of record in Plat Book 3, Page 330


Applicant:

Posted Address: 867 High Street, Worthington, Ohio

John S. & Toni L. Davis
ORV. 15172, A19
752 S.F. Tract
Angus Fletcher &
Sarah Lagrotteria
I.N. 201311040185165
N05°53'17"E
I.P. Set
53.17'

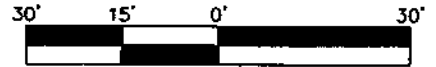

Scale 1" = 30'
Date: 08/26/2019

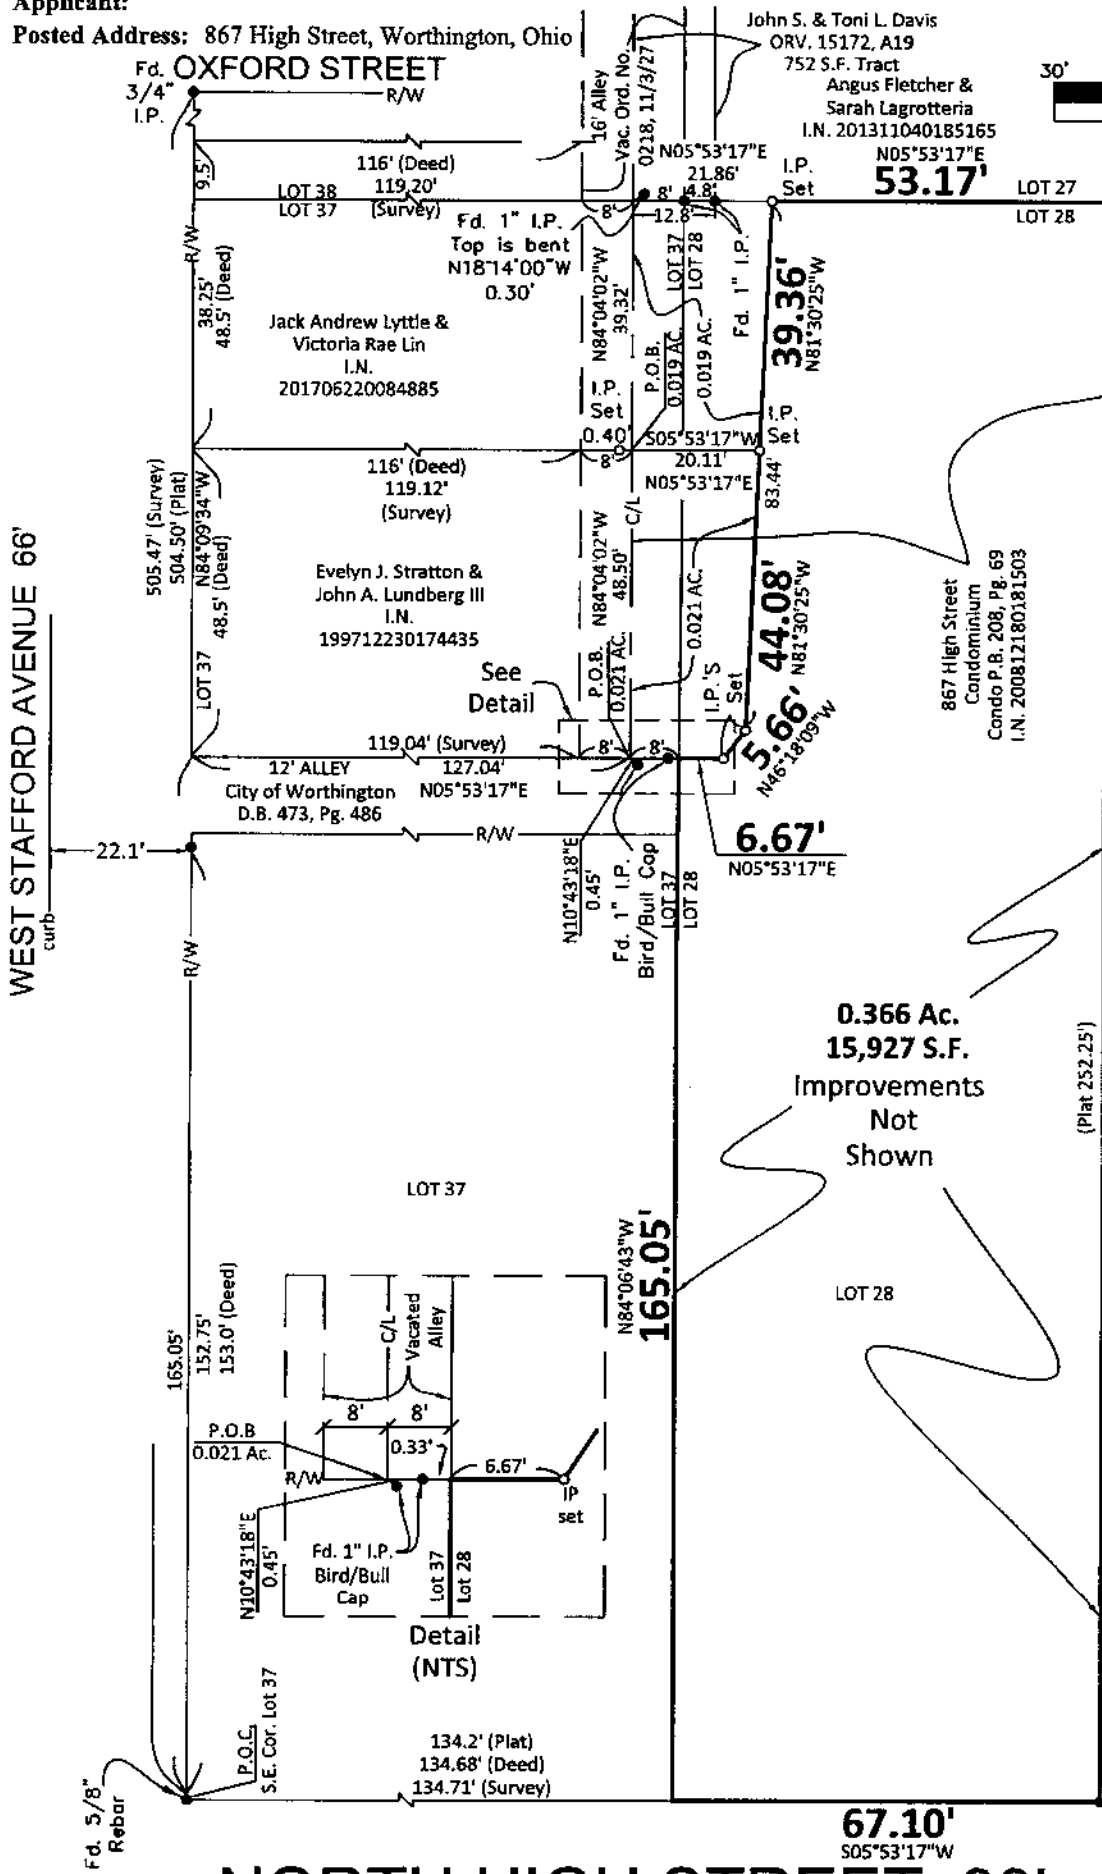

WEST STAFFORD AVENUE 66'

0.366 Ac.
15,927 S.F.
Improvements
Not
Shown

(Plat 252.25)
252.875'
S84°06'43"E



NORTH HIGH STREET 99'

We hereby certify that the foregoing Boundary Survey was prepared from actual field measurements in accordance with Chapter 4733-37 Ohio Administrative Code. Iron pipes set are 30"x1" O.D. with an orange plastic plug inscribed "MYERS P.S. 6579", unless otherwise noted. Basis of bearings is the west line of High Street held as N 05°53'17" E per I.N. 200812180181504.

Myers Surveying Co., Inc
By *Joseph P. Myers*
8/16/2019
Professional Surveyor

Myers Order No.-1-11/01/2018	Rec.	Field	DWG.	Ltr.	Chk.
------------------------------	------	-------	------	------	------