



BOUNDARY SURVEY OF A 0.067 ACRE TRACT

SITUATED IN THE STATE OF OHIO, COUNTY OF FRANKLIN, CITY OF COLUMBUS,
 BEING PART OF LOT NUMBER (12) TWELVE OF MORRISON AND OTHERS SUBDIVISION
 OF LOTS NUMBER 219 AND 220 OF MORRISON PARK ADDITION TO THE CITY OF
 COLUMBUS, AS THE SAME IS NUMBERED AND DELINEATED UPON THE RECORDED
 PLAT THEREOF, OF RECORD IN PLAT BOOK 5, PAGE 257, AS CONVEYED TO THE OLDE TOWNE
 BUILDING COMPANY, LLC IN INSTRUMENT NUMBER 201808130107801

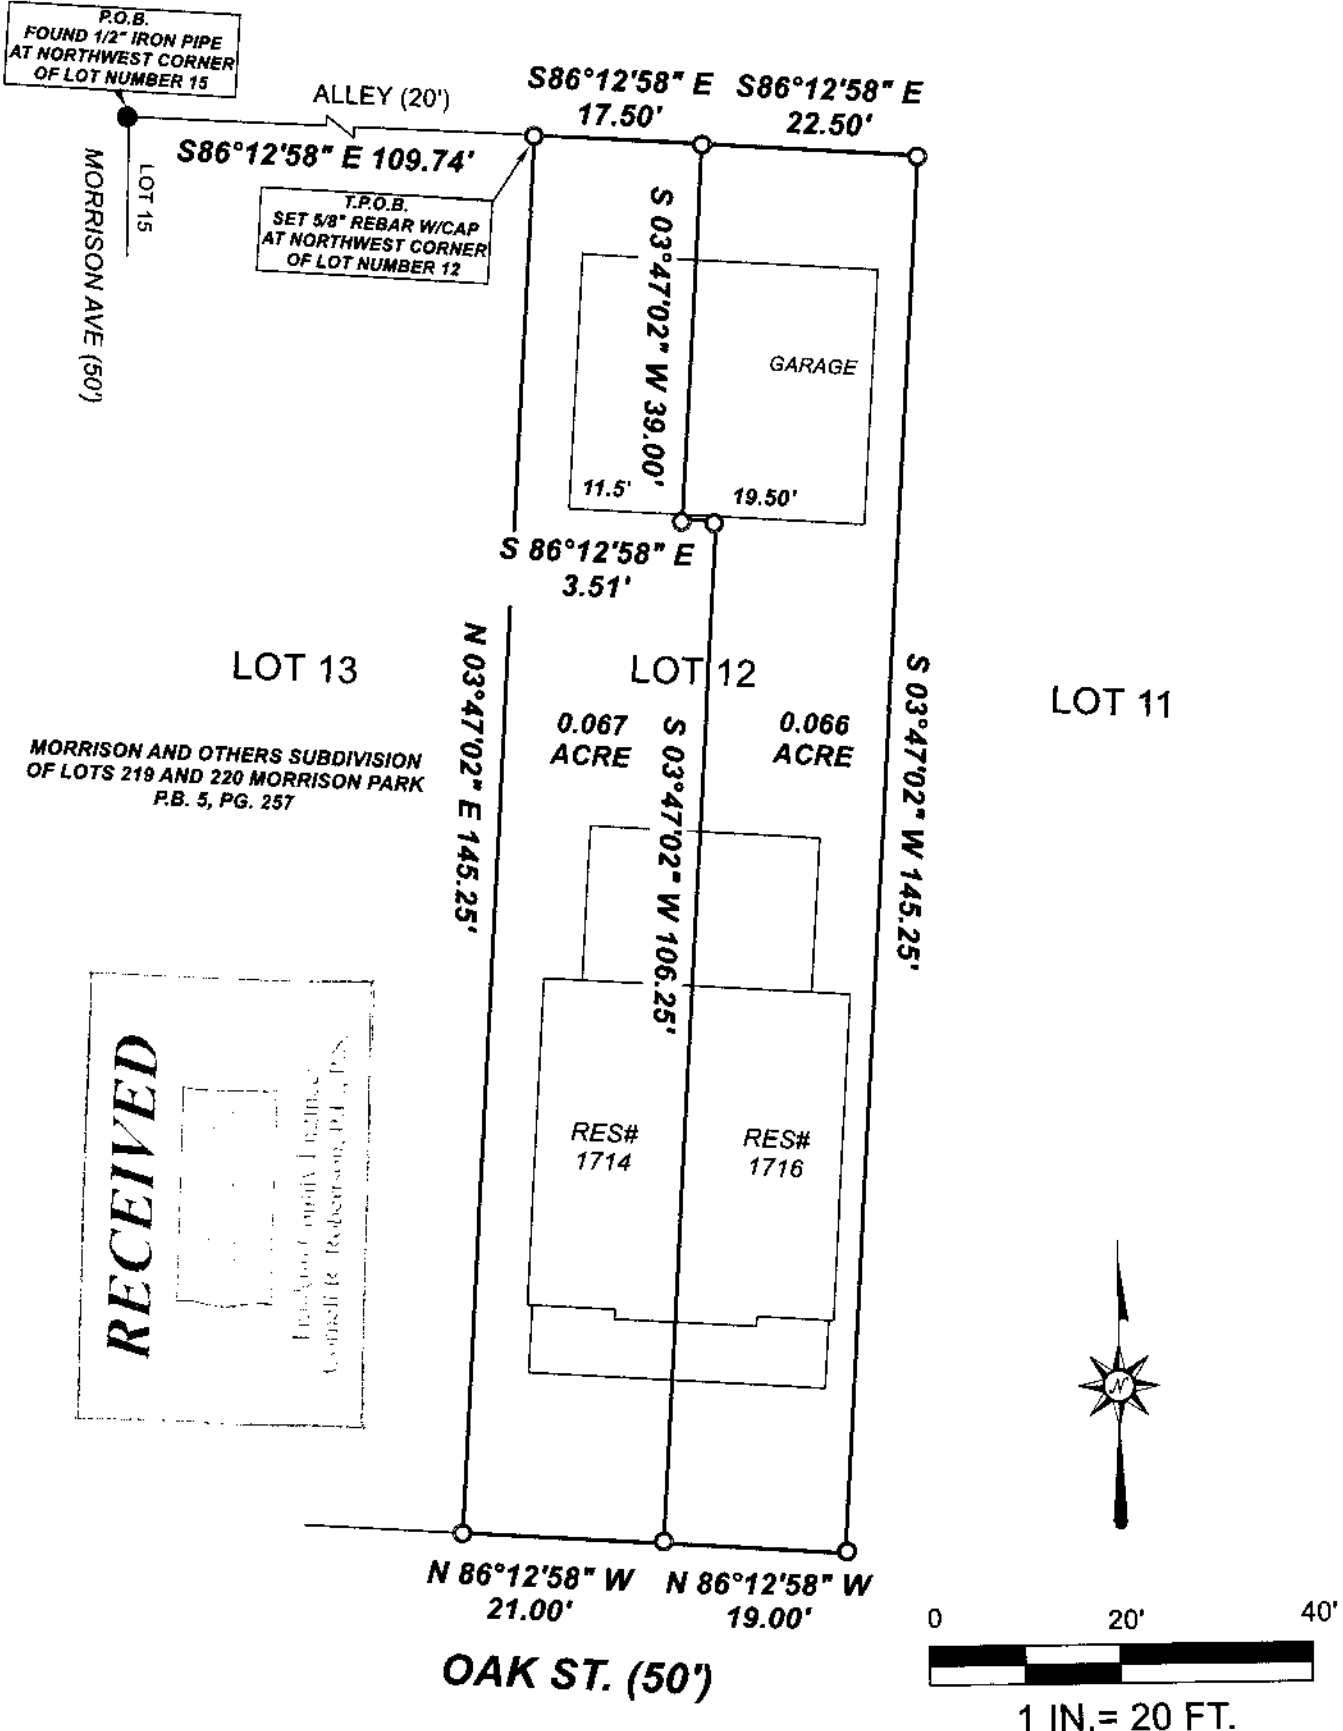

RECEIVED

Franklin County Engineer
 Council B. Redmon, P.E., P.S.

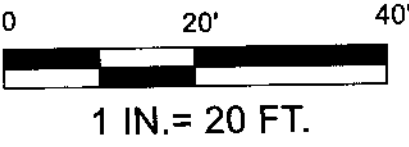

BASIS OF BEARINGS:
 THE CENTERLINE OF OAK ST.
 AS BEING S 86°12'58" E

I HEREBY CERTIFY THAT THE ATTACHED PLAT WAS
 PREPARED FROM INFORMATION OBTAINED FROM AN
 ACTUAL FIELD SURVEY OF THE PREMISES AND THAT SAID
 PLAT IS CORRECT TO THE BEST OF MY KNOWLEDGE

Anthony W. Williams 10-15-19
 REG. SURVEYOR NO. 7726 OCT 15, 2019
 ANTHONY W. WILLIAMS



LEGEND	
●	FOUND 1/2" REBAR
○	SET 5/8" REBAR W/ ACKISON CAP

ACKISON
 Office: 614-766-4000
 Cell: 614-207-8214