



VANCE SURVEYING LTD.

15071 HYATT ROAD
MOUNT VERNON, OHIO 43050

PH. (740) 397-6296
FAX (740) 397-6032
vancesurveying@gmail.com

SURVEY FOR
PAUL DORAN
NORTHEAST QUARTER OF SECTION 2, TOWNSHIP 2N, RANGE 16W, USML,
PLAIN TOWNSHIP, FRANKLIN COUNTY, STATE OF OHIO

SCALE: 1" = 300'

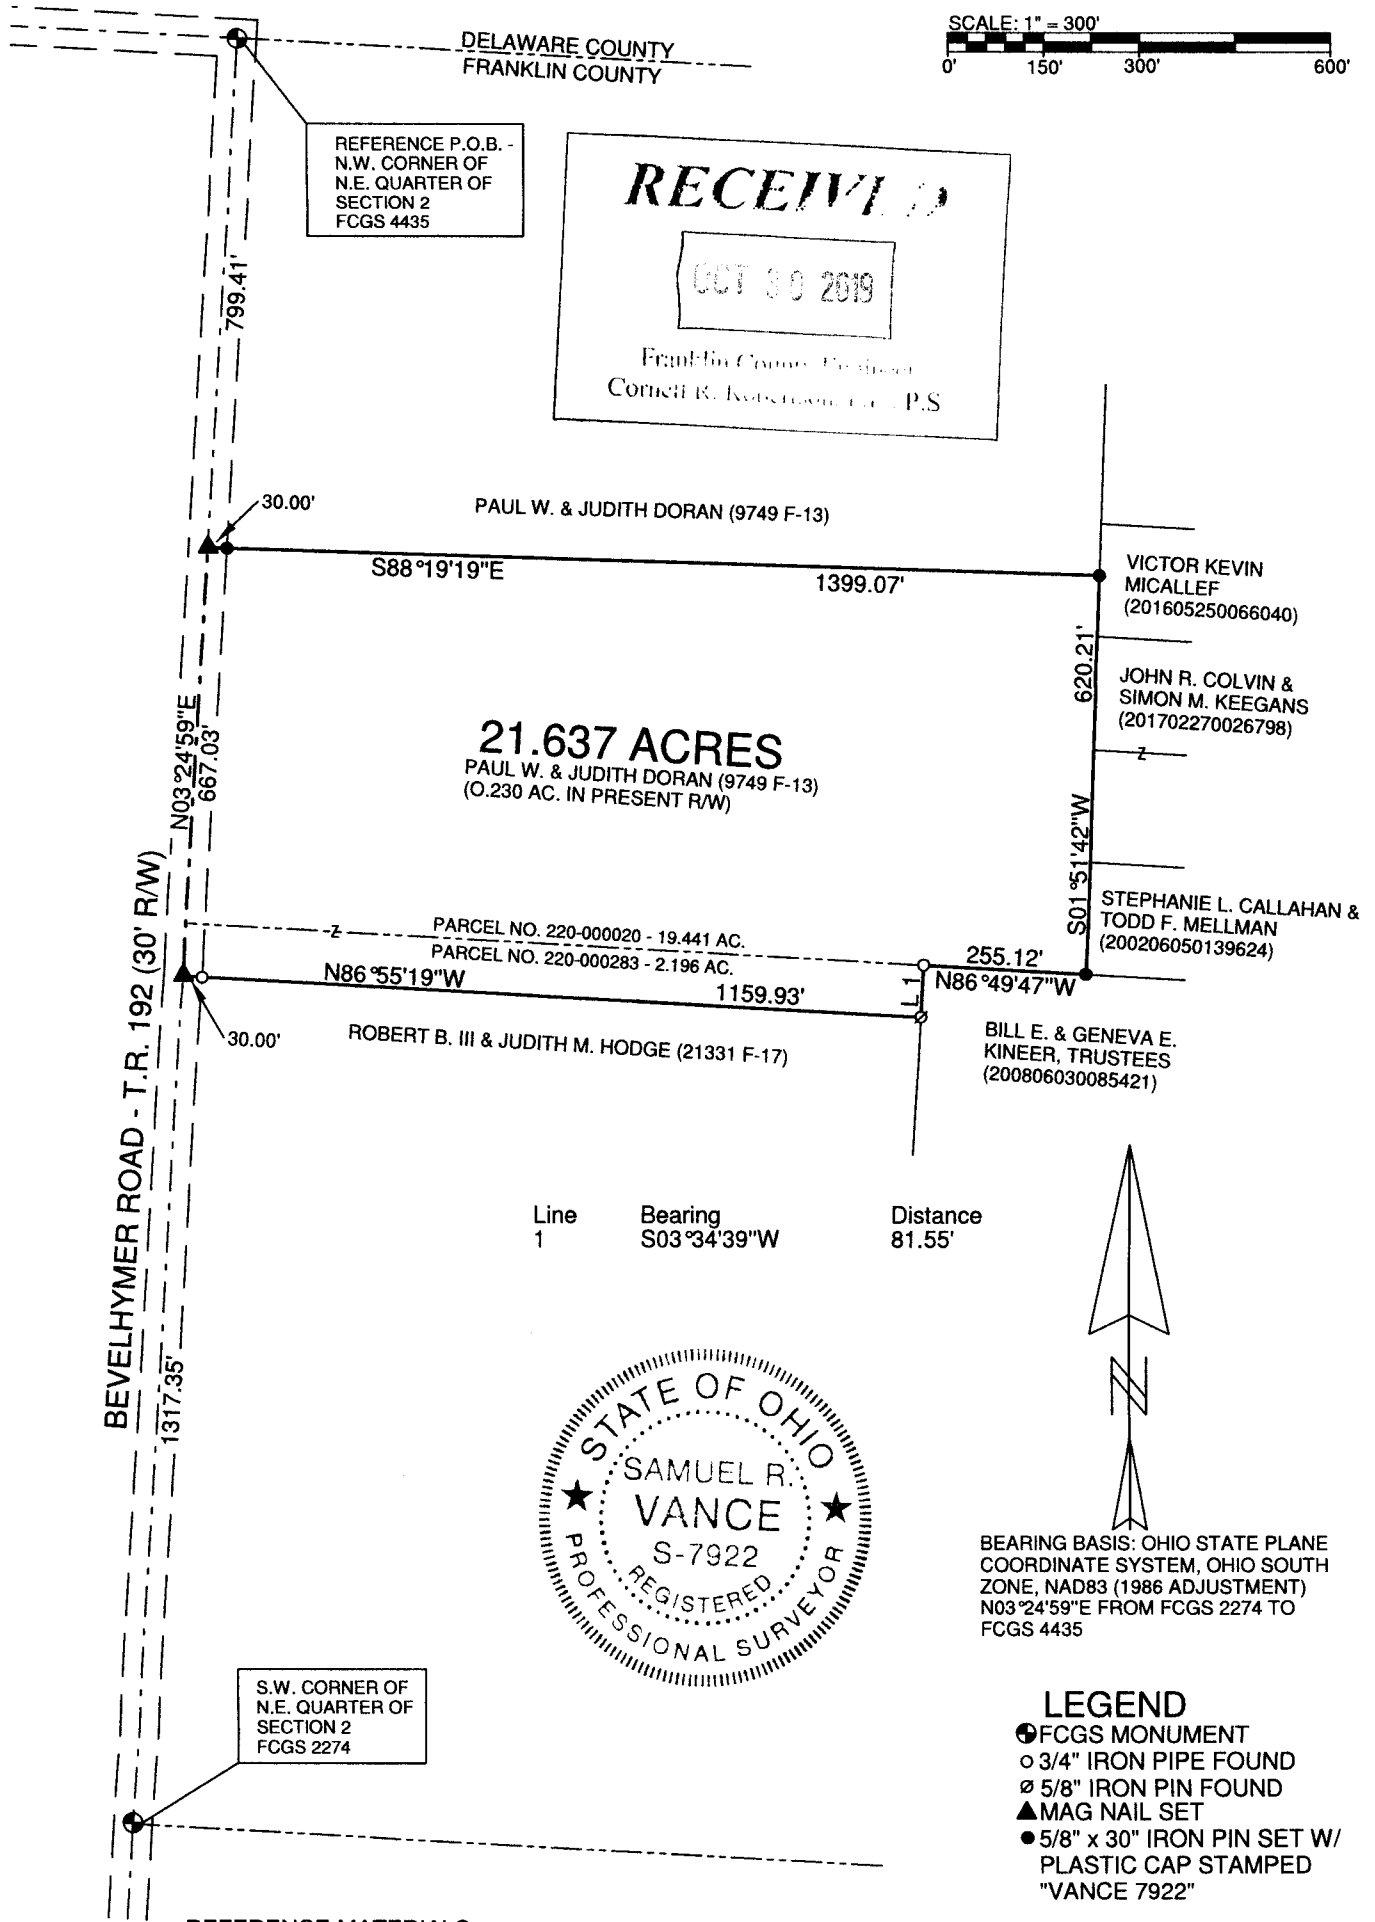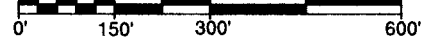

- LEGEND**
- FCGS MONUMENT
 - 3/4" IRON PIPE FOUND
 - ∅ 5/8" IRON PIN FOUND
 - ▲ MAG NAIL SET
 - 5/8" x 30" IRON PIN SET W/ PLASTIC CAP STAMPED "VANCE 7922"

REFERENCE MATERIALS:
FRANKLIN COUNTY GIS
ALL DEEDS AS SHOWN

CERTIFICATION: WE HEREBY CERTIFY THAT THE FOREGOING SURVEY WAS PREPARED FROM ACTUAL FIELD MEASUREMENTS, IN ACCORDANCE WITH CHAPTER 4733-37, OHIO ADMINISTRATIVE CODE.

Samuel R. Vance

SAMUEL R. VANCE
REGISTERED SURVEYOR NO. 7922

OCTOBER 7, 2019

DRAWN BY: SRV