Z-8-C

EMH&T
Evans, Mechwart, Hambleton & Tilton, Inc.
Engineers • Surveyors • Planners • Scientists
5500 New Albany Road, Columbus, OH 43054
Phone: 614.775.4500 Toll Free: 888.775.3648
emht.com

SURVEY OF ACREAGE PARCEL

FARM LOT 8, QUARTER TOWNSHIP 3, TOWNSHIP 2, RANGE 16
UNITED STATES MILITARY DISTRICT
CITY OF COLUMBUS, COUNTY OF FRANKLIN, STATE OF OHIO

Date: February 6, 2020 | Job No: 2019-1324 | Scale: 1" = 100'

LINE TABLE		
LINE	BEARING	DISTANCE
L1	S08°22'45"E	2.10'
L2	S83°05'18"W	5.83'

CURVE TABLE					
CURVE	DELTA	RADIUS	ARC	CH. BEARING	CH. DIST.
C1	1°30'42"	14191.83'	374.40'	N84°18'03"E	374.39'
C2	0°30'15"	14191.83'	124.91'	N83°47'50"E	124.90'
C3	1°17'42"	5729.58'	129.49'	N84°24'33"E	129.48'

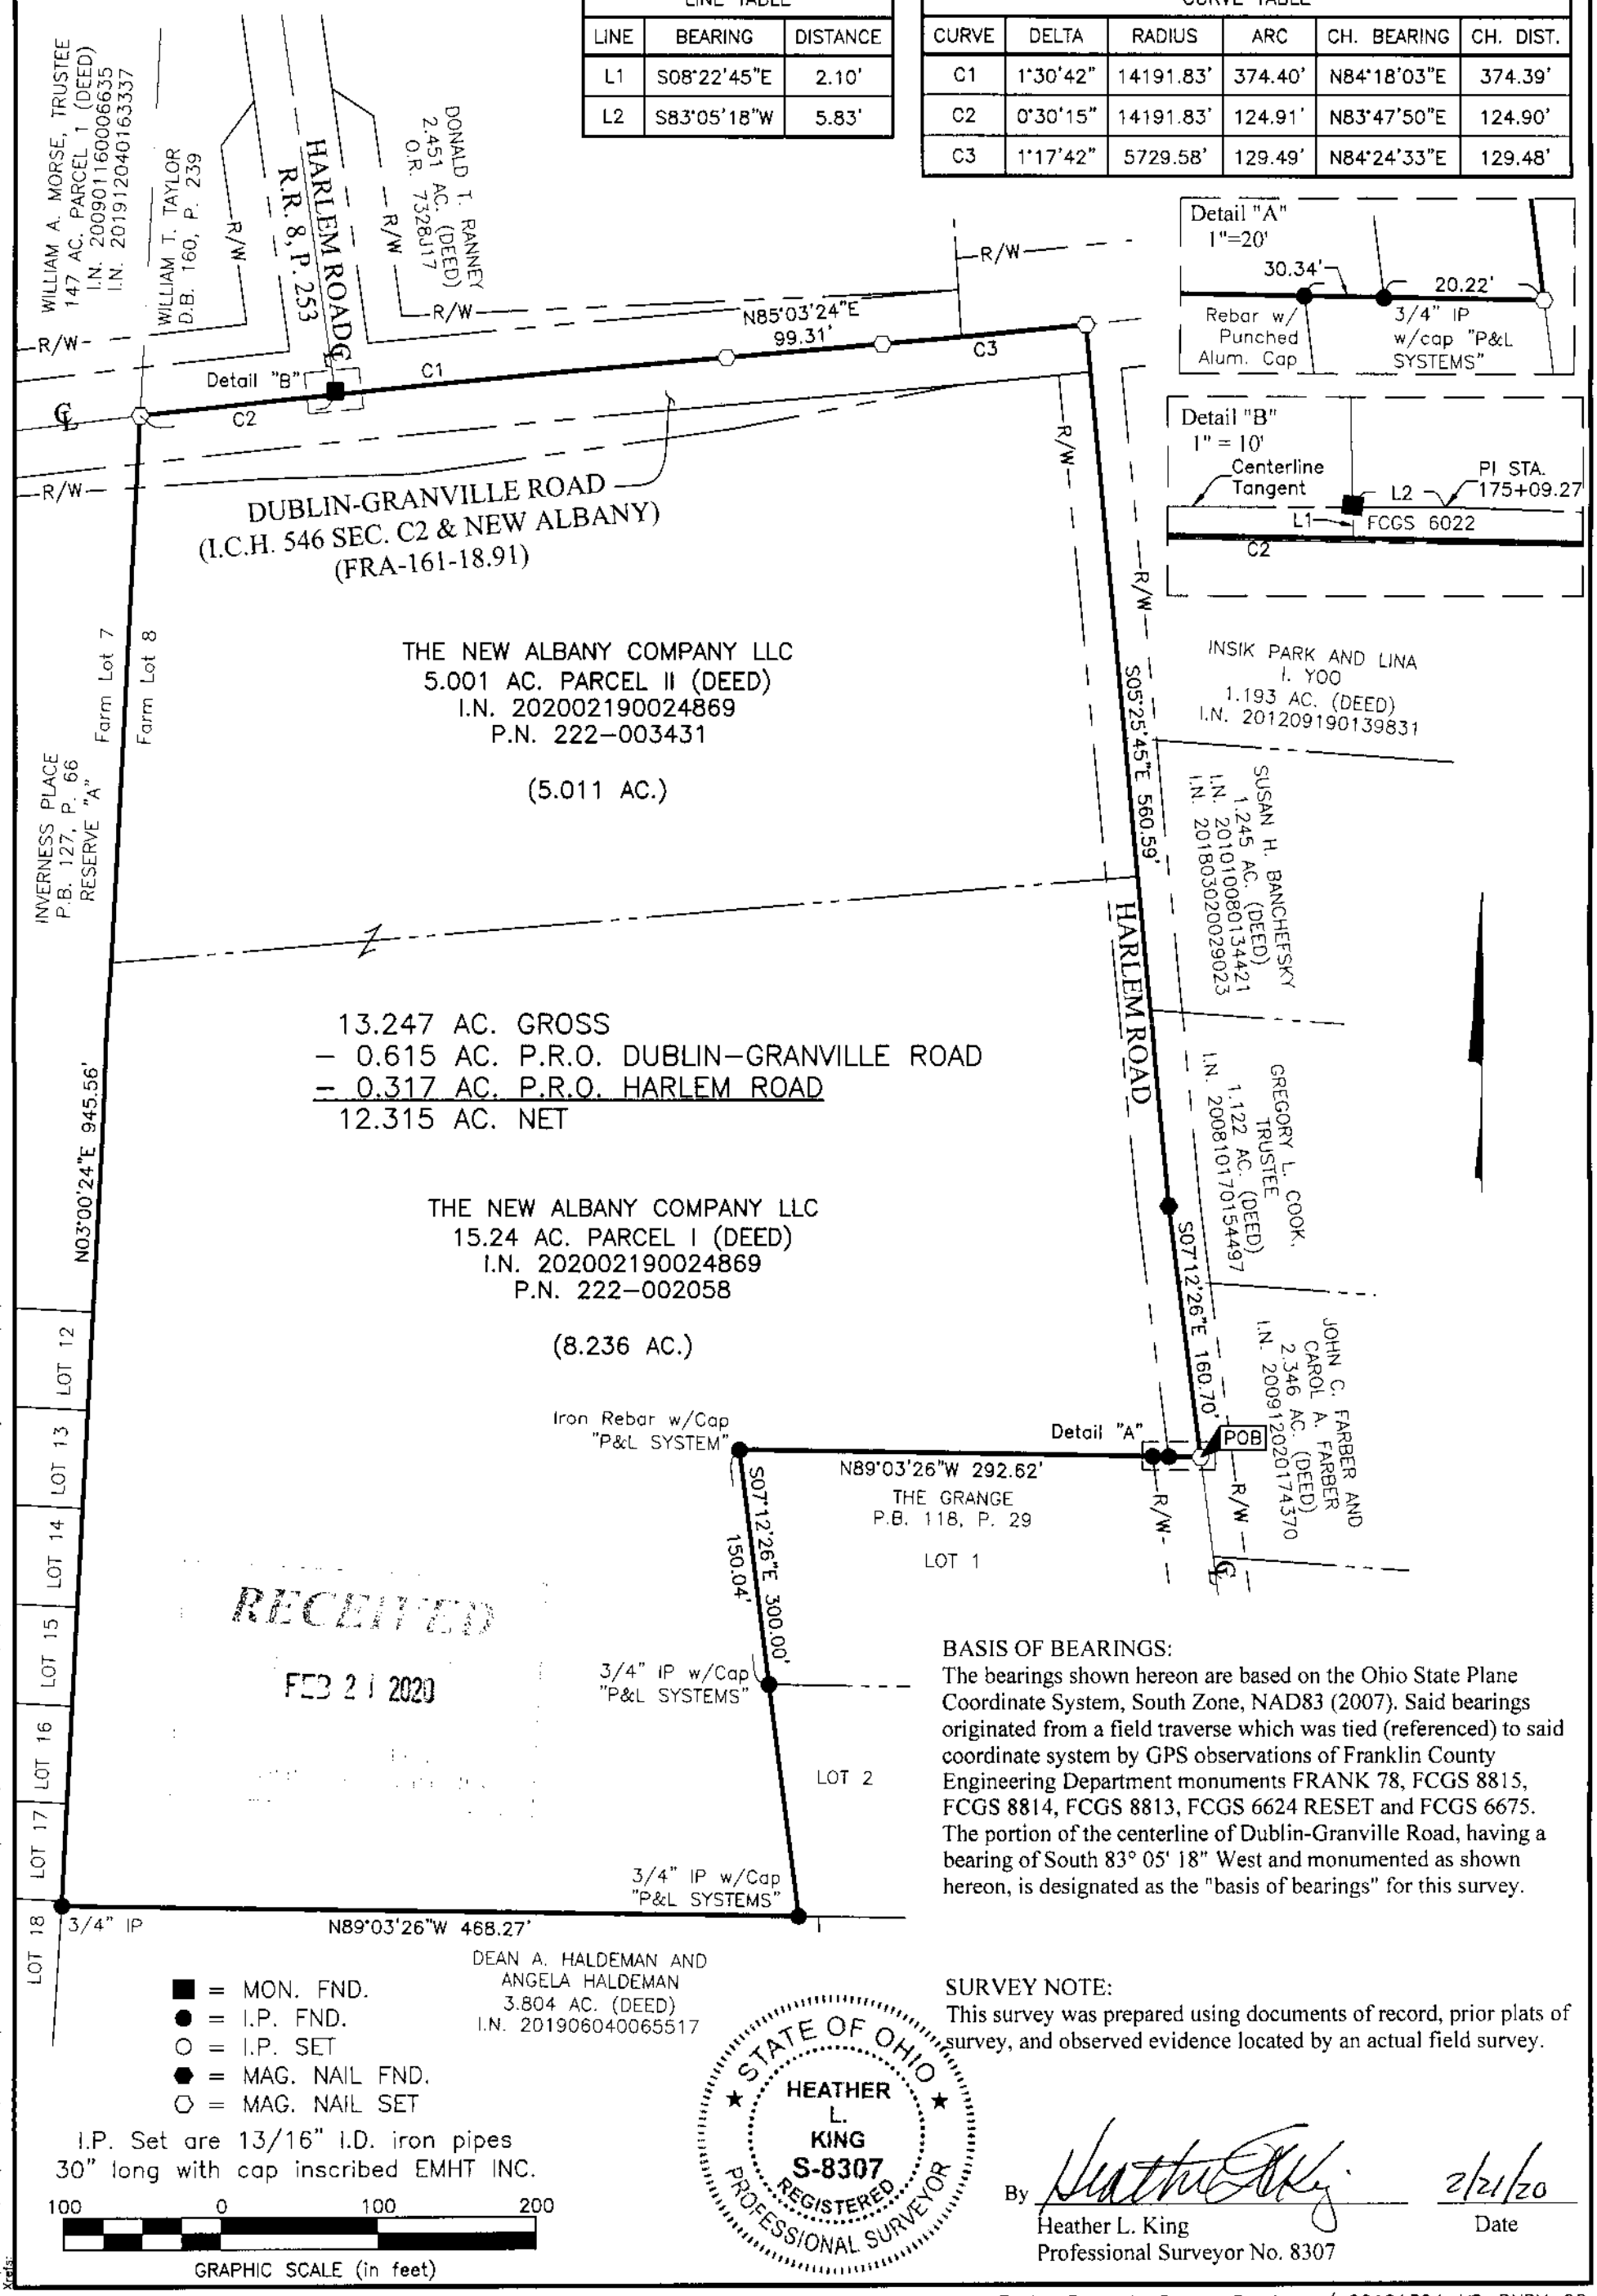

RECEIVED
FEB 21 2020

BASIS OF BEARINGS:
The bearings shown hereon are based on the Ohio State Plane Coordinate System, South Zone, NAD83 (2007). Said bearings originated from a field traverse which was tied (referenced) to said coordinate system by GPS observations of Franklin County Engineering Department monuments FRANK 78, FCGS 8815, FCGS 8814, FCGS 8813, FCGS 6624 RESET and FCGS 6675. The portion of the centerline of Dublin-Granville Road, having a bearing of South 83° 05' 18" West and monumented as shown hereon, is designated as the "basis of bearings" for this survey.

SURVEY NOTE:
This survey was prepared using documents of record, prior plats of survey, and observed evidence located by an actual field survey.

STATE OF OHIO
HEATHER L. KING
S-8307
REGISTERED
PROFESSIONAL SURVEYOR

By _____ 2/21/20
Heather L. King
Professional Surveyor No. 8307
Date

J:\20191324\DWG\04SHEETS\BOUNDARY\20191324-VS-BNDY-02.DWG plotted by KING, HEATHER on 2/20/2020 5:41:22 PM last saved by HKING on 2/18/2020 4:55:48 PM
Xrefs: