

FEB 21 2020




TOWNSHIP 1, QUARTER TOWNSHIP 3, RANGE 18
UNITED STATES MILITARY DISTRICT
CITY OF COLUMBUS, COUNTY OF FRANKLIN, STATE OF OHIO

Date: January 28, 2020

Job No: 2019-1097

Scale: 1" = 200'

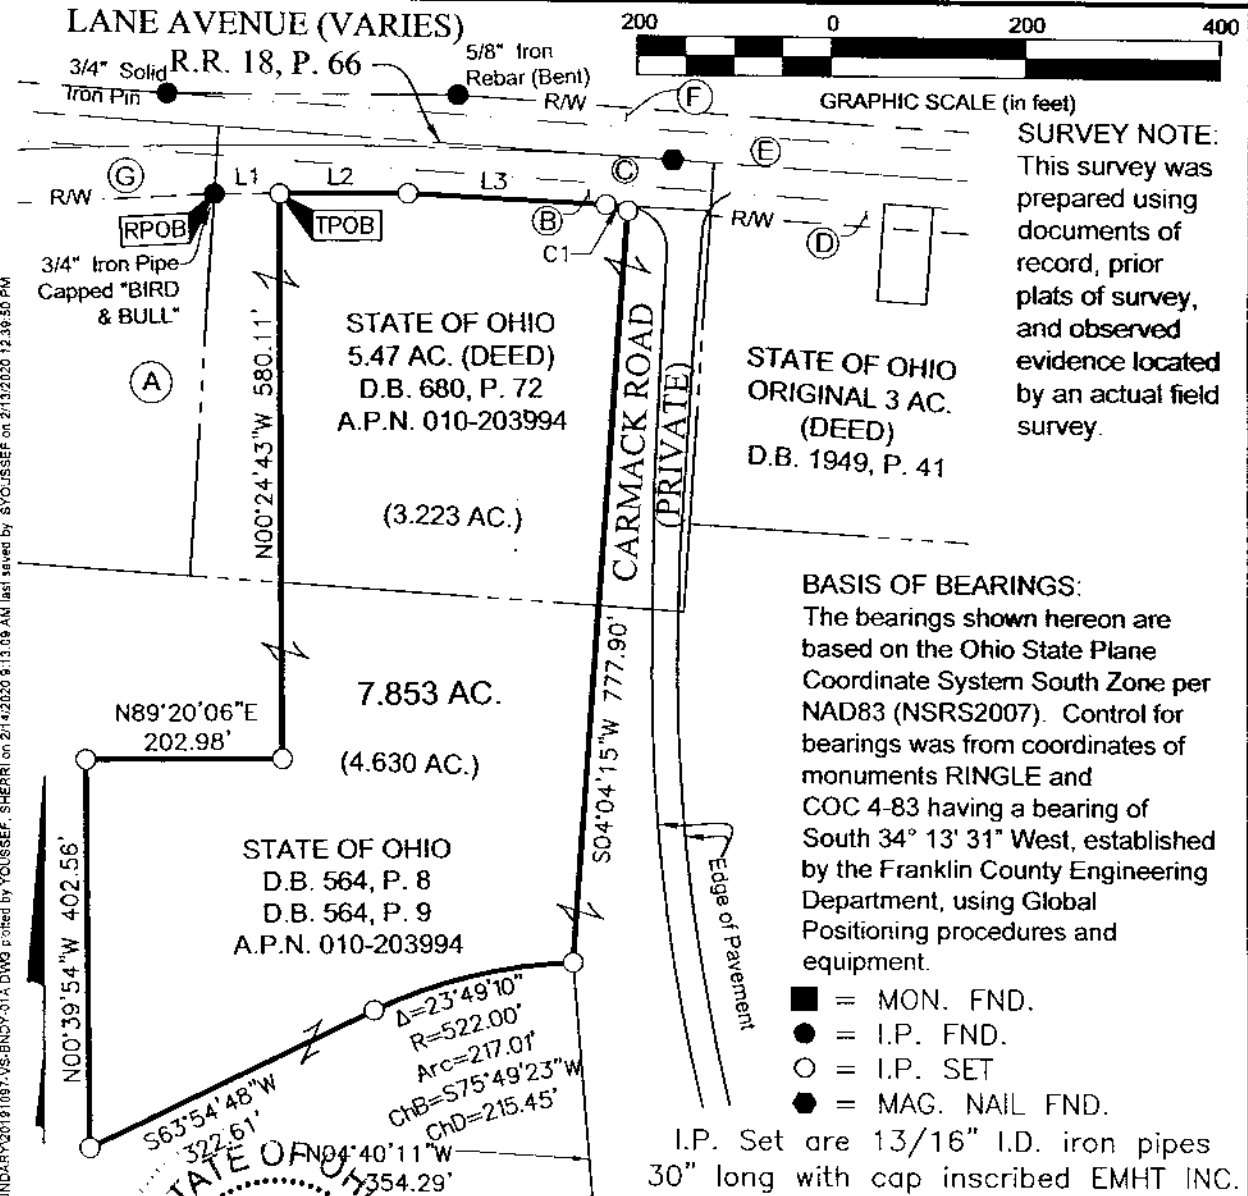

J:\2019\1097\DWG\PLATS\BOUNDARY\2019\1097_VS-BNDY-01A.DWG plotted by T\OUSSEF, SHERRI on 2/14/2020 9:13:09 AM last saved by S\YOUSSEF on 2/13/2020 12:39:50 PM

By John C. Dodgins Professional Surveyor No. 8069 Date 02/19/2020

FEB 21 2020

6-7-D



Evans, Mechwart, Hambleton & Tilton, Inc.
 Engineers • Surveyors • Planners • Scientists
 5500 New Albany Road, Columbus, OH 43054
 Phone: 614.775.4500 Toll free: 866.775.3646
 emht.com

TOWNSHIP 1, QUARTER TOWNSHIP 3, RANGE 18
 UNITED STATES MILITARY DISTRICT
 CITY OF COLUMBUS, COUNTY OF FRANKLIN, STATE OF OHIO


Date: January 28, 2020

Job No: 2019-1097

Scale: 1" = 200'

- (A) STATE OF OHIO
3.90 ACRES (DEED)
D.B. 680, P. 73
- (B) EASEMENT FOR HIGHWAY PURPOSES
BOARD OF COUNTY COMMISSIONERS OF
FRANKLIN COUNTY, OHIO
ENGNRS. PARCEL NO. 9
D.B. 1895, P. 254
- (C) EASEMENT FOR HIGHWAY PURPOSES
FRANKLIN COUNTY, OHIO
PARCEL 5 0.353 AC. (DEED)
D.B. 1086, P. 614
- (D) EASEMENT FOR HIGHWAY PURPOSES
BOARD OF COUNTY COMMISSIONERS OF
FRANKLIN COUNTY, OHIO
ENGNRS. PARCEL NO. 10
D.B. 1847, P. 537
- (E) EASEMENT FOR HIGHWAY PURPOSES
FRANKLIN COUNTY, OHIO
PARCEL 1
D.B. 1086, P. 614
- (F) EASEMENT FOR HIGHWAY PURPOSES
BOARD OF COUNTY COMMISSIONERS OF
FRANKLIN COUNTY, OHIO
ENGNRS. PARCEL NO. 14
D.B. 1845, P. 254
- (G) EASEMENT FOR HIGHWAY PURPOSES
BOARD OF COUNTY COMMISSIONERS OF
FRANKLIN COUNTY, OHIO
ENGNRS. PARCEL NO. 8
D.B. 1895, P. 254

LINE TABLE		
LINE	BEARING	DISTANCE
L1	N89°23'20"E	67.57'
L2	N89°23'20"E	132.76'
L3	S87°13'59"E	204.36'

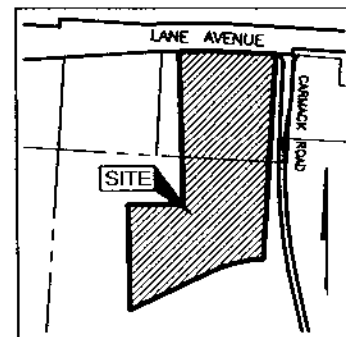

LOCATION MAP AND BACKGROUND DRAWING
 NOT TO SCALE

CURVE TABLE					
CURVE	DELTA	RADIUS	ARC	CH. BEARING	CH. DIST.
C1	23°44'48"	57.42'	23.80'	S75°22'31"E	23.63'

J:\2019\1097\DWG\04\SUBSHEETS\BOUNDARY\01\1087-VS-BNDY-01A.DWG plotted by PHILPOTT, ANDREW on 1/28/2020 8:06:20 AM last saved by PHILPOTT on 1/28/2020 8:08:32 AM
 Xrefs.