PROPERTY SPLIT SURVEY

PART OF QUARTER TOWNSHIP 1, TOWNSHIP 1, RANGE 18, UNITED STATES MILITARY DISTRICT

CITY OF COLUMBUS, FRANKLIN COUNTY, OHIO

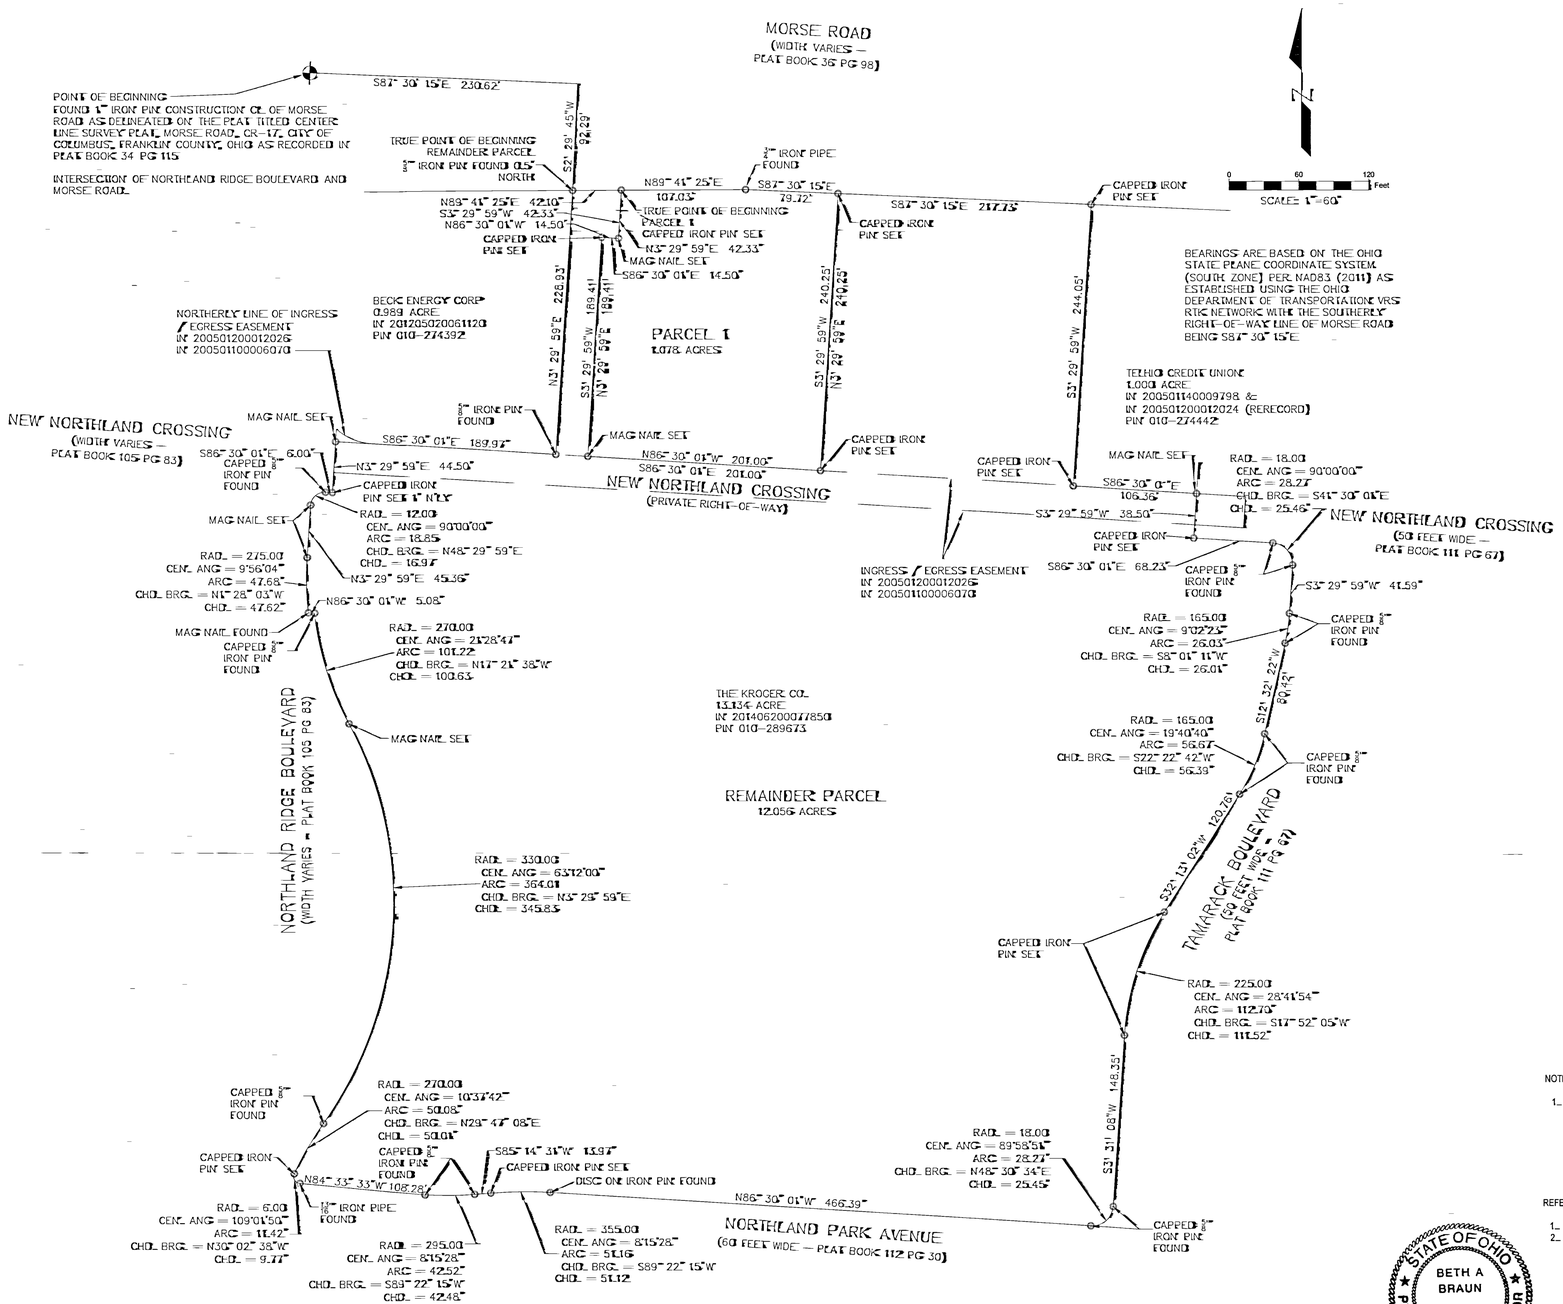

NOTE:

1. SET IRON PINS, WHERE INDICATED, ARE 5/8" REBAR WITH PLASTIC CAP PLACED ON TOP BEARING MSG.

REFERENCE DOCUMENTS:

1. DEED RECORDED ON JUNE 20, 2014 IN INSTRUMENT 201406200077850
2. FIDELITY NATIONAL TITLE INSURANCE COMPANY COMMITMENT NO. GLW1900766

STATE OF OHIO
BETH A BRAUN
8444
REGISTERED
PROFESSIONAL SURVEYOR

Beth A Braun 3/25/2020

BETH A BRAUN, PS
PROFESSIONAL SURVEYOR
OHIO LICENSE #8444
DATE OF SURVEY: OCTOBER 23, 2019;
REVISED NOVEMBER 6, 2019; FEBRUARY 26, 2020;
MARCH 24, 2020; MARCH 25, 2020

RECEIVED
JUN 03 2020
Franklin County Engineer
Connell K. Robertson, P.E., P.S.

NO.	DATE	BY	DESCRIPTION

2365 HAGGERTY ROAD SOUTH
CANTON, MI 48188
TEL: 734-397-3100
FAX: 734-397-3131

PROJECT DATE: 11/01/2019
PROJECT NO.: A3080002
DRAWN BY: JMA
CHECKED BY: BAB

TECHNICAL SKILL. CREATIVE SPIRIT.
Mannik Smith GROUP
www.MannikSmithGroup.com

PREPARED FOR:
AUTOZONE
STORE #6089

1745 MORSE ROAD
COLUMBUS, OHIO 43329
STORE #6089

PROPERTY SPLIT
DRAWING

1 / 1