EXHIBIT - A (Pg 2/2)

EMHT

Evans, Mechwart, Hambleton & Tilton, Inc.
Engineers • Surveyors • Planners • Scientists
5500 New Albany Road, Columbus, OH 43054
Phone: 614.775.4500 Toll Free: 888.775.3648
emht.com

# SURVEY OF ACREAGE PARCEL

**SECTION 15, QUARTER TOWNSHIP 2, TOWNSHIP 2, RANGE 16**
**UNITED STATES MILITARY DISTRICT**
**CITY OF COLUMBUS, COUNTY OF FRANKLIN, STATE OF OHIO**

| Date: March 9, 2020 | Job No: 2020-0269 | Scale: 1" = 40' |
|---|---|---|

SURVEY NOTE:
This survey was prepared using documents of record, prior plats of survey, and observed evidence located by an actual field survey.

PRELIMINARY APPROVAL
Cornell R. Robertson P.E., P.S.
BY: jwiggins
09/30/2020
PENDING ORIGINALS
*Submitted via digital Sealed
Please return this approval along with the original descriptions and plat of survey, as prepared by the surveyor, signed, sealed and dated in blue ink

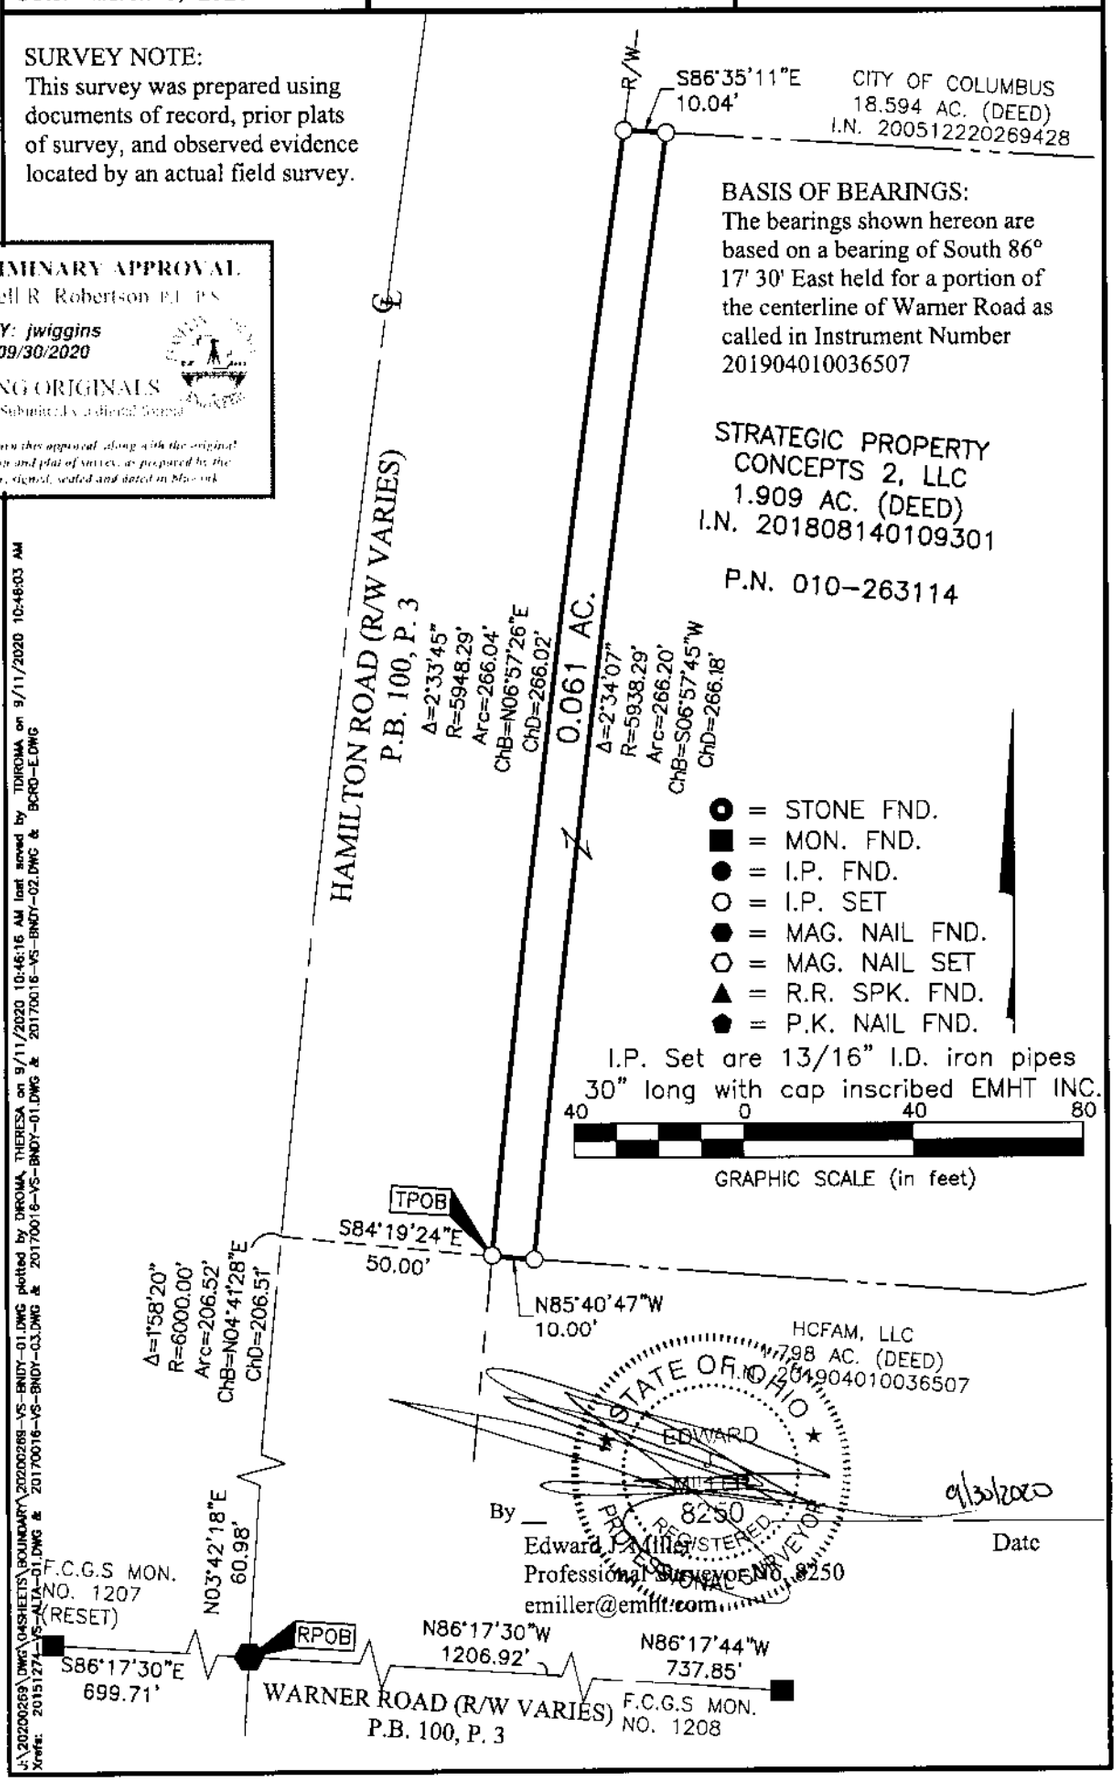


J:\2020269\DWG\04SHEETS\BOUNDARY\2020269-VS-BNDY-01.DWG plotted by DIROMA, THERESA on 9/11/2020 10:46:16 AM last saved by TDIROMA on 9/11/2020 10:46:03 AM
Xrefs: 2015127A-VS-ALTA-01.DWG & 20170016-VS-BNDY-01.DWG & 20170016-VS-BNDY-02.DWG & BCRO-E.DWG
BCRO-C3.DWG & 20170016-VS-BNDY-03.DWG & 20170016-VS-BNDY-04.DWG