B-6-A

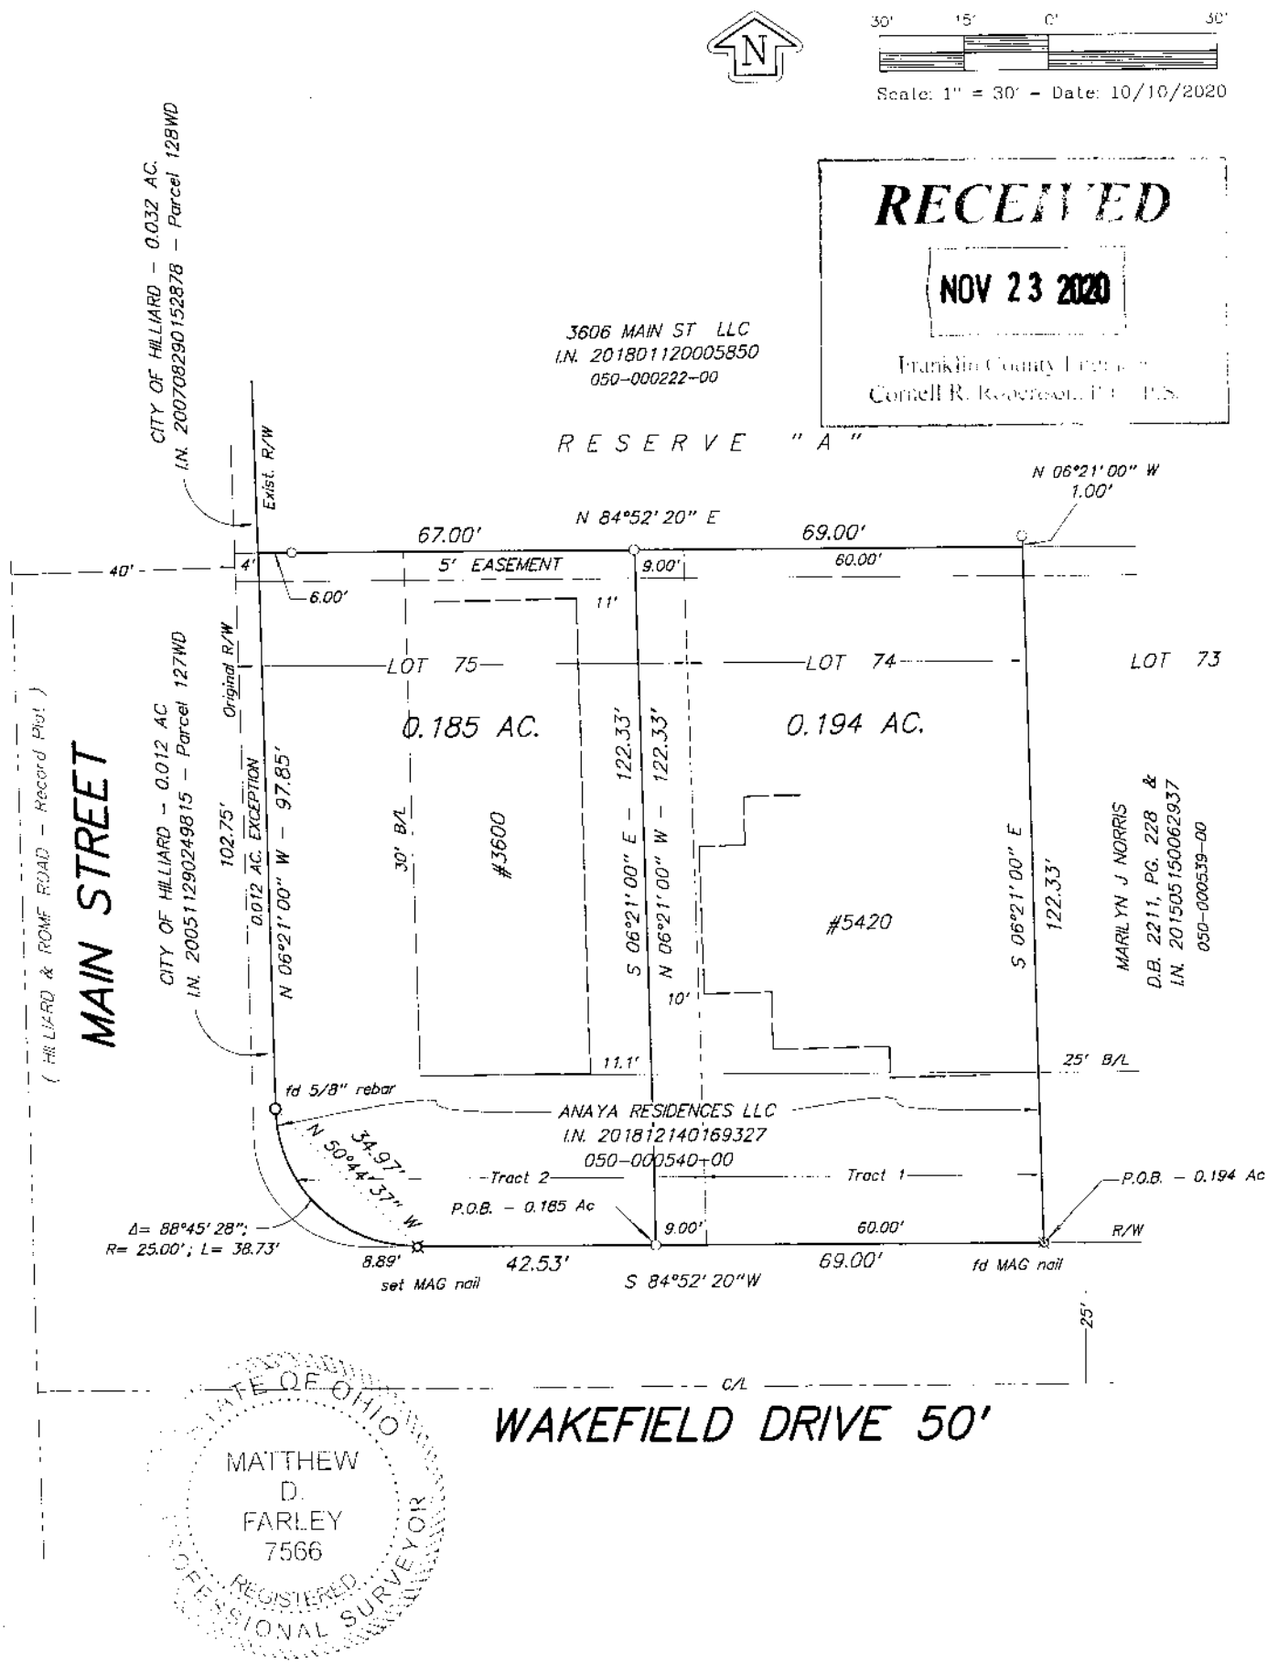

RECEIVED
NOV 23 2020
Franklin County Engineer
Cornell R. Robertson, P.E., P.S.

Bearings are based on the north line of Wakefield Drive as North 84°52' 20" East.

Boundary Survey

LOT 74 & PART OF LOT 75

CONSTANCE L CONKLIN SUBDIVISION
(PLAT BOOK 26, PAGE 45)
CITY OF HILLIARD, FRANKLIN CO, OHIO.

I hereby certify to:

FA CONSTRUCTION

that the foregoing Boundary Survey was prepared from actual field measurements in accordance with Chapter 4733-37, Ohio Administrative Code. Iron pins set are 30" X 5/8" rebar with an orange cap inscribed "FARLEY P.S. 7566".

11/22/20
Matthew D. Farley, Professional Surveyor No. 7566.

Matthew D. Farley, P.S.
52 North High Street
Canal Winchester, Ohio, 43110
(614) 404 7566
mfarley@woonway.com