Myers Surveying Company, Inc.

2740 East Main Street, Columbus 43209 (Bexley), Ohio
614-235-8677 FAX:614-235-4559

A Boundary Survey prepared for and certified to:

Edward & Lori Sarkel

Legal Description: Situated in The State of Ohio, County of Franklin, City of Hilliard, Being 0.399 Acres in V.M.S. #1406 as Conveyed To Edward A. Sarkel & Lori A. Sarkel in I.N. 200409030208159

Applicant:

Posted Address: 4734 River Run Drive, Hilliard, Ohio

RECEIVED
DEC 04 2020
Franklin County Engineer
Consultant Inspection, P.E., P.S.

40' 20' 0' 40'

Scale 1" = 40'
Date: 11/20/2020

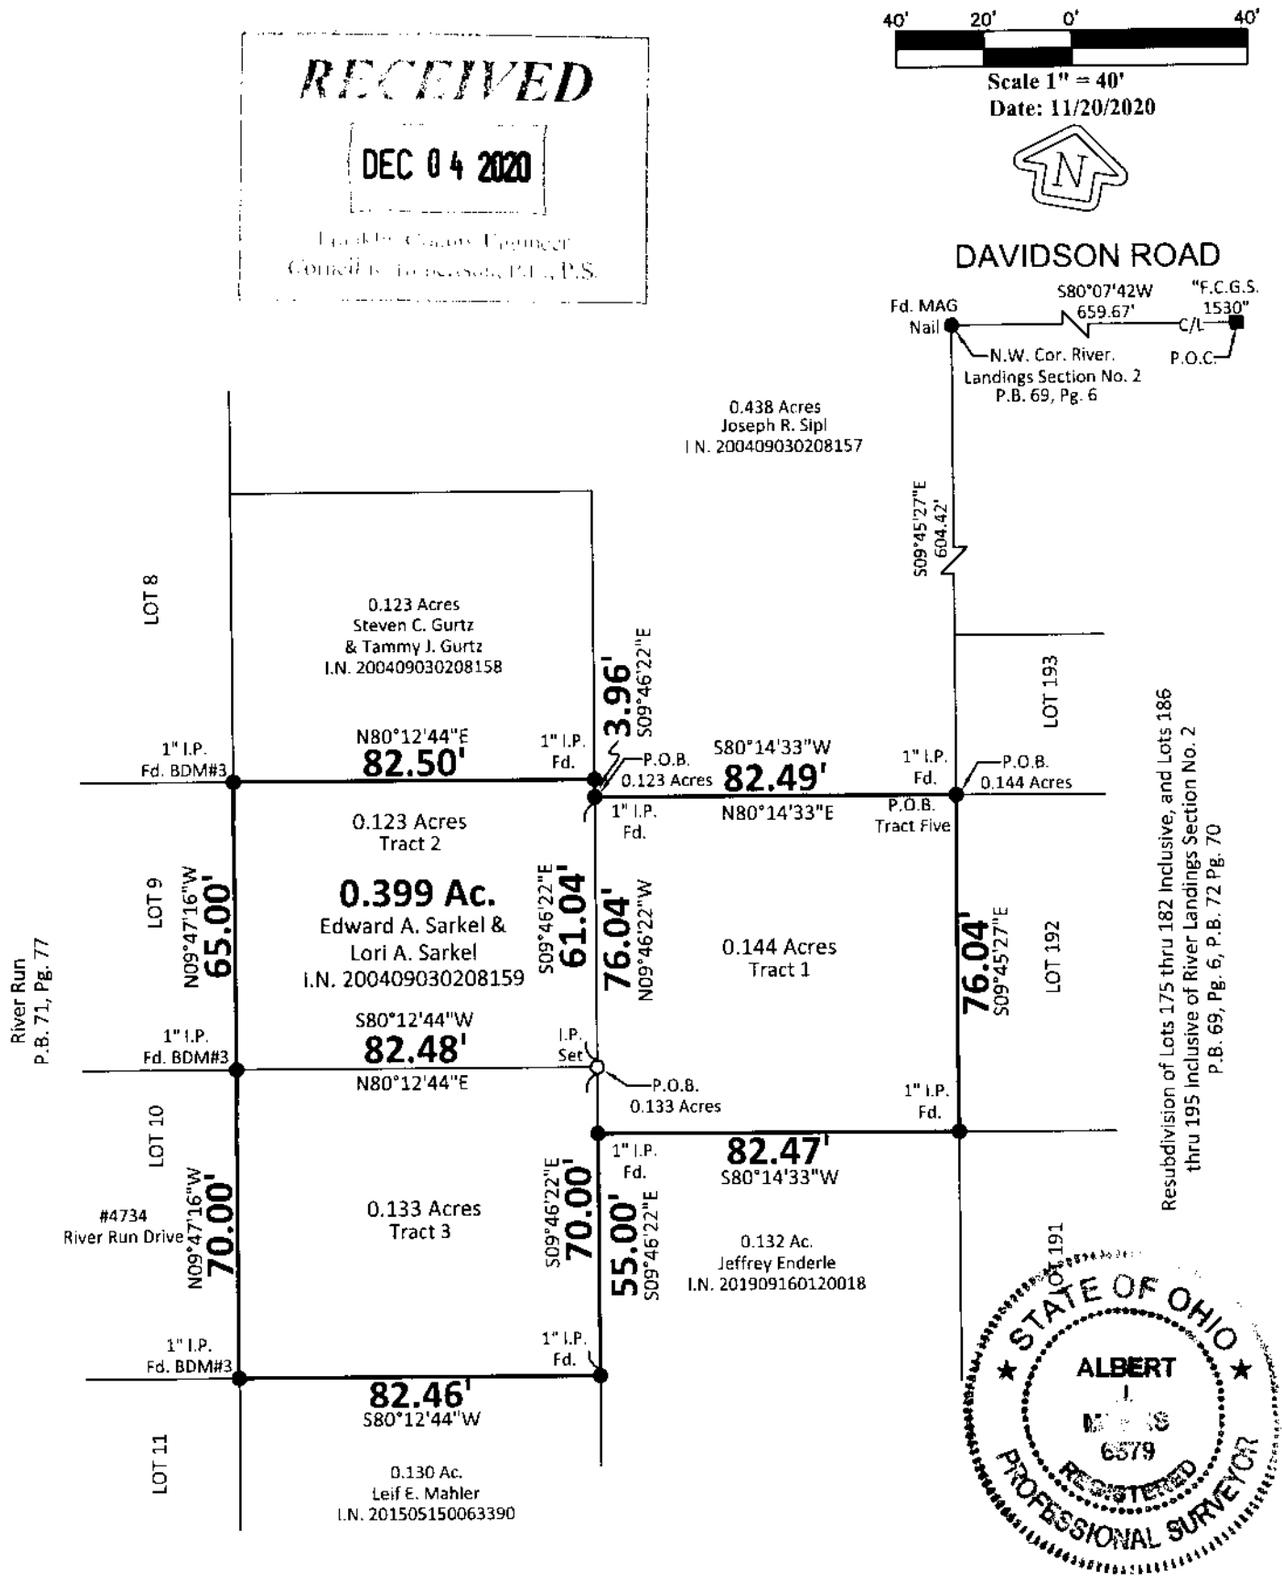

STATE OF OHIO ★ ALBERT I. MYERS 6579 REGISTERED PROFESSIONAL SURVEYOR ★

Myers Surveying Co., Inc

By _____ 12-1-20
Professional Surveyor

We hereby certify that the foregoing Boundary Survey was prepared from actual field measurements in accordance with Chapter 4733-37 Ohio Administrative Code. Iron pipes set are 30"x1" O.D. with an orange plastic plug inscribed "MYERS P.S. 6579", unless otherwise noted. Basis of bearings is S80°07'42"W on the centerline of Davidson Road per Fra-Davidson Road Right of Way Plans filed in the Franklin County Engineer's Office dated 1997.

Myers Order No.-6-10/19/2020	Rec.	Field	DWG.	Ltr.	Ck.