Myers Surveying Company, Inc.

2740 East Main Street, Columbus 43209 (Bexley), Ohio
614-235-8677 FAX:614-235-4559

A Boundary Survey prepared for and certified to:

Shiloh Grove Limited Partnership

Legal Description: Situated in The State of Ohio, County of Franklin, City of Columbus, Being Part of Disposal Parcels 3 and 4 of Mt. Vernon Plaza Urban Renewal Plat, as said Plat is recorded in Plat Book 50, Pages 70 and 71, Recorder's Office, Franklin County, Ohio.

Applicant:

Posted Address: 1035 Atcheson Street and 307-309 Twentieth Street, Columbus, Ohio

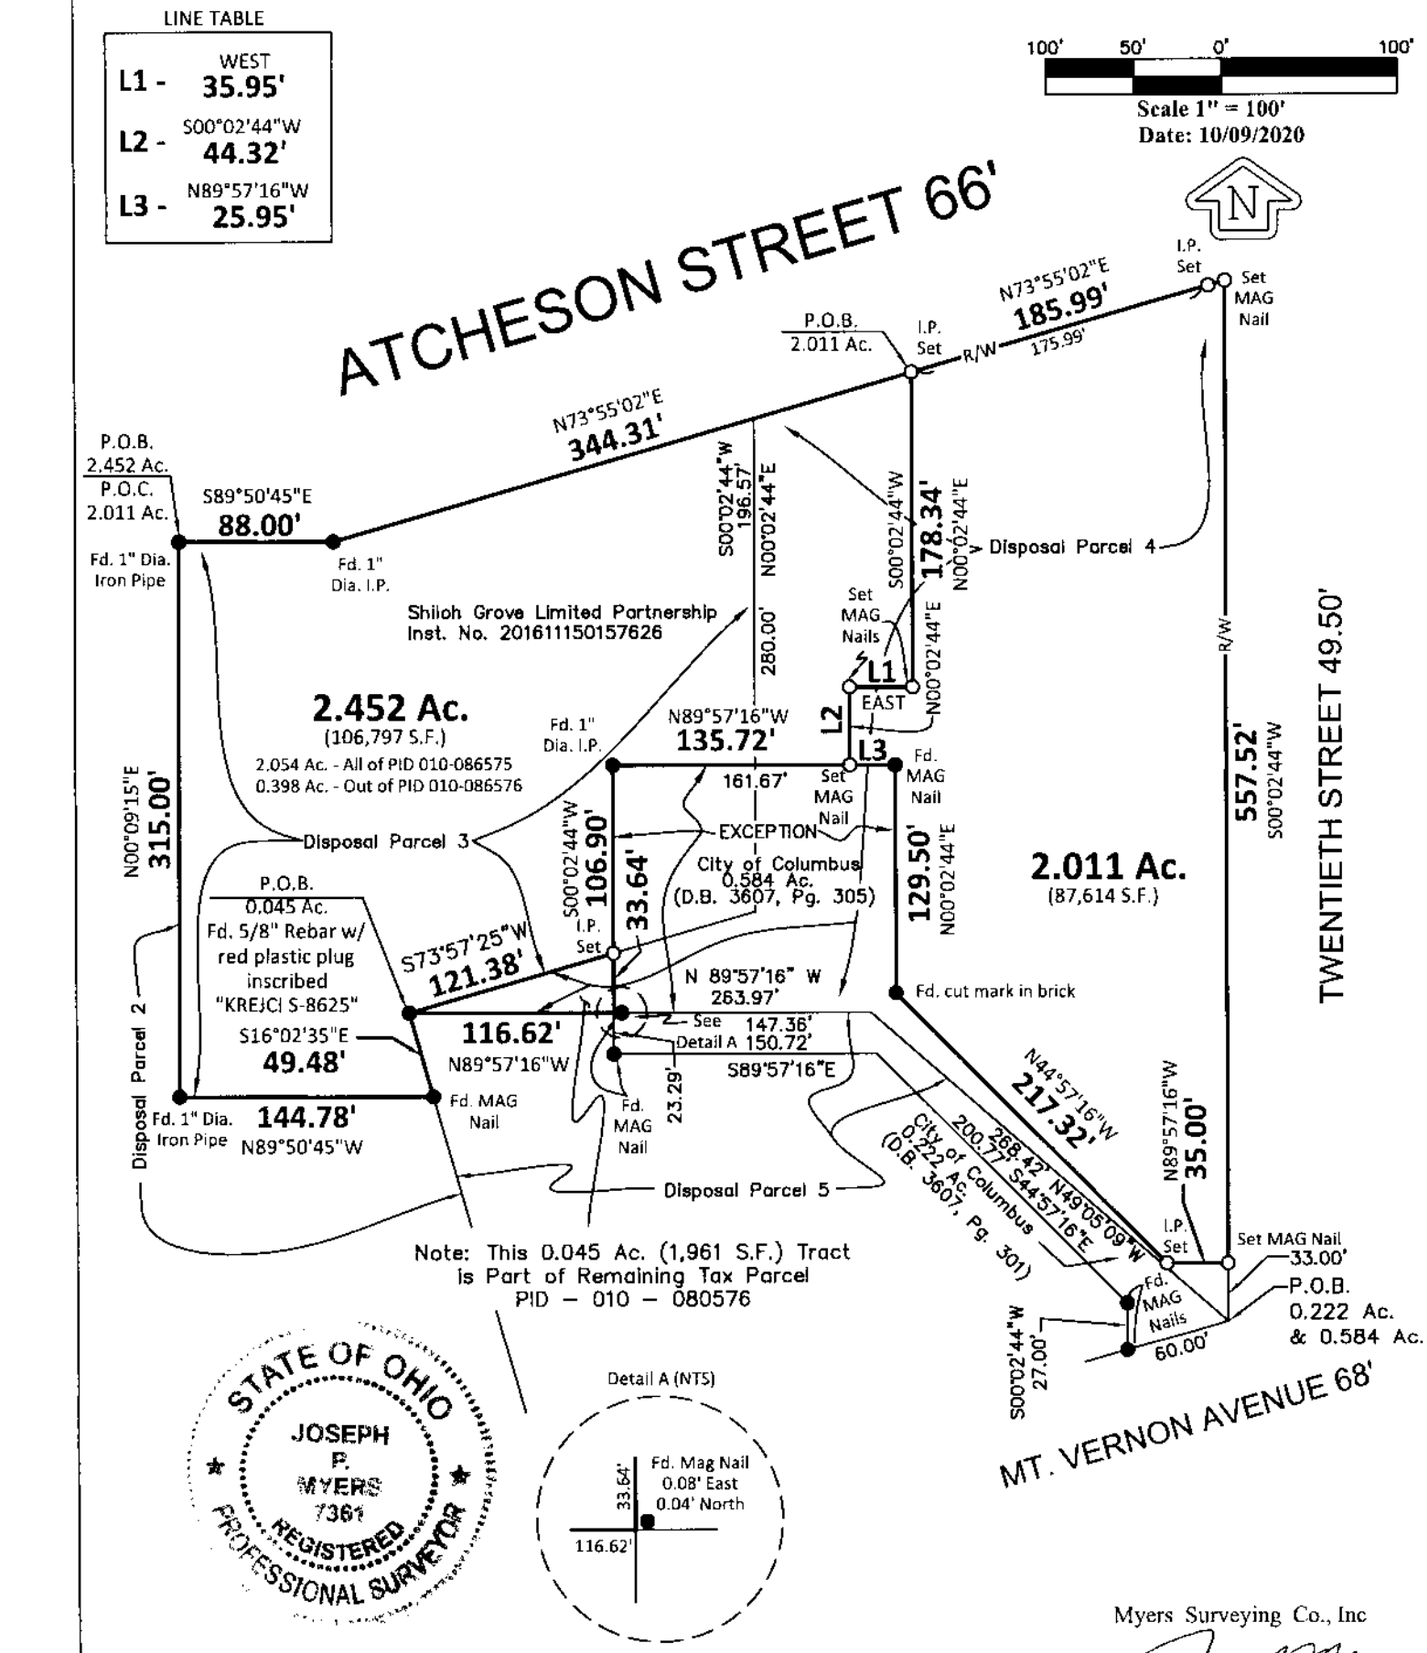

STATE OF OHIO
JOSEPH P. MYERS 7361
REGISTERED PROFESSIONAL SURVEYOR

Myers Surveying Co., Inc

By _____ 10/09/2020

Professional Surveyor

We hereby certify that the foregoing Boundary Survey was prepared from actual field measurements in accordance with Chapter 4733-37 Ohio Administrative Code. Iron pipes set are 30"x1" O.D. with an orange plastic plug inscribed "MYERS P.S. 6579", unless otherwise noted. Basis of bearings is the west line of N. Twentieth St. held as S 00°02'44" W per P.B. 50, Pg. 70.

Myers Order No.-8-07/22/2020	Rec.	Field	DWG.	Ltr.	Ck.