C-021

Myers Surveying Company, Inc.

2740 East Main Street, Columbus 43209 (Bexley), Ohio
614-235-8677 FAX:614-235-4559

A Boundary Survey prepared for and certified to:

Home Team Properties and/or 1444 N High LLC

Legal Description: Situated in The State of Ohio, County of Franklin, City of Columbus, Being Part of Lots 16 & 17 of Phil D. Fisher and Mrs. M.C. Millers Subdivision, Plat Book 3, Page 69

Applicant: 1444 N High LLC

Posted Address: 1444 N. High Street, Columbus, Ohio

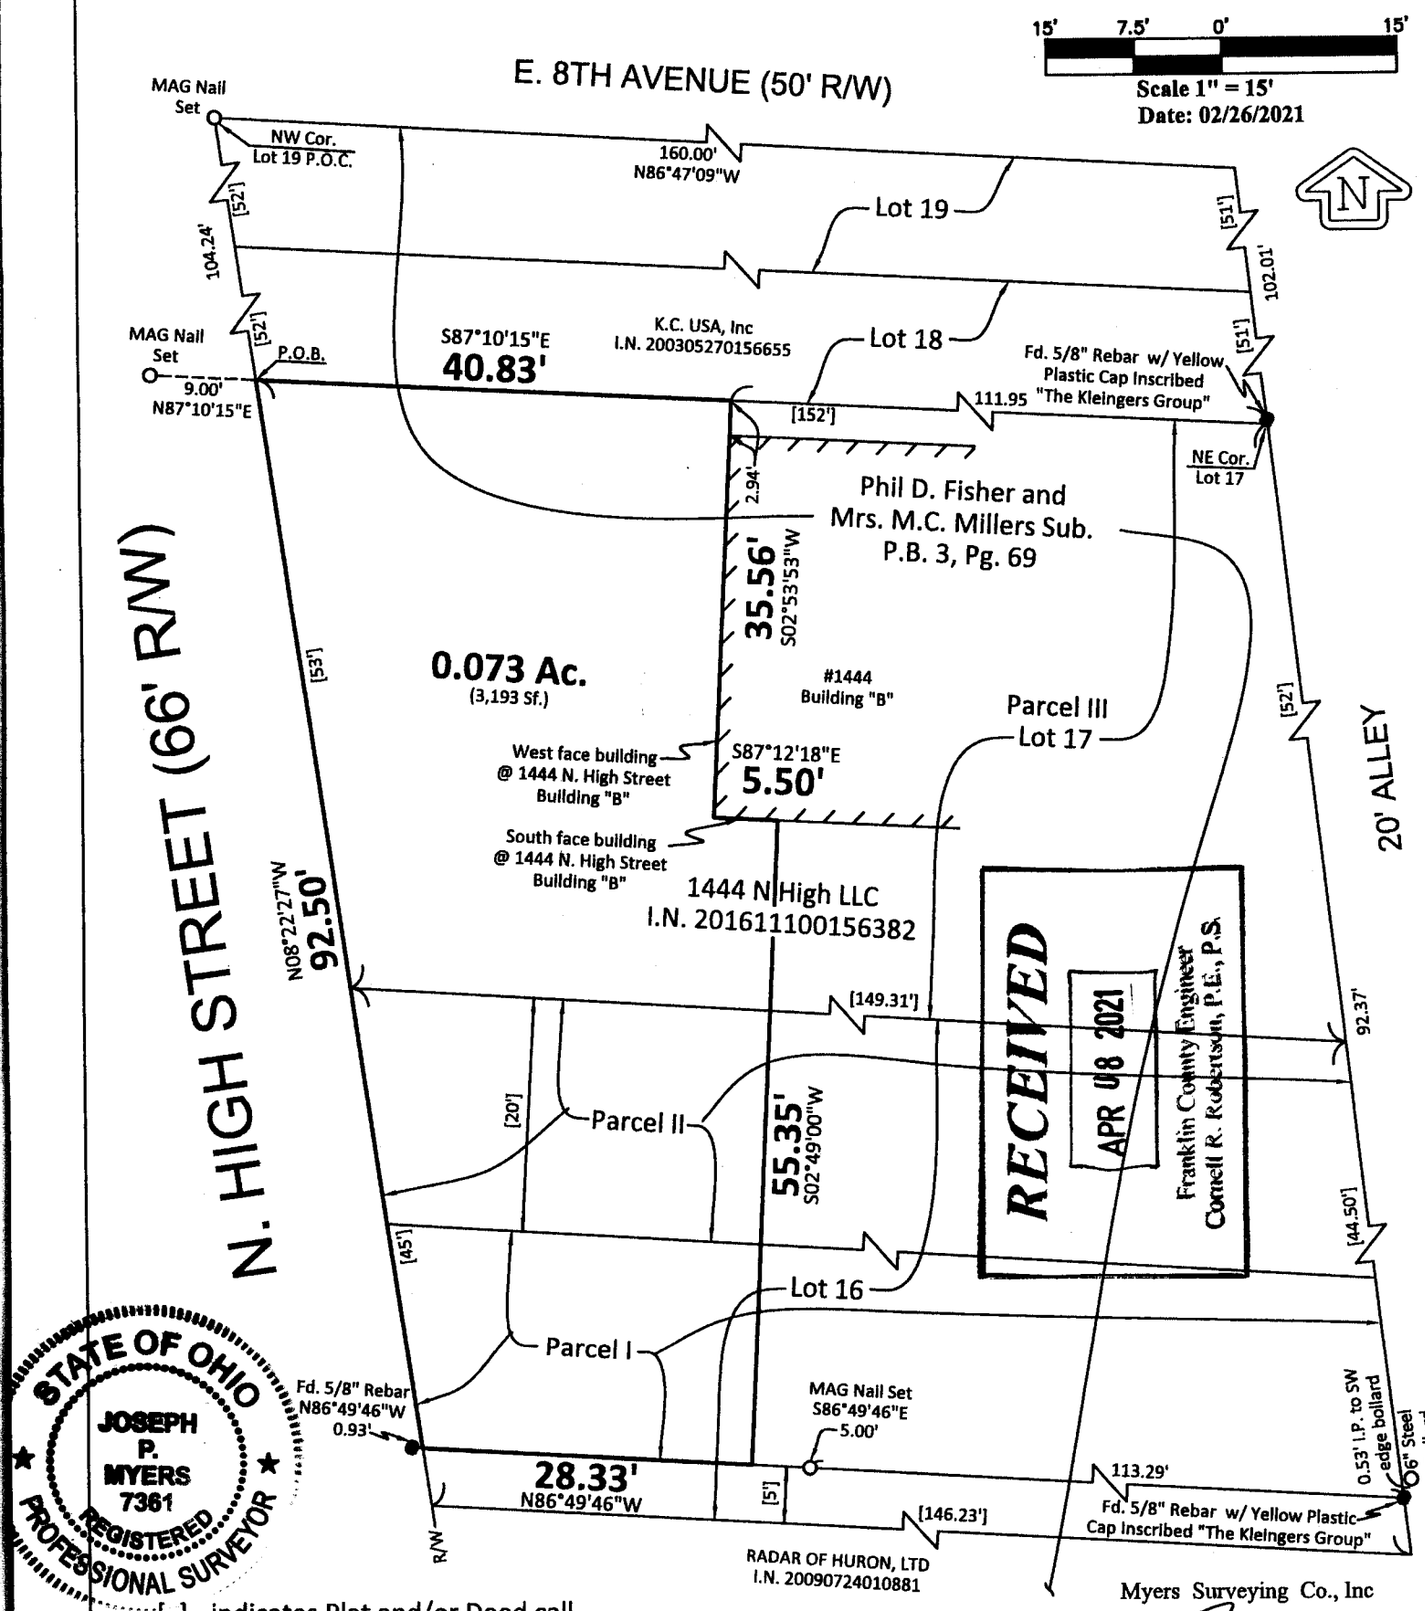

RECEIVED
APR 08 2021
Franklin County Engineer
Connell R. Robertson, P.E., P.S.

STATE OF OHIO
JOSEPH P. MYERS 7361
REGISTERED PROFESSIONAL SURVEYOR

[ ] - indicates Plat and/or Deed call

We hereby certify that the foregoing Boundary Survey was prepared from actual field measurements in accordance with Chapter 4733-37 Ohio Administrative Code. Iron pipes set are 30"x1" O.D. with an orange plastic plug inscribed "MYERS P.S. 6579", unless otherwise noted. Basis of bearings is the north line of E. Eighth Avenue held as N86°47'09"W per Plat Book 118, Page 56.

Myers Surveying Co., Inc

By _____ 2/26/2021

Professional Surveyor

Myers Order No.-31-02/04/2021	Rec.	Field	DWG.	Ltr.	Ck.