

0-108-A



SURVEY OF ACREAGE PARCEL

VIRGINIA MILITARY SURVEY NO. 3004
CITY OF DUBLIN, COUNTY OF FRANKLIN, STATE OF OHIO

Date:	March 19, 2021
Scale:	1" = 50'
Job No:	2021-0039
Sheet No:	1 of 1

RECEIVED


MAR 30 2021

Franklin County Engineer
Cornell R. Robertson, P.E., P.S.


BASIS OF BEARINGS:
The Bearings shown hereon are based on the Ohio State Plane Coordinate System South Zone, NAD83 (1986 Adjustment). Control for bearings was from coordinates of monuments FCGS 5536 and FCGS 7752, as established by the Franklin County Engineering Department, and located using Global Positioning System procedures and equipment, resulting in a bearing of North 04° 10' 56" West for a portion of the centerline of Avery Road.

SURVEY NOTE:
This survey was prepared using documents of record, prior plats of survey, and observed evidence located by an actual field survey.

- = MON. FND.
- = 5/8" REBAR "ASI PS7819" UNLESS OTHERWISE NOTED
- = I.P. SET
- I.P. Set are 13/16" I.D. iron pipes 30" long with cap inscribed EMHT INC.

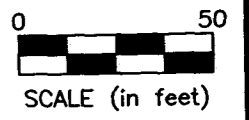

By Heather L. King Date 3/24/21
Heather L. King
Professional Surveyor No. 8307
hking@emht.com

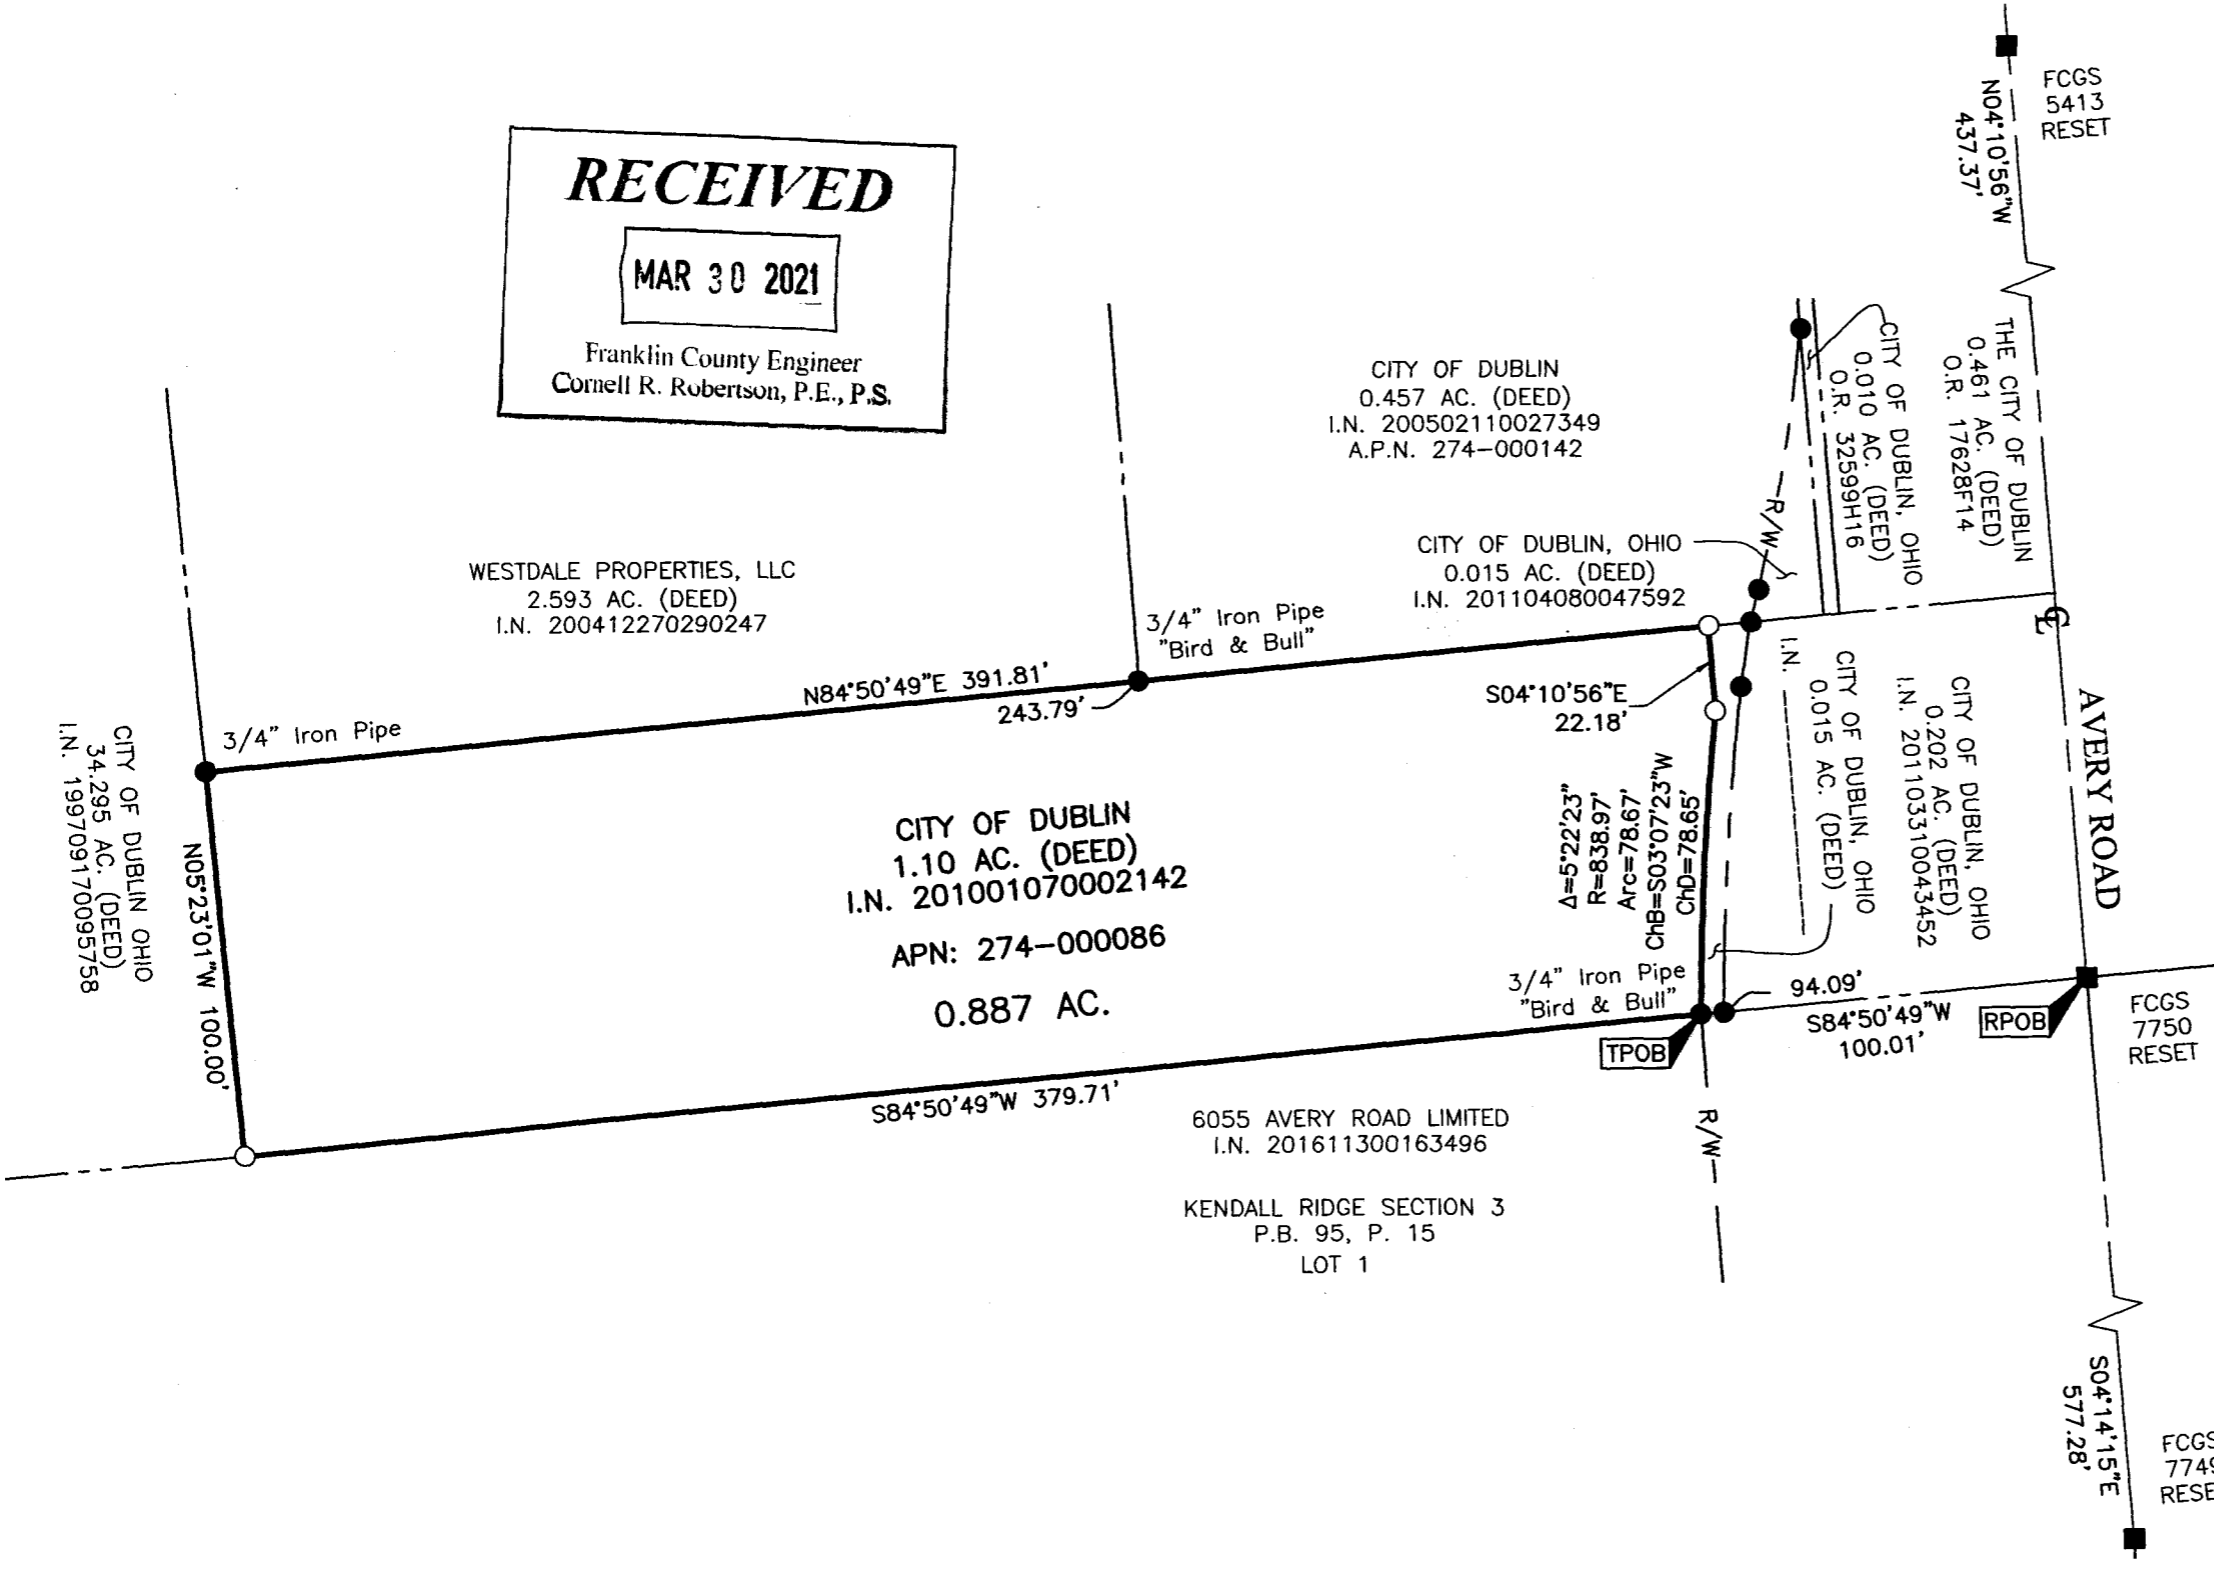

J:\20210039\DWG\04-SHEETS\BOUNDARY\20210039-VS-BNDY-04.DWG plotted by KING, HEATHER on 3/24/2021 8:51:53 AM last saved by KING on 3/23/2021 4:42:18 PM