

- LEGEND**
- IRON PIN FND.
 - ⊙ IRON PIPE FND.
 - ⊗ RR SPIKE FND.
 - MAG SPIKE SET
 - PK NAIL SET
 - IRON PIN SET (5/8" O.D. REBAR 30" LONG W/CAP "LOMANO 7711")


BASIS OF BEARINGS
 Bearings hereon are referenced to N15°39'52"W for the centerline of State St., SPCS grid, OH S. Zone, per a VRS GPS survey, NAD83 datum, 2011 adjustment.

- L1: N74°20'08"E 40.00'
- L2: S85°59'42"E 5.31'
- L3: N86°38'52"W 5.29'
- L4: N3°21'08"E 15.83'
- L5: S3°16'56"W 35.67'
- L6: S15°39'52"E 34.29'
- L7: S3°16'56"W 25.00'
- L8: N5°48'39"W 15.06'
- L9: N15°39'52"W 20.19'

RECEIVED
 JUN 11 2021
 Franklin County Engineer
 Cornell R. Robertson
 0101 PS

SCALE: 1"=50'

BOUNDARY SURVEY/SPLIT
 QTR. 2, TWP. 2, RNG. 17, U.S.M.L.
 WESTERVILLE, FRANKLIN CO., OHIO

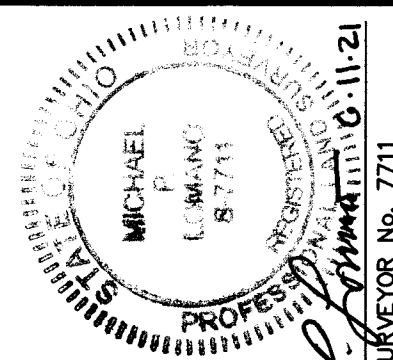

This plat is based on the results of an actual field survey performed on the property under my supervision in June, 2021.

DATE: 6/11/21
 JOB No.: 21-125
 CLIENT: CITY OF WESTERVILLE
 REVISION: F.B./PG.:
 CLIENT P.O.: P1014024

BY *Michael P. Lomano*
 OHIO PROFESSIONAL SURVEYOR No. 7711

WESTERVILLE
 LAND
 SURVEYING, LLC
 125 E. HOME ST. STE A
 WESTERVILLE, OH 43081
 (614) 899-2209
 DRAWING NAME: 211918S.DWG

BOUNDARY SURVEY
FORMER WESTERVILLE ARMORY
 240 S. STATE ST., WESTERVILLE, OHIO 43081