



Evans, Mechwart, Hambleton & Tilton, Inc.
 Engineers • Surveyors • Planners • Scientists
 5500 New Albany Road, Columbus, OH 43054
 Phone: 614.775.4500 Toll Free: 888.775.3648
 emht.com

SURVEY OF ACREAGE PARCEL


VIRGINIA MILITARY DISTRICT SURVEY NUMBER 1388

CITY OF GROVE CITY, COUNTY OF FRANKLIN, STATE OF OHIO

Date:	June 4, 2021
Scale:	1" = 50'
Job No:	2020-1288
Sheet No:	1 of 1

BASIS OF BEARINGS:

The bearings shown hereon are based on the Ohio State Plane Coordinate System, South Zone, NAD83 (CORS96). Said bearings originated from a field traverse which was tied (referenced) to said coordinate system by GPS observations and observations of selected CORS base stations in the National Spatial Reference System. The portion of the centerline of Demorest Road, between FCGS 1361 and FCGS 5131 having a bearing of North 03°10'25" East, is designated as the "basis of bearings" for this survey.

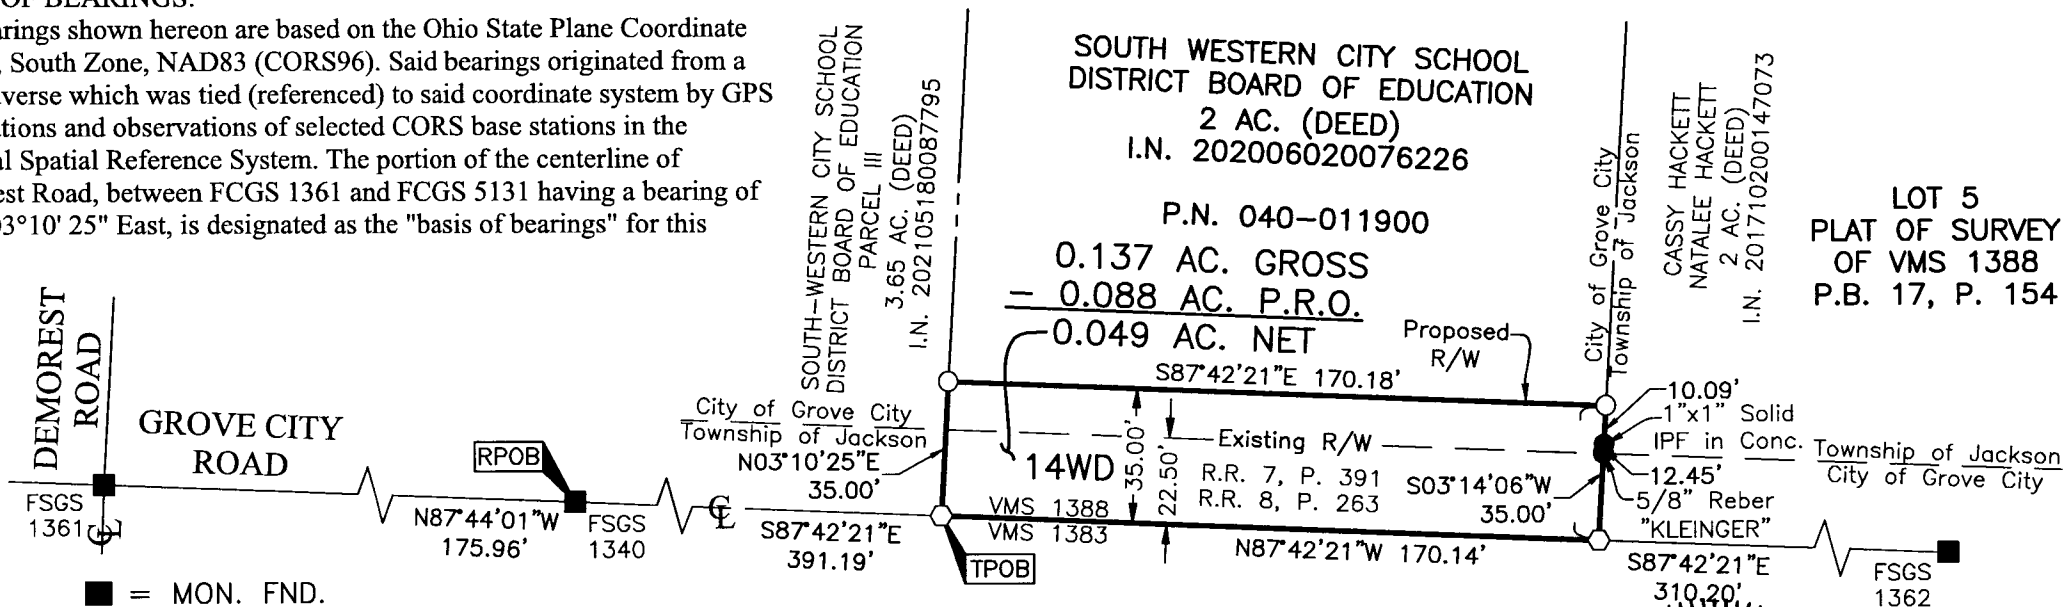

- = MON. FND.
- = I.P. FND.
- = I.P. SET
- = MAG. NAIL FND.
- ◇ = MAG. NAIL SET
- ▲ = R.R. SPK. FND.


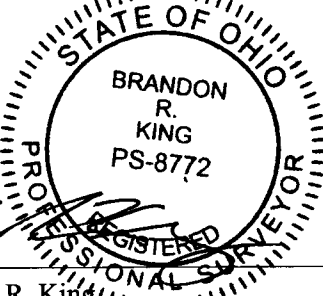
I.P. Set are 13/16" I.D. iron pipes 30" long with cap inscribed EMHT INC.



SCALE (in feet)

SURVEY NOTE:

This survey was prepared using documents of record, prior plats of survey, and observed evidence located by an actual field survey in October 2019, March 2021 and April 2021.

By  

Brandon R. King
 Professional Surveyor No. 8772
 bking@emht.com

Date 6-4-2021

RECEIVED

JUN 10 2021

Franklin County Engineer
 Corinell K. Robertson, P.E., P.S.