



Evans, Mechwart, Hambleton & Tilton, Inc.  
 Engineers • Surveyors • Planners • Scientists  
 5500 New Albany Road, Columbus, OH 43054  
 Phone: 614.775.4500 Toll Free: 888.775.3648

emht.com

# SURVEY OF ACREAGE PARCEL


VIRGINIA MILITARY DISTRICT SURVEY NUMBER 1383  
 TOWNSHIP OF JACKSON AND CITY OF GROVE CITY,  
 COUNTY OF FRANKLIN, STATE OF OHIO

Date: June 4, 2021

Scale: 1" = 50'

Job No: 2020-1288


Sheet No: 1 of

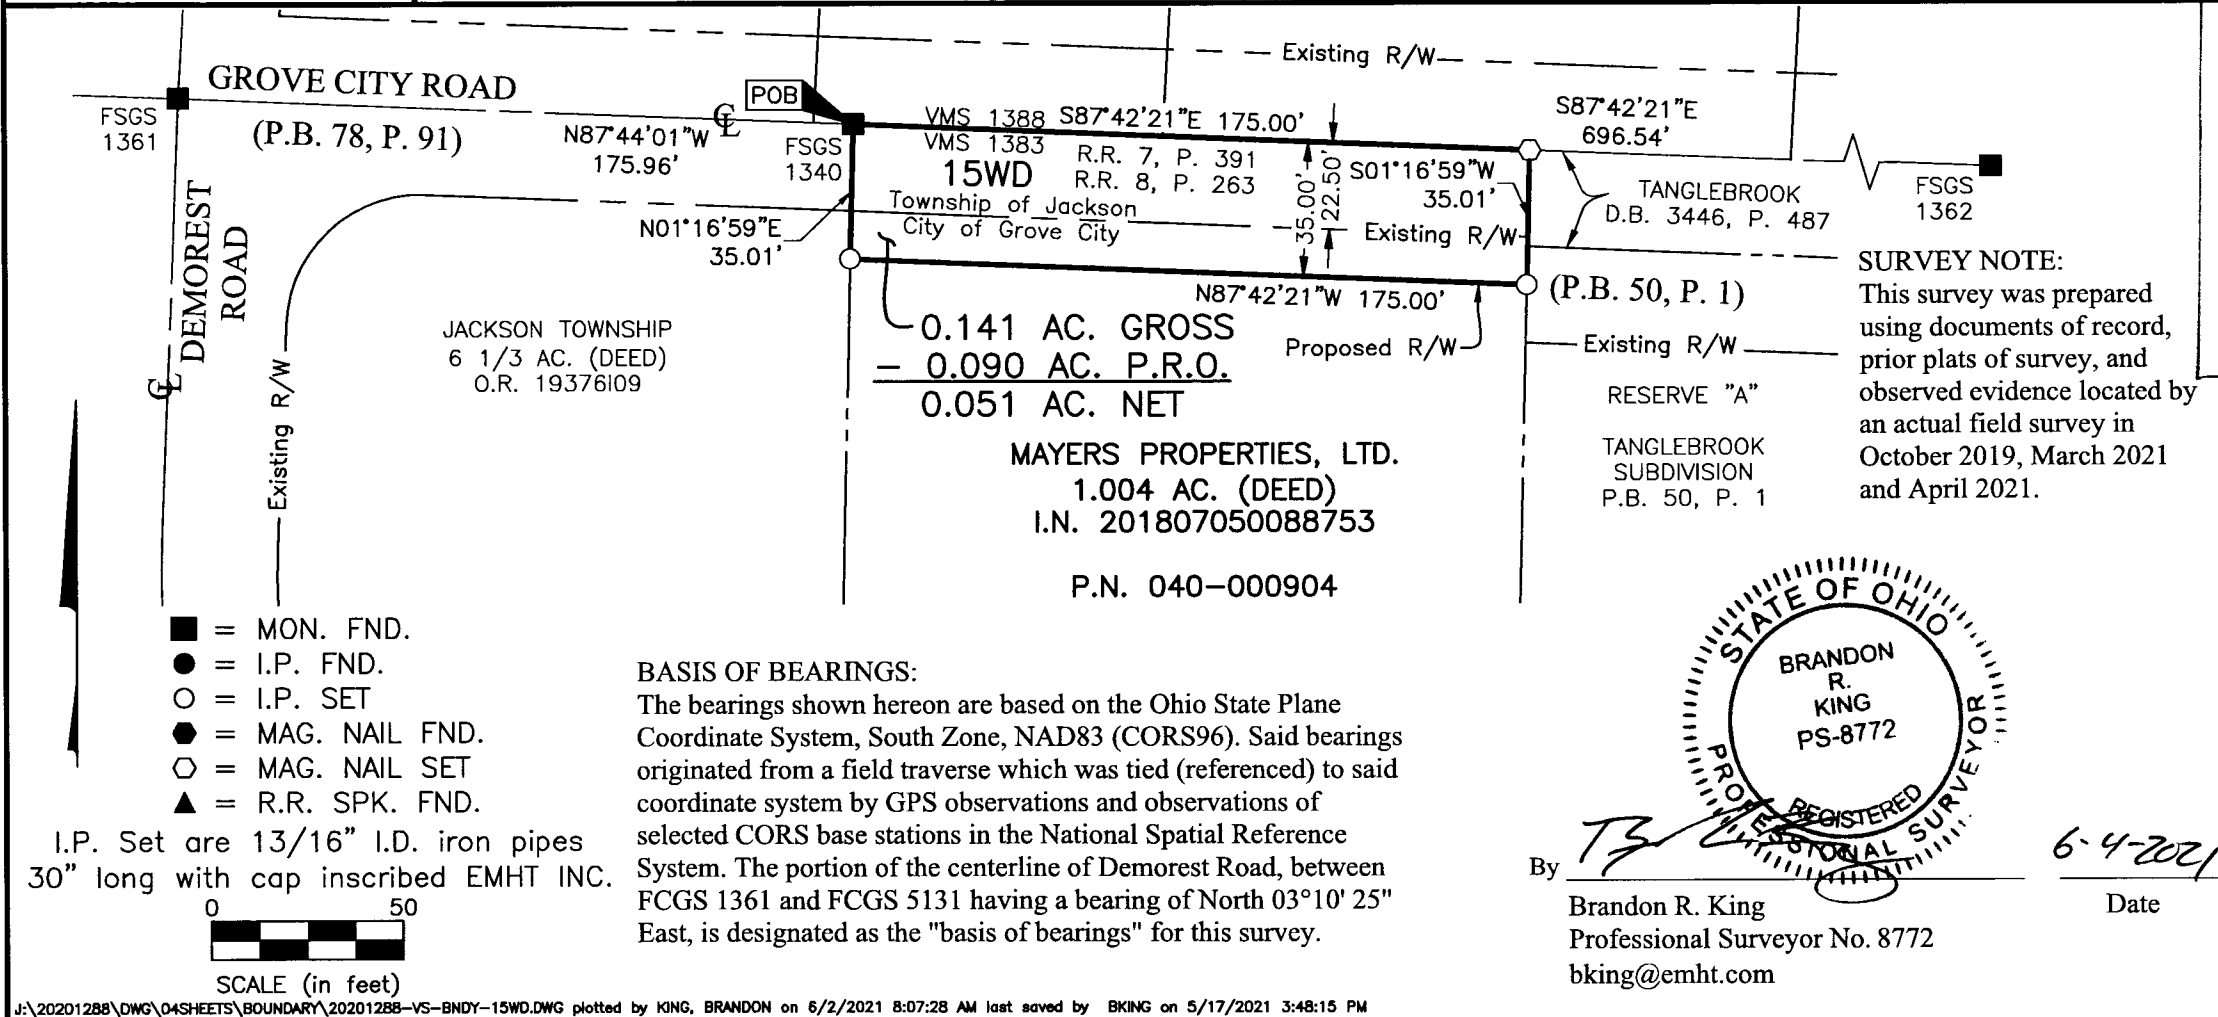


**SURVEY NOTE:**  
 This survey was prepared using documents of record, prior plats of survey, and observed evidence located by an actual field survey in October 2019, March 2021 and April 2021.

- = MON. FND.
- = I.P. FND.
- = I.P. SET
- = MAG. NAIL FND.
- = MAG. NAIL SET
- ▲ = R.R. SPK. FND.

I.P. Set are 13/16" I.D. iron pipes 30" long with cap inscribed EMHT INC.

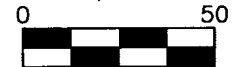

SCALE (in feet)

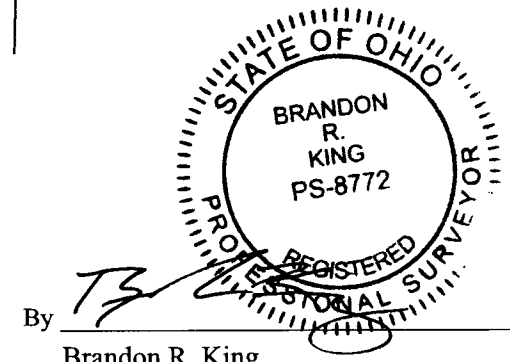

**RECEIVED**

JUN 10 2021

Franklin County Engineer  
 Cornell R. Robertson, P.L., P.S.