# SURVEY OF ACREAGE PARCEL

## FARM LOT 7, QUARTER TOWNSHIP 3, TOWNSHIP 2, RANGE 16
## UNITED STATES MILITARY DISTRICT
## CITY OF NEW ALBANY, COUNTY OF FRANKLIN, STATE OF OHIO

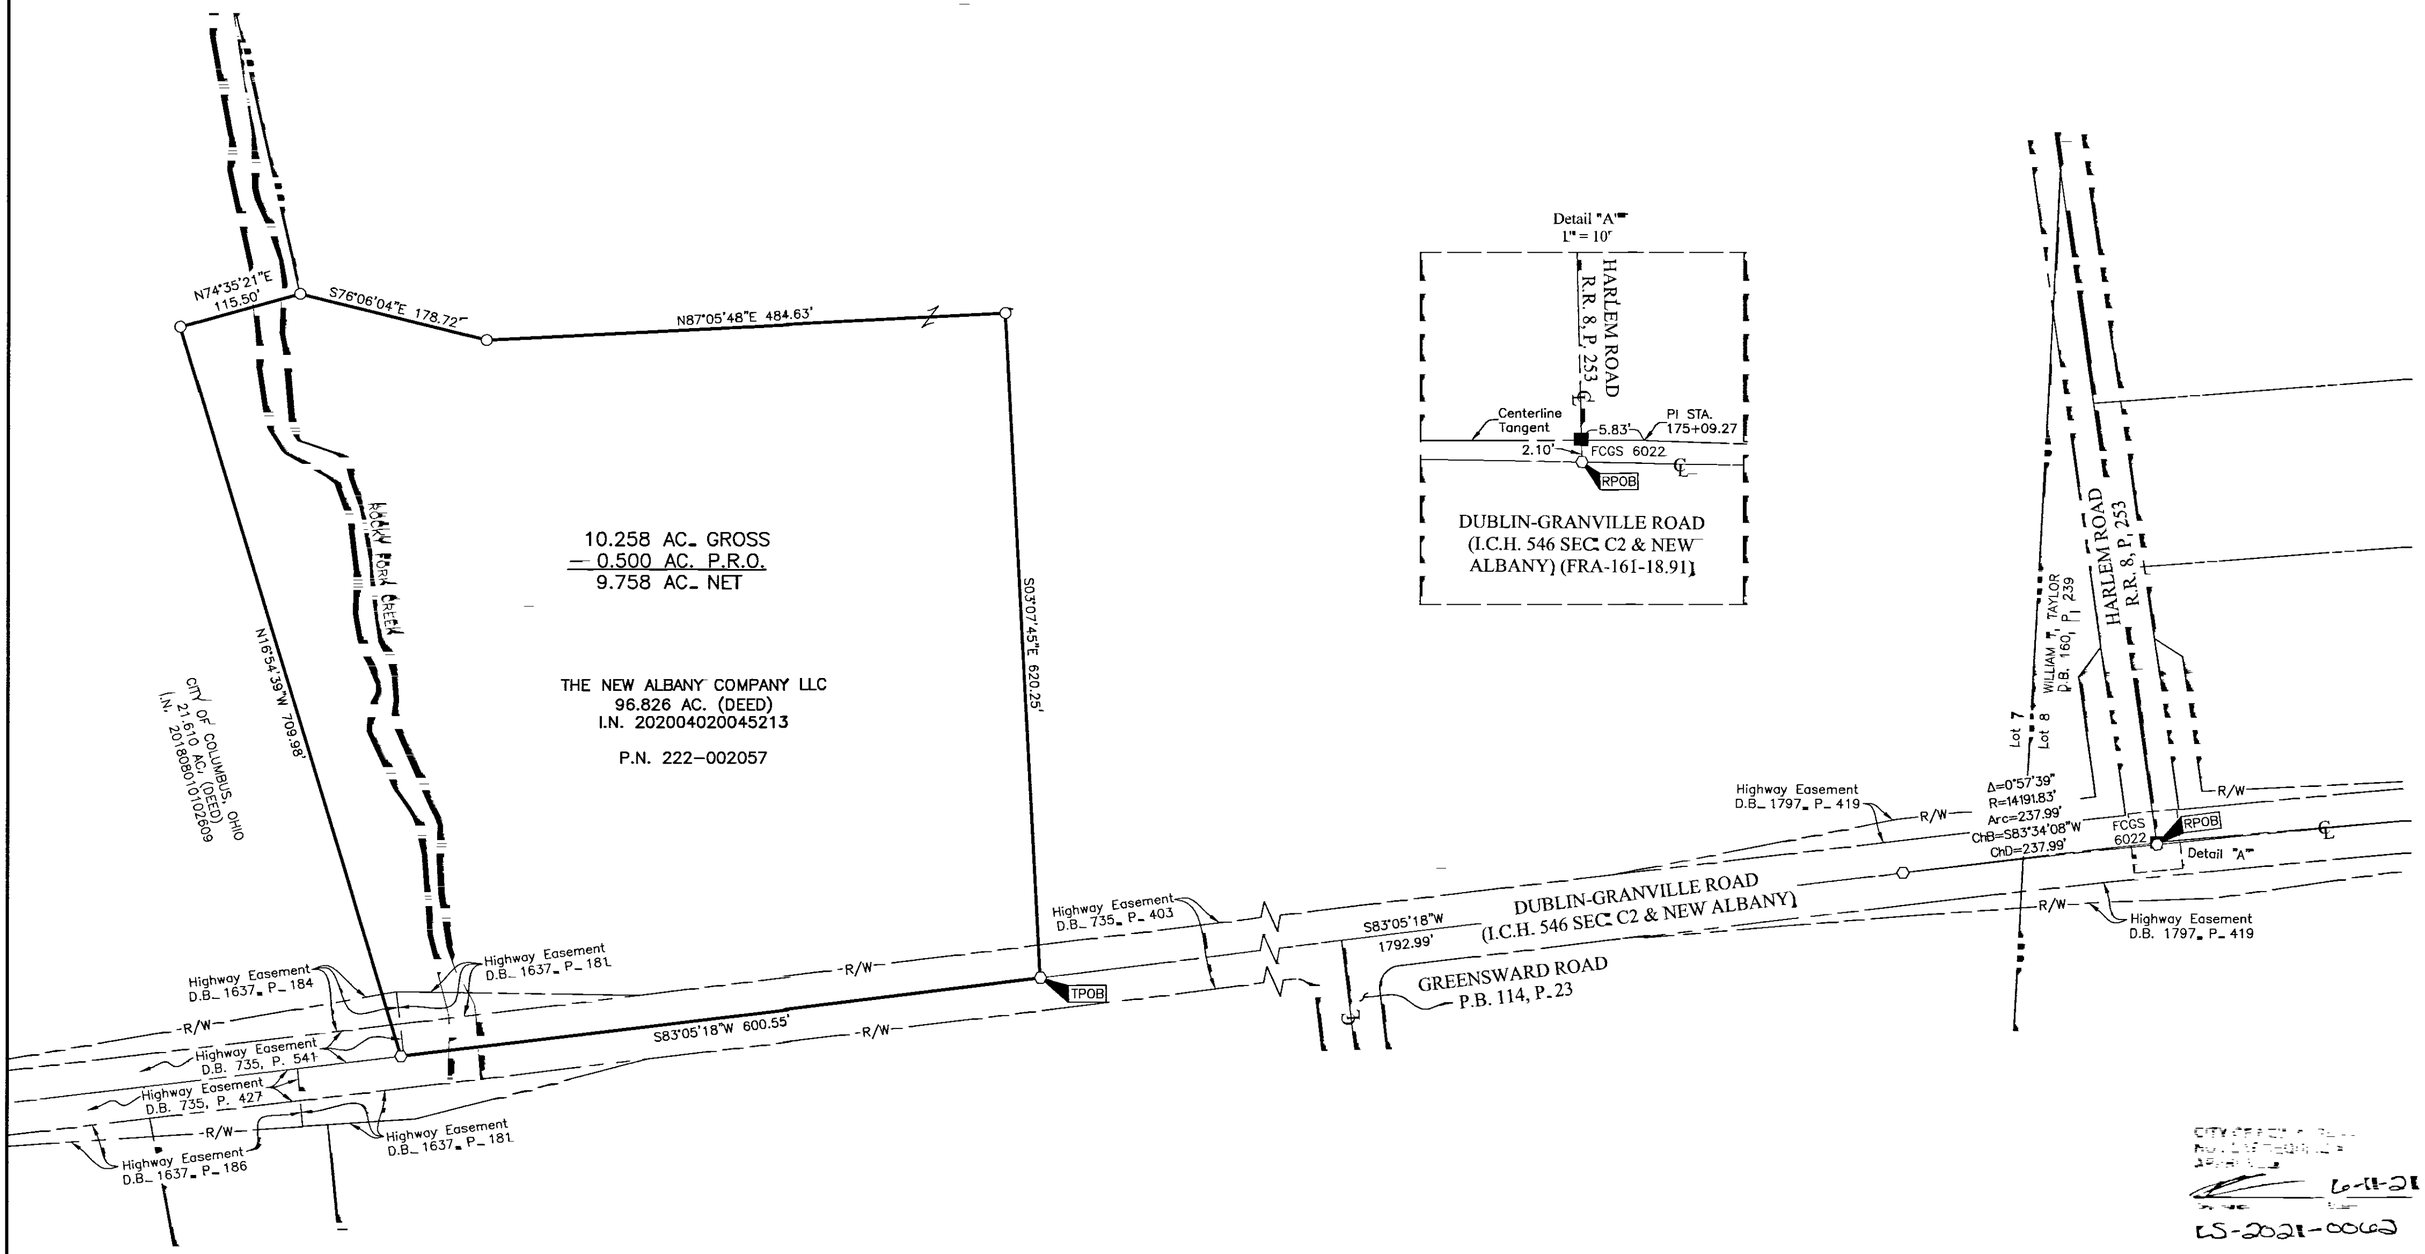


● = STONE FND.
■ = MON. FND.
● = I.P. FND.
○ = I.P. SET
⬢ = MAG. NAIL FND.
⬡ = MAG. NAIL SET
▲ = R.R. SPK FND.
⬟ = P.K. NAIL FND.

I.P. Set are 13/16" I.D. iron pipes 30" long with cap inscribed EMHT INC.

100 0 100 200
GRAPHIC SCALE (in feet)

BASIS OF BEARINGS:
The bearings shown hereon are based on the Ohio State Plane Coordinate System, South Zone, NAD83 (2007). Said bearings originated from a field traverse which was tied (referenced) to said coordinate system by GPS observations of Franklin County Engineering Department monuments FRANK 78, FCGS 8815, FCGS 8814, FCGS 8813, FCGS 6624 RESET and FCGS 6675. The portion of the centerline of Dublin-Granville Road, having a bearing of South 83° 05' 18" West and monumented as shown hereon, is designated as the "basis of bearings" for this survey.

SURVEY NOTE:
This survey was prepared using documents of record, prior plats of survey, and observed evidence located by an actual field survey.

STATE OF OHIO
HEATHER L. KING
S-8307
REGISTERED
PROFESSIONAL SURVEYOR

By Heather L. King 5/26/21
Heather L. King
Professional Surveyor No. 8307
hking@emht.com
Date

EMH&T
Evans, Mechwart, Hambleton & Tilton, Inc.
Engineers • Surveyors • Planners • Scientists
5500 New Albany Road, Columbus, OH 43054
Phone: 614.775.4500 Toll Free: 888.775.3648
emht.com

Date: May 25, 2021
Scale: 1" = 100'
Job No: 2021-0443
Sheet: 1 of 1

REVISIONS

| MARK | DATE | DESCRIPTION |
|---|---|---|
| | | |
| | | |
| | | |
| | | |
| | | |
| | | |

6-11-21
LS-2021-0062



\\CMHGATO1\PROJECTS\2021\0443\DWG\04SHEETS\BOUNDARY\20210443-VS-BNDY-01.DWG plotted by WEBB, TEAGUE on 6/1/2021 1:16:40 PM last saved by TWEBB on 6/1/2021 1:16:13 PM EDT