




State of Ohio, County of Franklin, City of Columbus
 Half Section 13, Section 10, Township 5, Range 22
 Refugee Lands

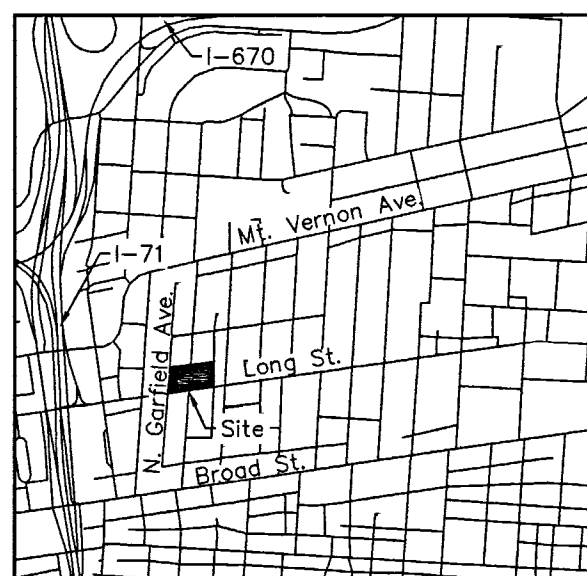

VICINITY MAP
 not to scale

BASIS OF BEARINGS

Bearings described hereon are based on South 81 degrees 56 minutes 24 seconds West for the north right-of-way line of Long Street, measured from Grid North, referenced to the Ohio State Plane Coordinate System (South Zone) and the North American Datum of 1983 (2011 Adjustment), as established utilizing a GPS survey referenced to the Ohio Department of Transportation's VRS Network.

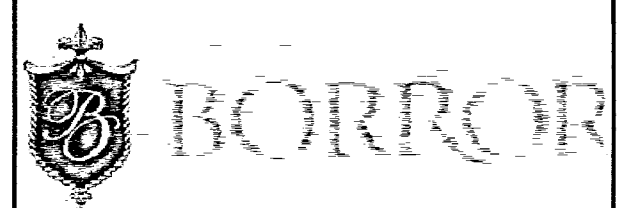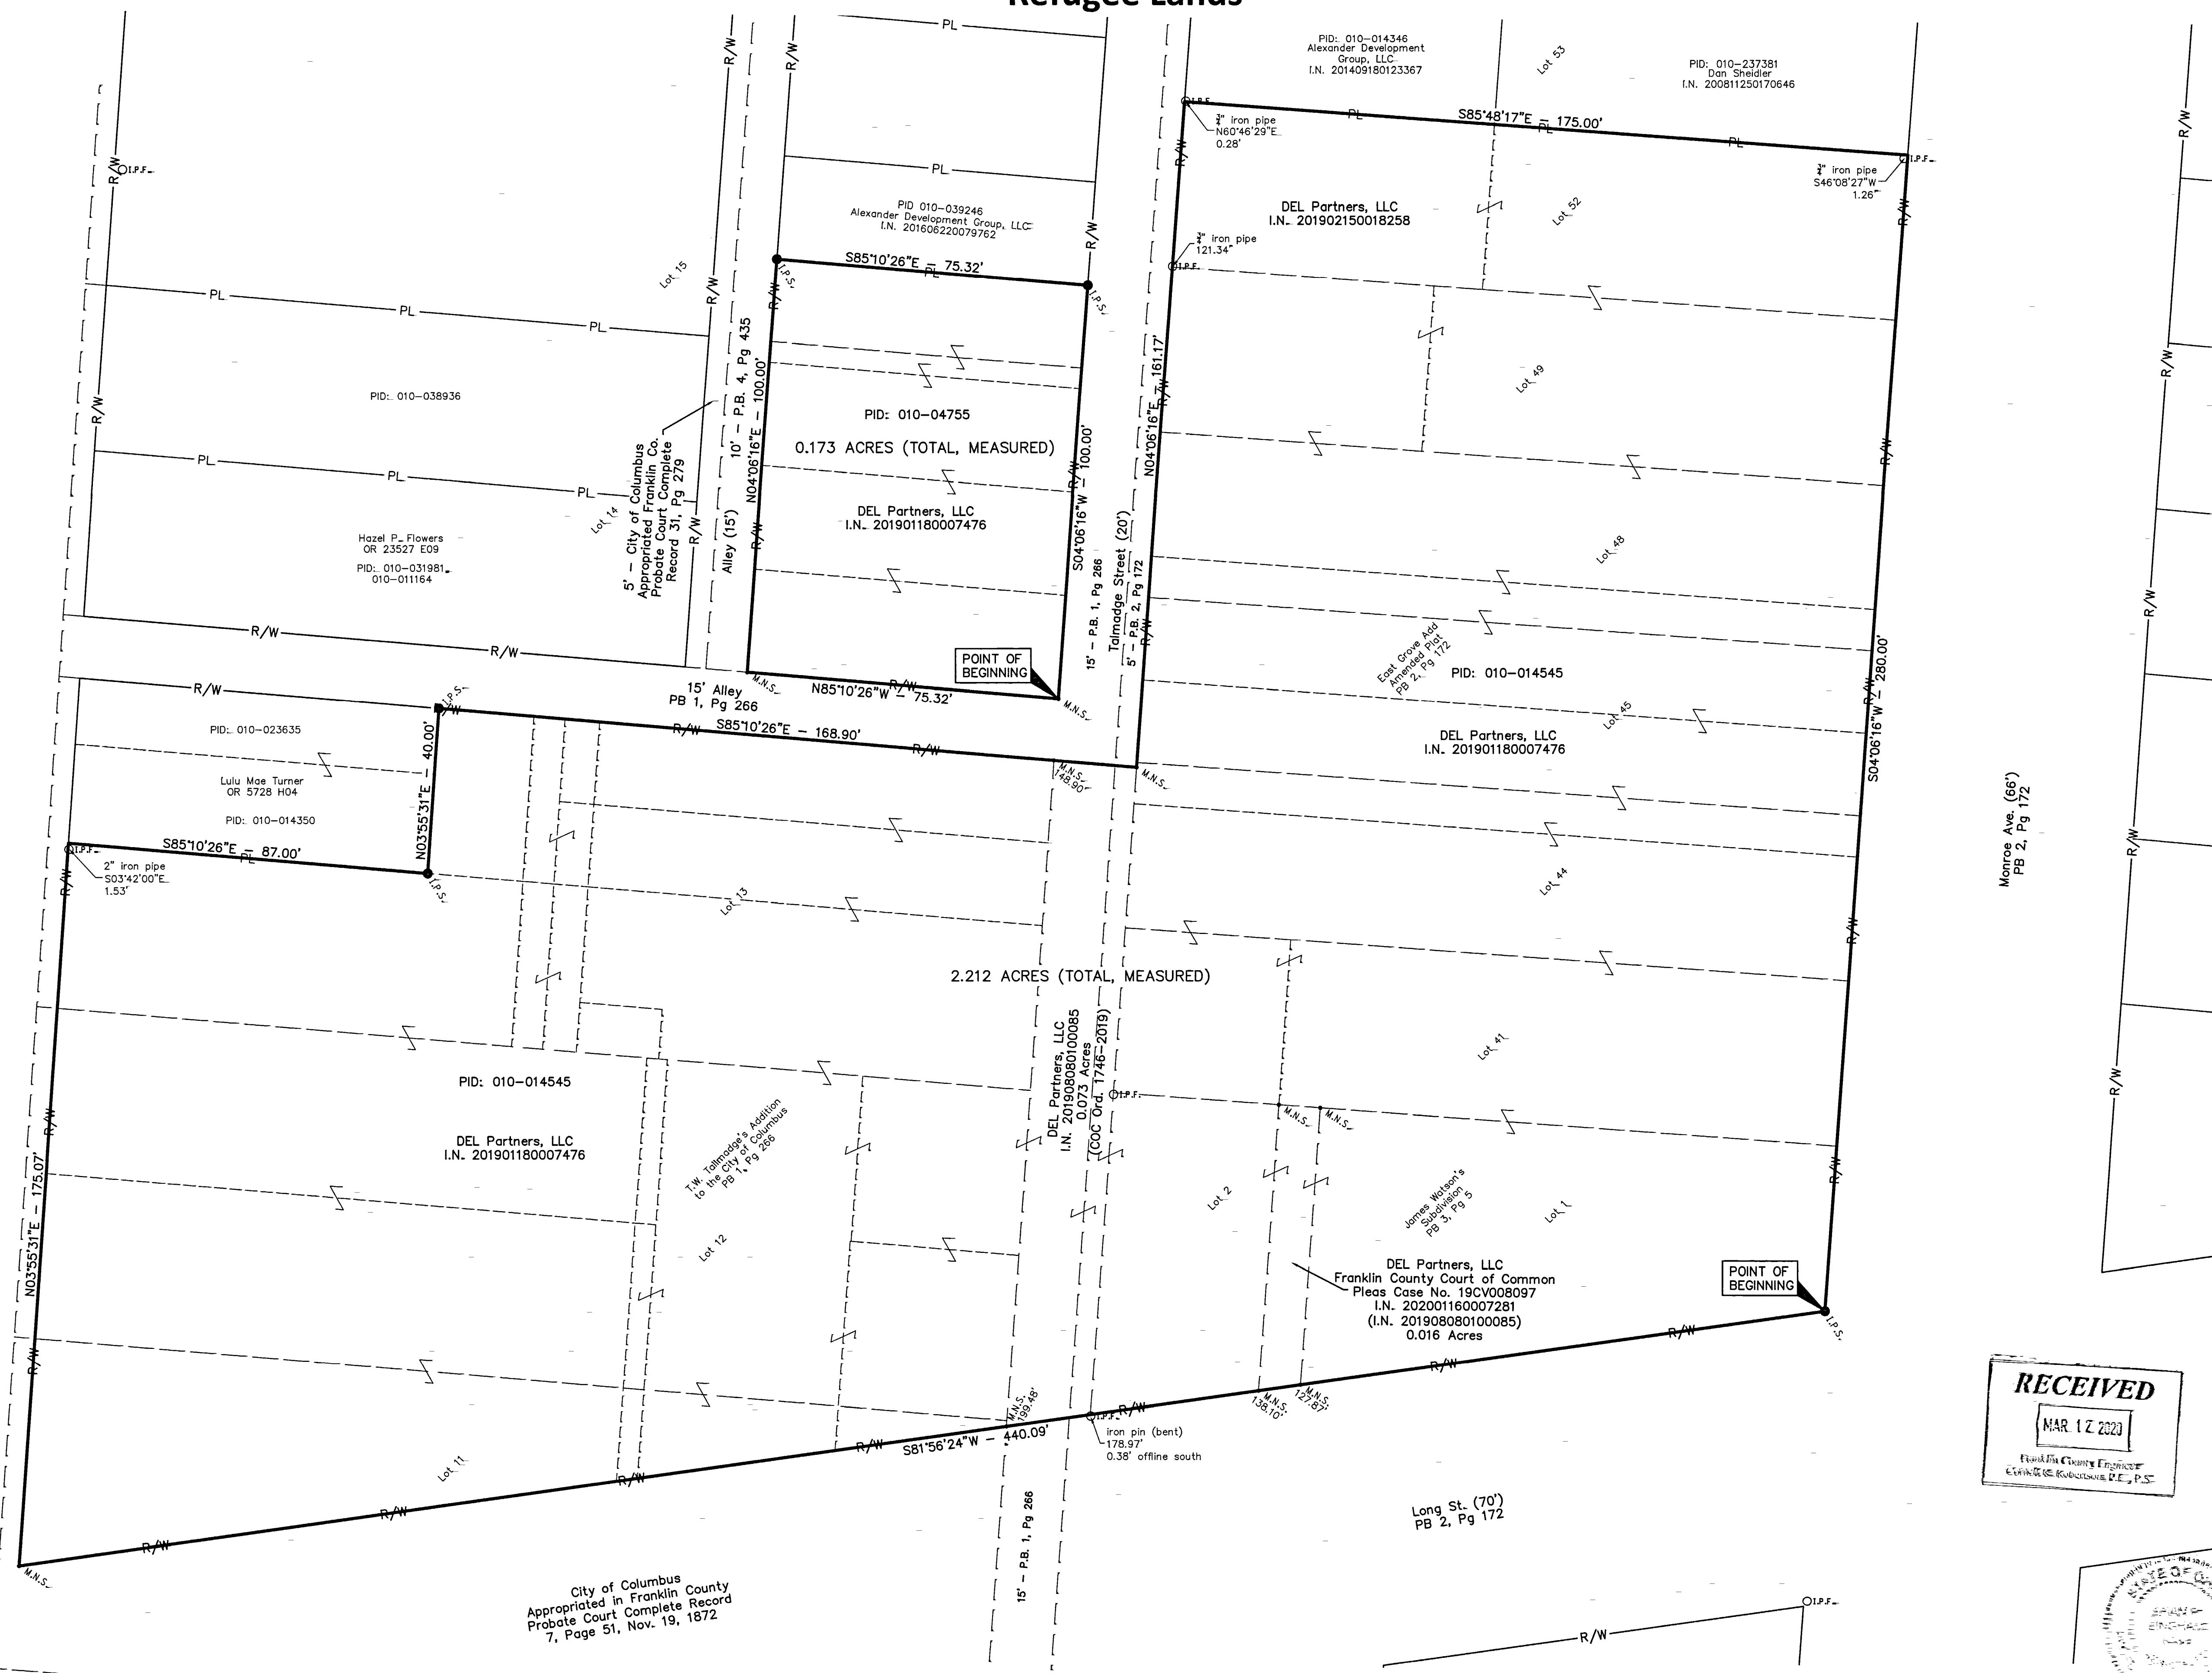

AMERICAN
STRUCTUREPOINT
 INC.



2250 Corporate Exchange Drive | Suite 300
 Columbus, Ohio 43231
 TEL 614.901.2235 | FAX 614.901.2236
 www.structurepoint.com

818 E. Long Street
 Columbus, OH 43203


CERTIFIED BY

ISSUANCE INDEX	
DATE:	03/10/2020

REVISION SCHEDULE		
NO.	DESCRIPTION	DATE

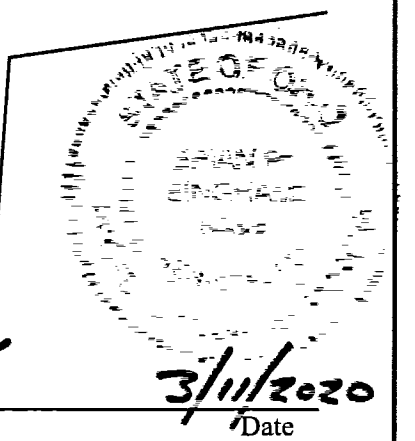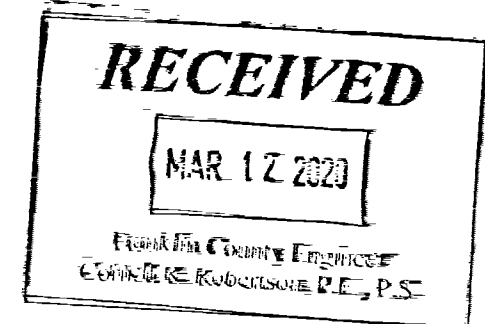

Brian P. Bingham
 Professional Land Surveyor 8438

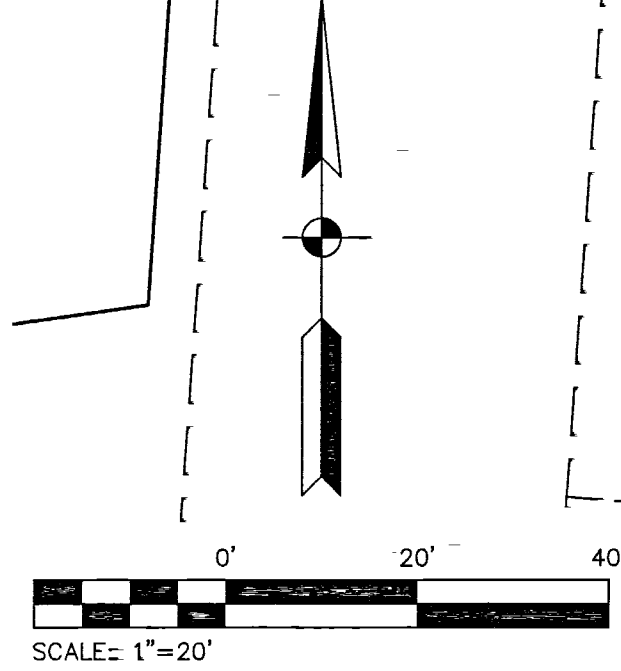

PLOT DATE: 3/11/2020 12:24 PM
 PLOT SCALE: 1"=20'
 DRAWINGS FILE: C:\00701763.D - Drawings\Survey\20170725.SV 2019-08-07 Boundary Plat.dwg
 EDITED BY: BRINGHAM

Project Number 2017.01763
Boundary Survey Plat