

16E




Evans, Mechwart, Hambleton & Tilton, Inc.
Engineers • Surveyors • Planners • Scientists
5500 New Albany Road, Columbus, OH 43054
Phone: 614.775.4500 Toll Free: 888.775.3648
emht.com

SURVEY OF ACREAGE PARCEL


LOT 23, QUARTER TOWNSHIP 1, TOWNSHIP 2, RANGE 16
UNITED STATES MILITARY DISTRICT
CITY OF NEW ALBANY, COUNTY OF FRANKLIN, STATE OF OHIO

Date:	March 24, 2021
Scale:	1" = 50'
Job No:	2021-0260
Sheet No:	1 of 1

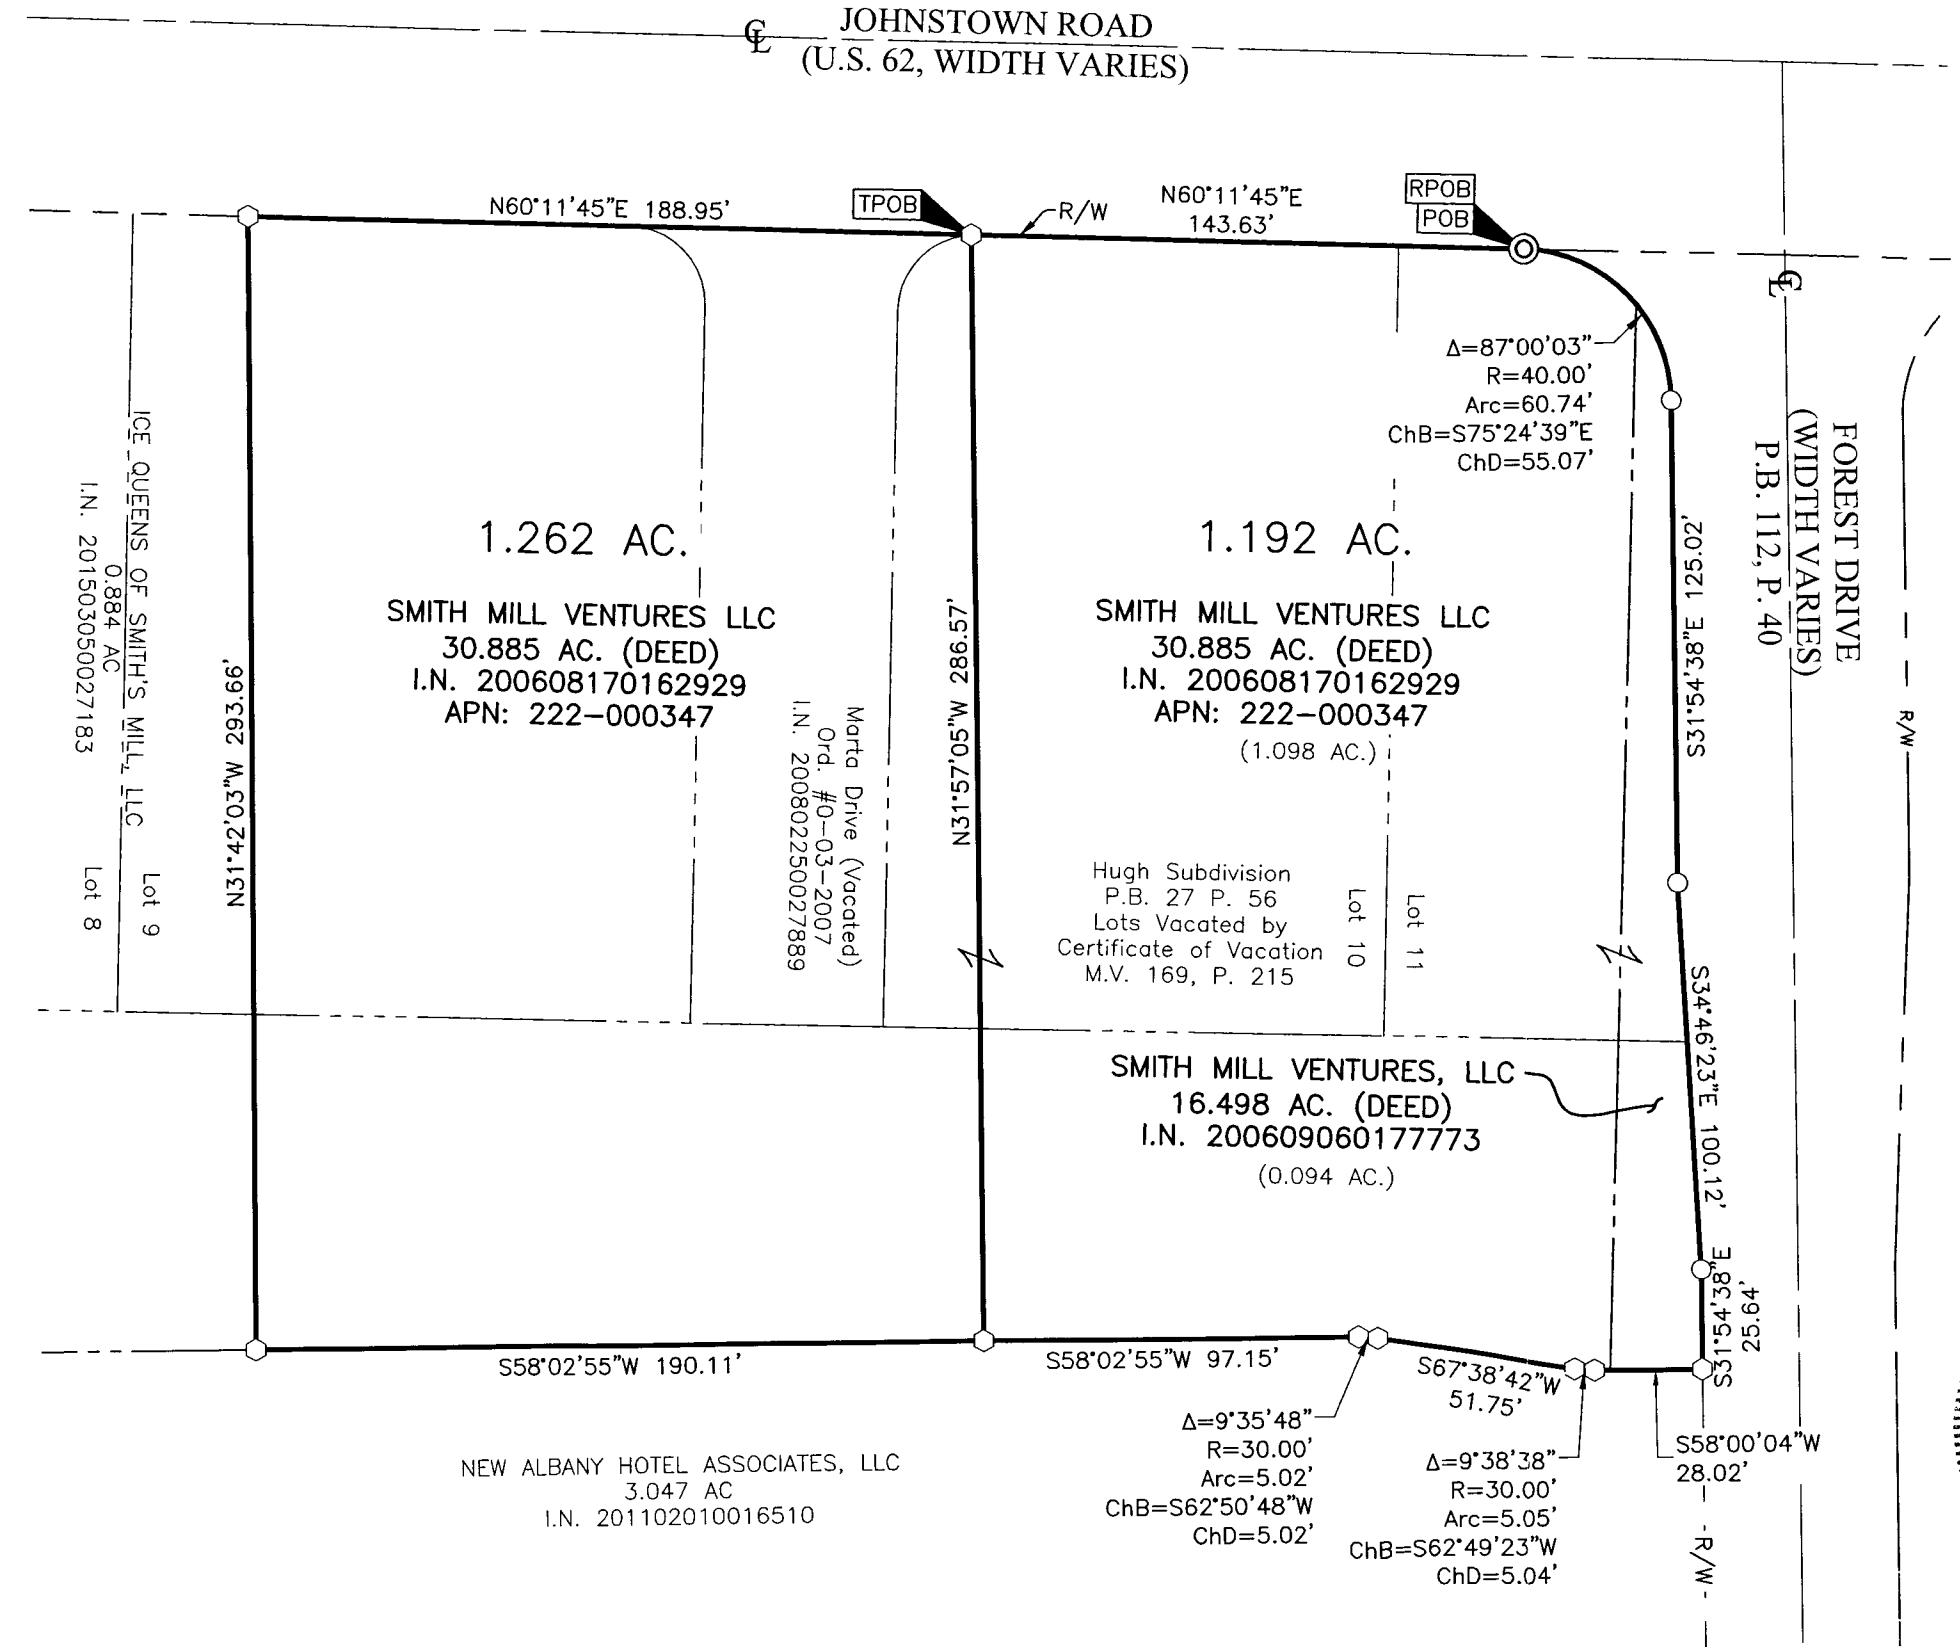


BASIS OF BEARINGS:
The Bearings shown hereon are based on South 31°54'38" East for the southwesterly right-of-way line of Forest Drive, of record in Plat Book 112, Page 40, Recorder's Office, Franklin County, Ohio.

SURVEY NOTE:
This survey was prepared using documents of record, prior plats of survey, and observed evidence located by an actual field survey.

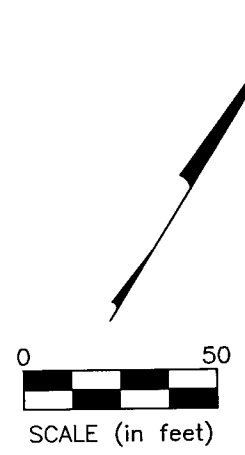

- = STONE FND.
- = MON. FND.
- = I.P. FND.
- = I.P. SET
- ◆ = MAG. NAIL FND.
- = MAG. NAIL SET
- ▲ = R.R. SPK. FND.
- ◆ = P.K. NAIL FND.

I.P. Set are 13/16" I.D. iron pipes 30" long with cap inscribed EMHT INC.

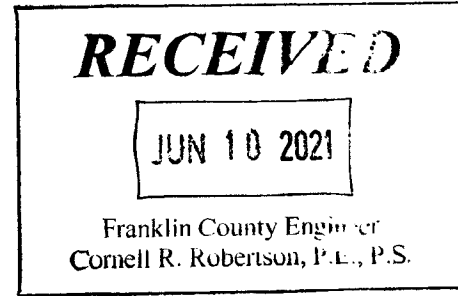

By Heather L. King Date 3/25/21
 Heather L. King
 Professional Surveyor No. 8307
 hking@emht.com

J:\20210260\DWG\04SHEETS\BOUNDARY\20210260-VS-BNDY-01.DWG plotted by KING, HEATHER on 3/25/2021 9:52:30 AM last saved by KING on 3/25/2021 9:49:38 AM