



Evans, Mechwart, Hambleton & Tilton, Inc.  
 Engineers • Surveyors • Planners • Scientists  
 5500 New Albany Road, Columbus, OH 43054  
 Phone: 614.775.4500 Toll Free: 888.775.3648  
 emht.com


# SURVEY OF ACREAGE PARCEL

SURVEY NUMBER 717, VIRGINIA MILITARY DISTRICT  
 CITY OF COLUMBUS, COUNTY OF FRANKLIN, STATE OF OHIO

Date: February 7, 2020

Scale: 1" = 100'

Job No: 2019-0925

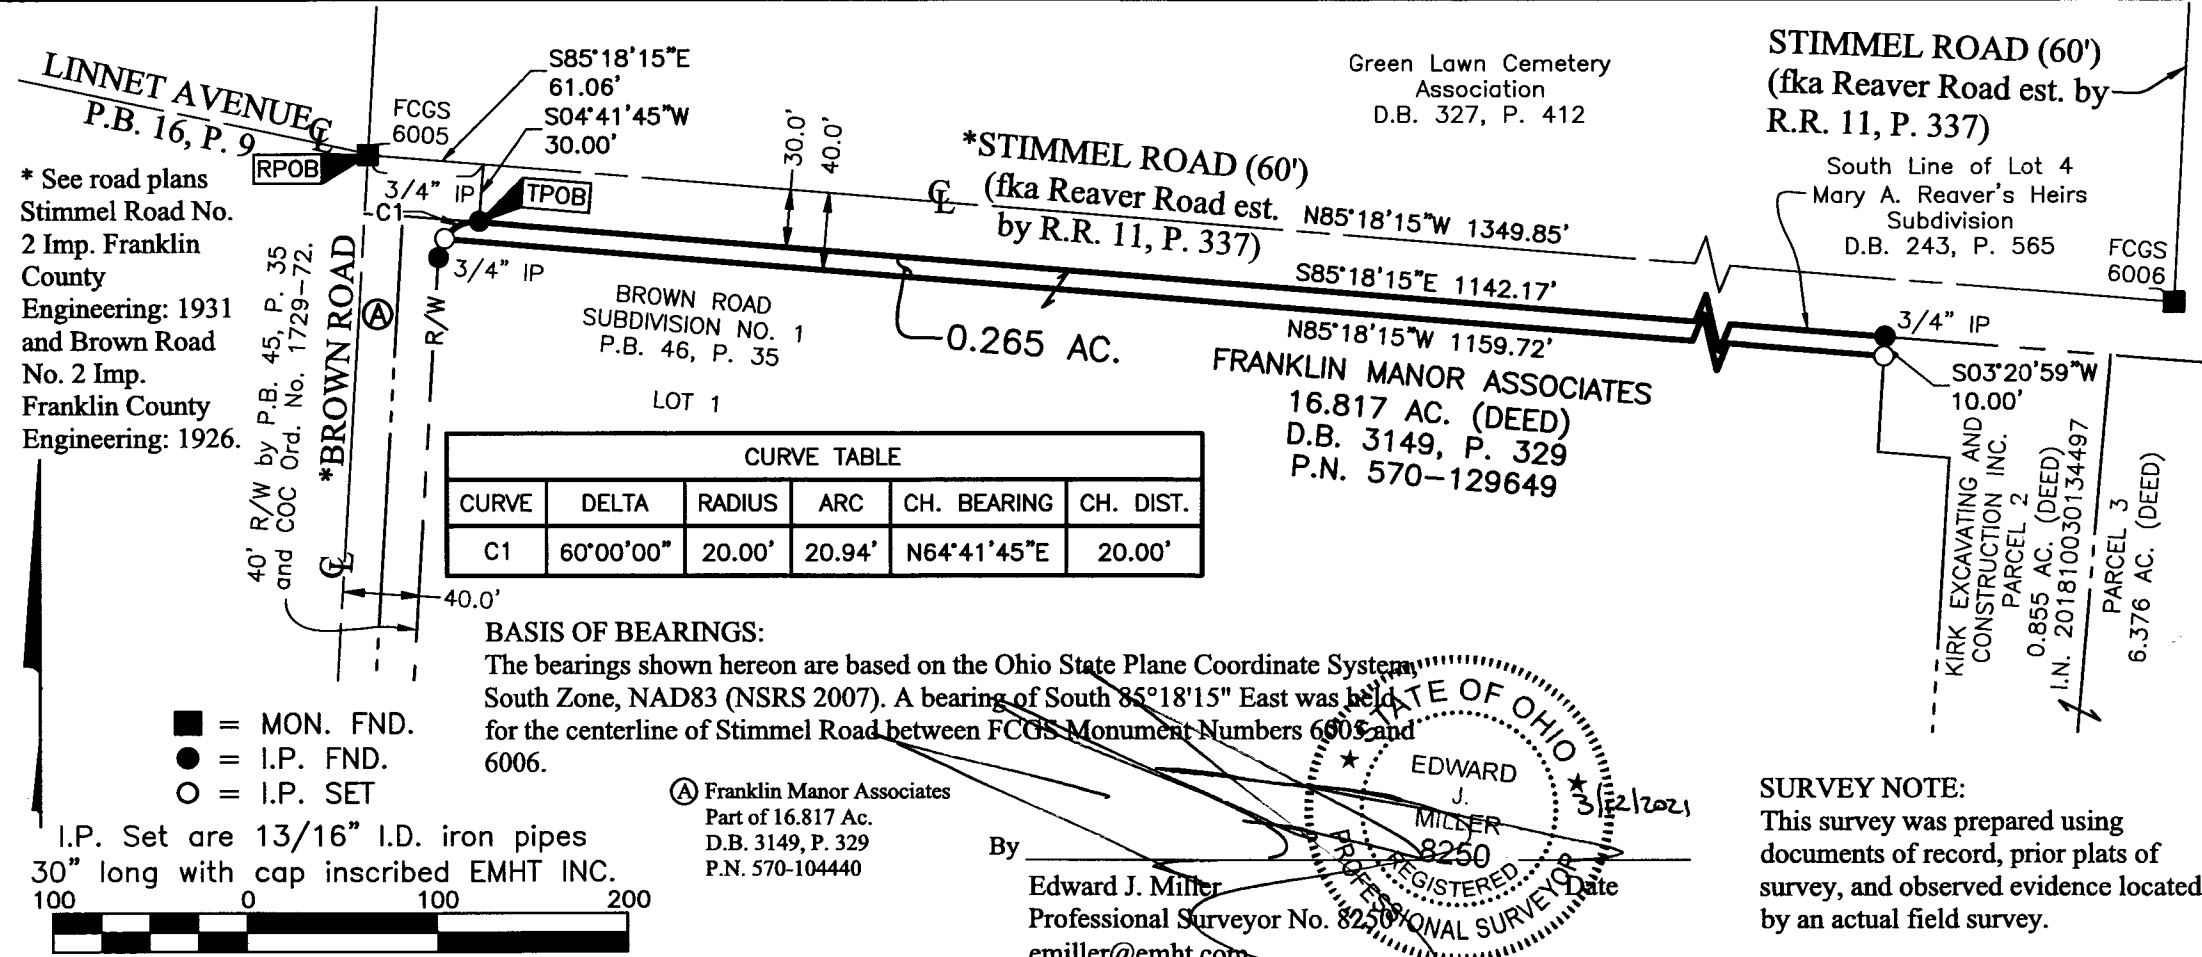

**RECEIVED**  
 AUG 27 2021  
 Franklin County Engineer  
 Cornell R. Robinson, P.E., P.S.

STATE OF OHIO  
 EDWARD J. MILLER  
 8250  
 REGISTERED PROFESSIONAL SURVEYOR  
 Date: 3/22/2021

By  
 Edward J. Miller  
 Professional Surveyor No. 8250  
 emiller@emht.com

**SURVEY NOTE:**  
 This survey was prepared using documents of record, prior plats of survey, and observed evidence located by an actual field survey.