

Myers Surveying Company, Inc.

2740 East Main Street, Columbus 43209 (Bexley), Ohio
614-235-8677 FAX:614-235-4559



A Boundary Survey prepared for and certified to:

David Rastoka

Legal Description: Situated in The State of Ohio, County of Franklin, City of Columbus, Being Lot 9 & Part of Lot 10 of Kempton Run, Plat Book 104, Page 71

Applicant:

Posted Address: 5767 Kempton Run Ct., Columbus, Ohio

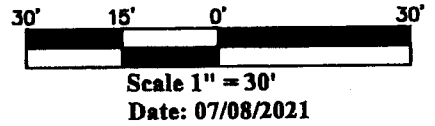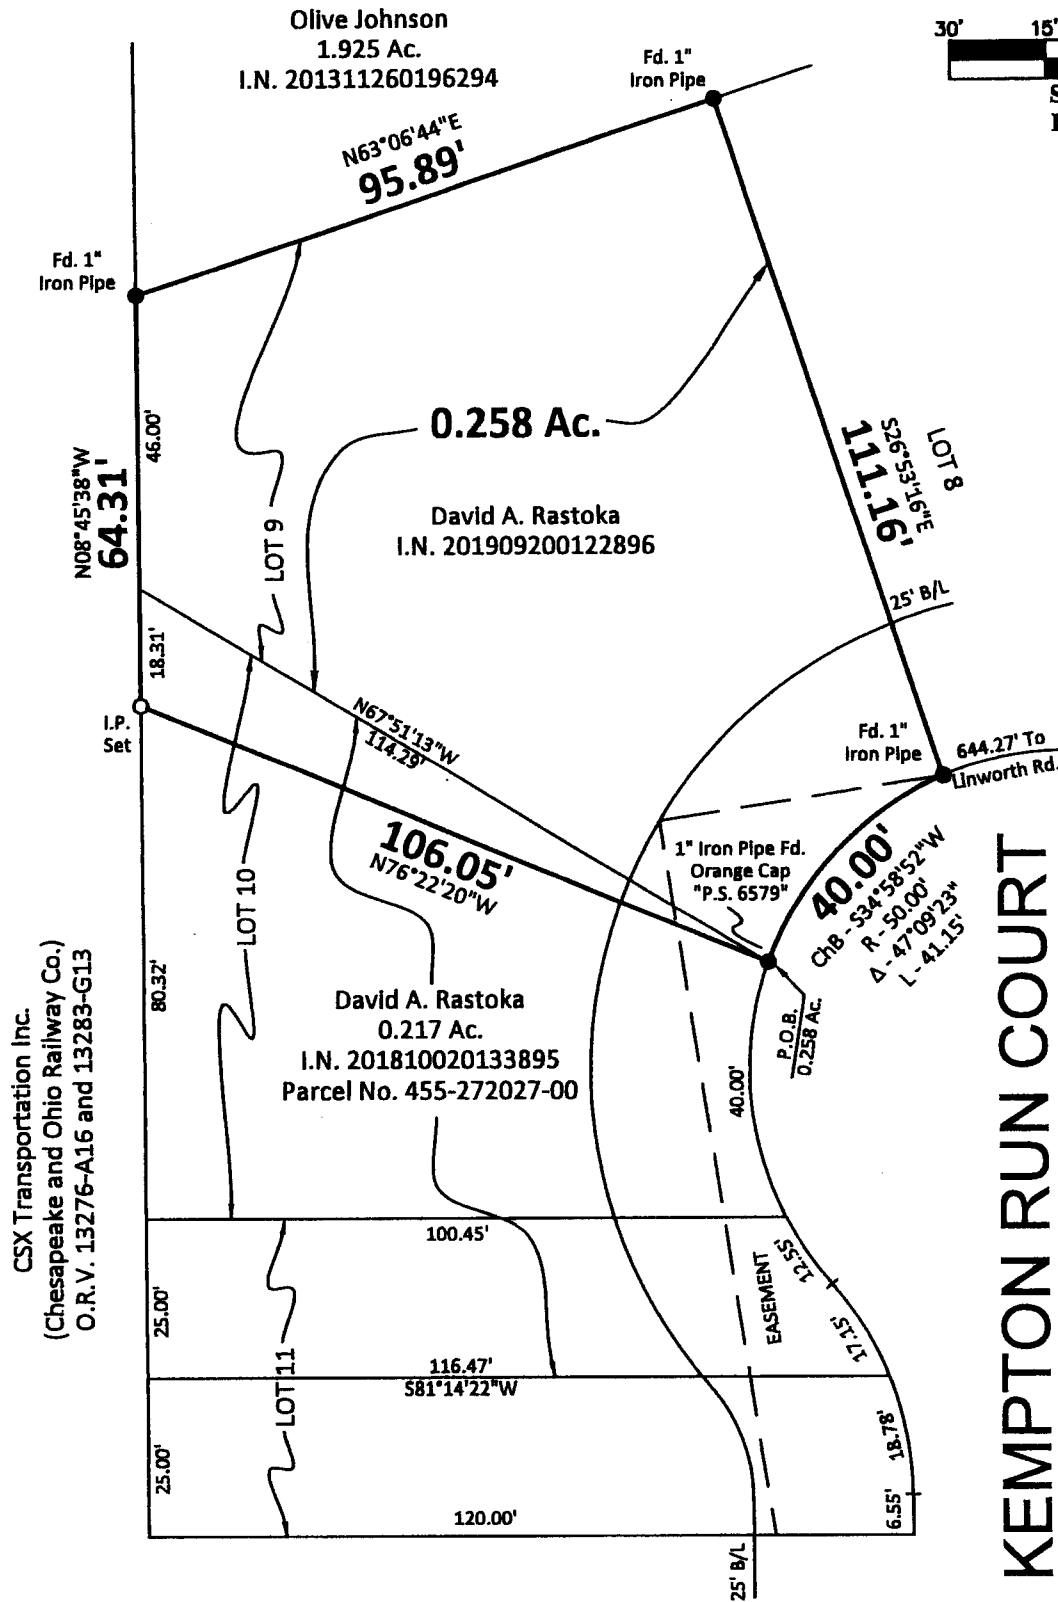


RECEIVED

JUL 19 2021

Franklin County Engineer
Connell R. Robertsou, P.E., P.S.

KEMPTON RUN COURT

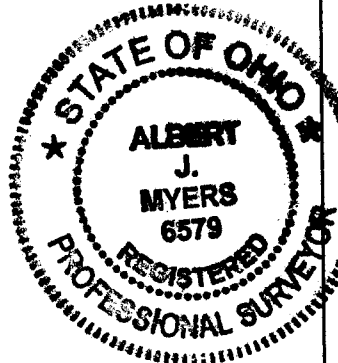

Myers Surveying Co., Inc

By *Albert J. Myers*
7/19/2021
Professional Surveyor

We hereby certify that the foregoing Boundary Survey was prepared from actual field measurements in accordance with Chapter 4733-37 Ohio Administrative Code. Iron pipes set are 30"x1" O.D. with an orange plastic plug inscribed "MYERS P.S. 6579", unless otherwise noted. Basis of bearings is the north line of Lot 10 held as S67°51'13"E per P.B. 104, Pg. 71.

Myers Order No.-5-04/26/2021	Rec.	Field	DWG.	Ltr.	Ck.
------------------------------	------	-------	------	------	-----