RECEIVED
JAN 13 2022
Franklin County Engineer
Cornell R. Robertson, P.E., P.S.

H-2-F, H-5-C

EMH&T
Evans, Mechwart, Hambleton & Tilton, Inc.
Engineers • Surveyors • Planners • Scientists
5500 New Albany Road, Columbus, OH 43054
Phone: 614.775.4500 Toll Free: 888.775.3648
emht.com

SURVEY OF ACREAGE PARCEL

SECTION 28, TOWNSHIP 4, RANGE 22
CONGRESS LANDS EAST OF SCIOTO
CITY OF COLUMBUS, COUNTY OF FRANKLIN, STATE OF OHIO

Date: December 17, 2021 | Scale: 1" = 100' | Job No: 2020-0254 | Sheet No: 1 of 1

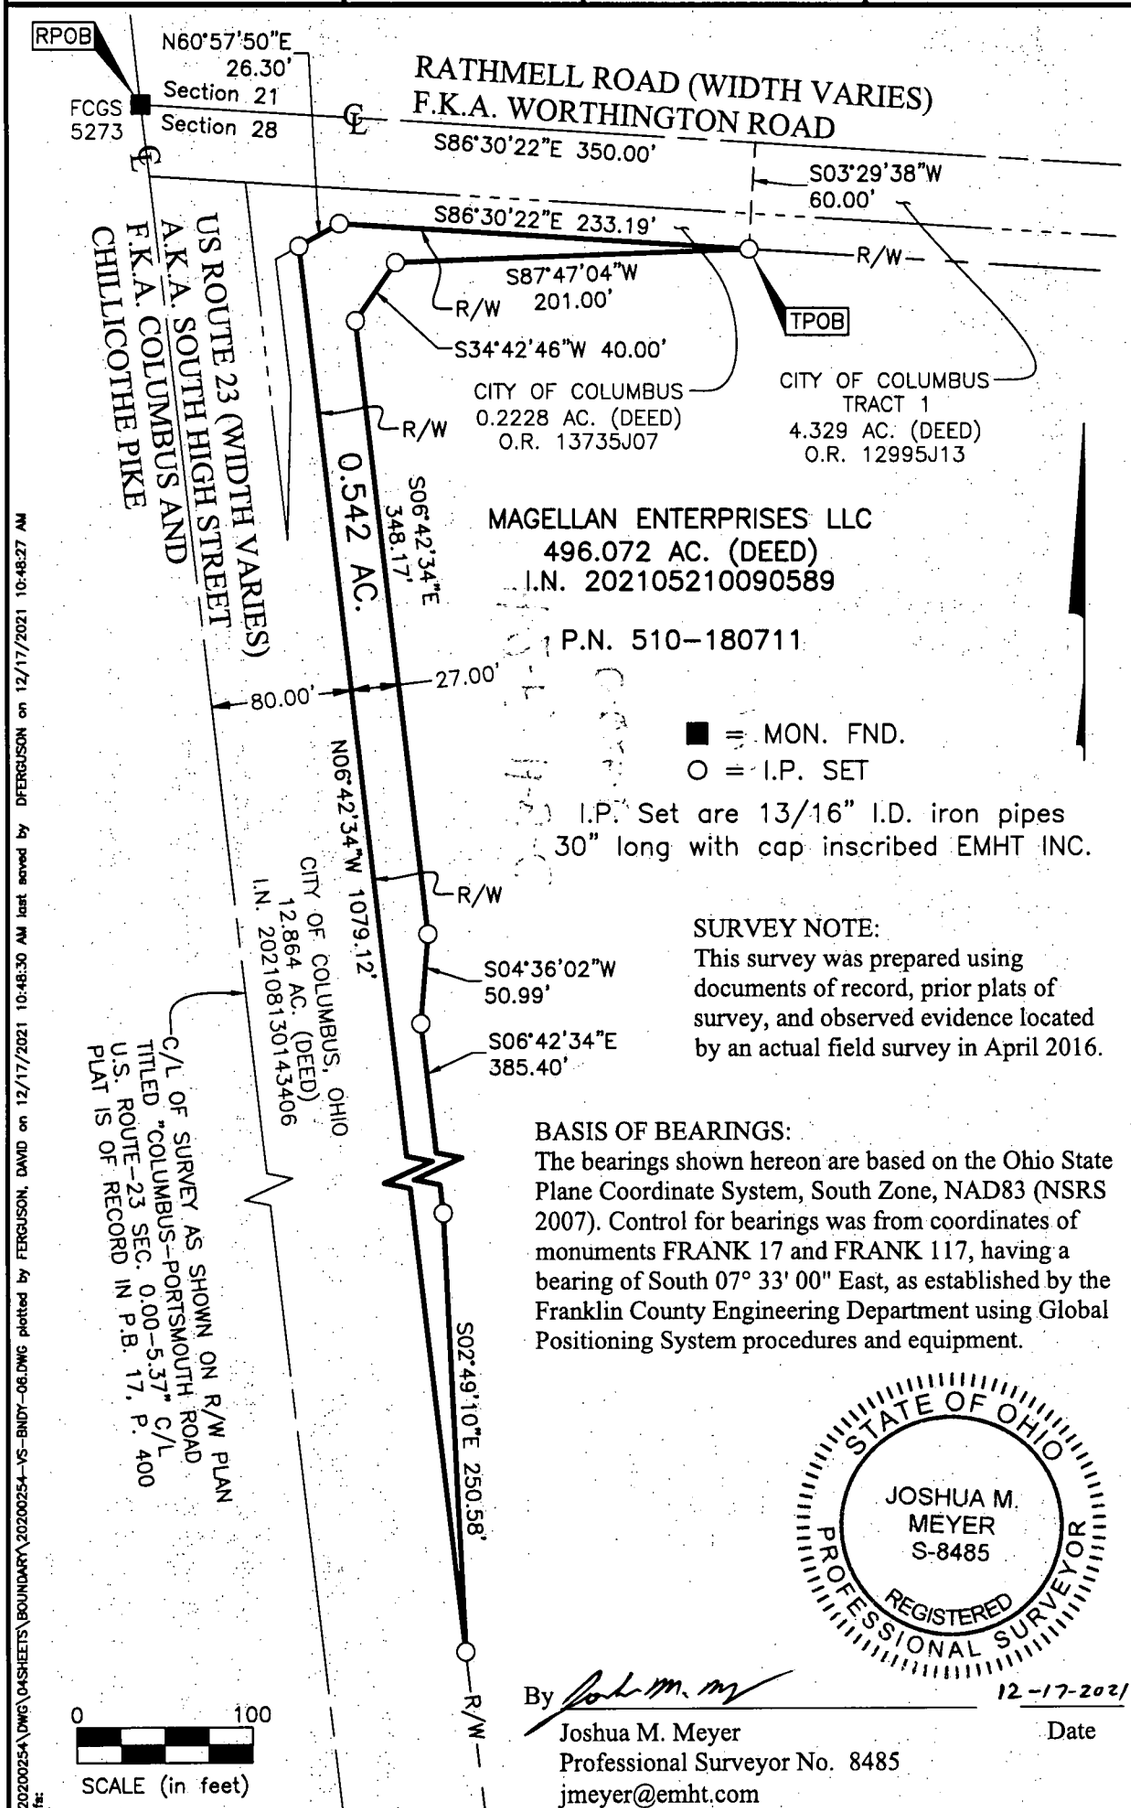

SURVEY NOTE:
This survey was prepared using documents of record, prior plats of survey, and observed evidence located by an actual field survey in April 2016.

BASIS OF BEARINGS:
The bearings shown hereon are based on the Ohio State Plane Coordinate System, South Zone, NAD83 (NSRS 2007). Control for bearings was from coordinates of monuments FRANK 17 and FRANK 117, having a bearing of South 07° 33' 00" East, as established by the Franklin County Engineering Department using Global Positioning System procedures and equipment.

STATE OF OHIO
JOSHUA M. MEYER
S-8485
REGISTERED
PROFESSIONAL SURVEYOR

By _____ 12-17-2021
Joshua M. Meyer — Date
Professional Surveyor No. 8485
jmeyer@emht.com

J:\2020025A\DWG\04SHEETS\BOUNDARY\20200254-VS-BNDY-06.DWG plotted by FERGUSON, DAVID on 12/17/2021 10:48:30 AM last saved by DFERGUSON on 12/17/2021 10:48:27 AM
Xrefs: