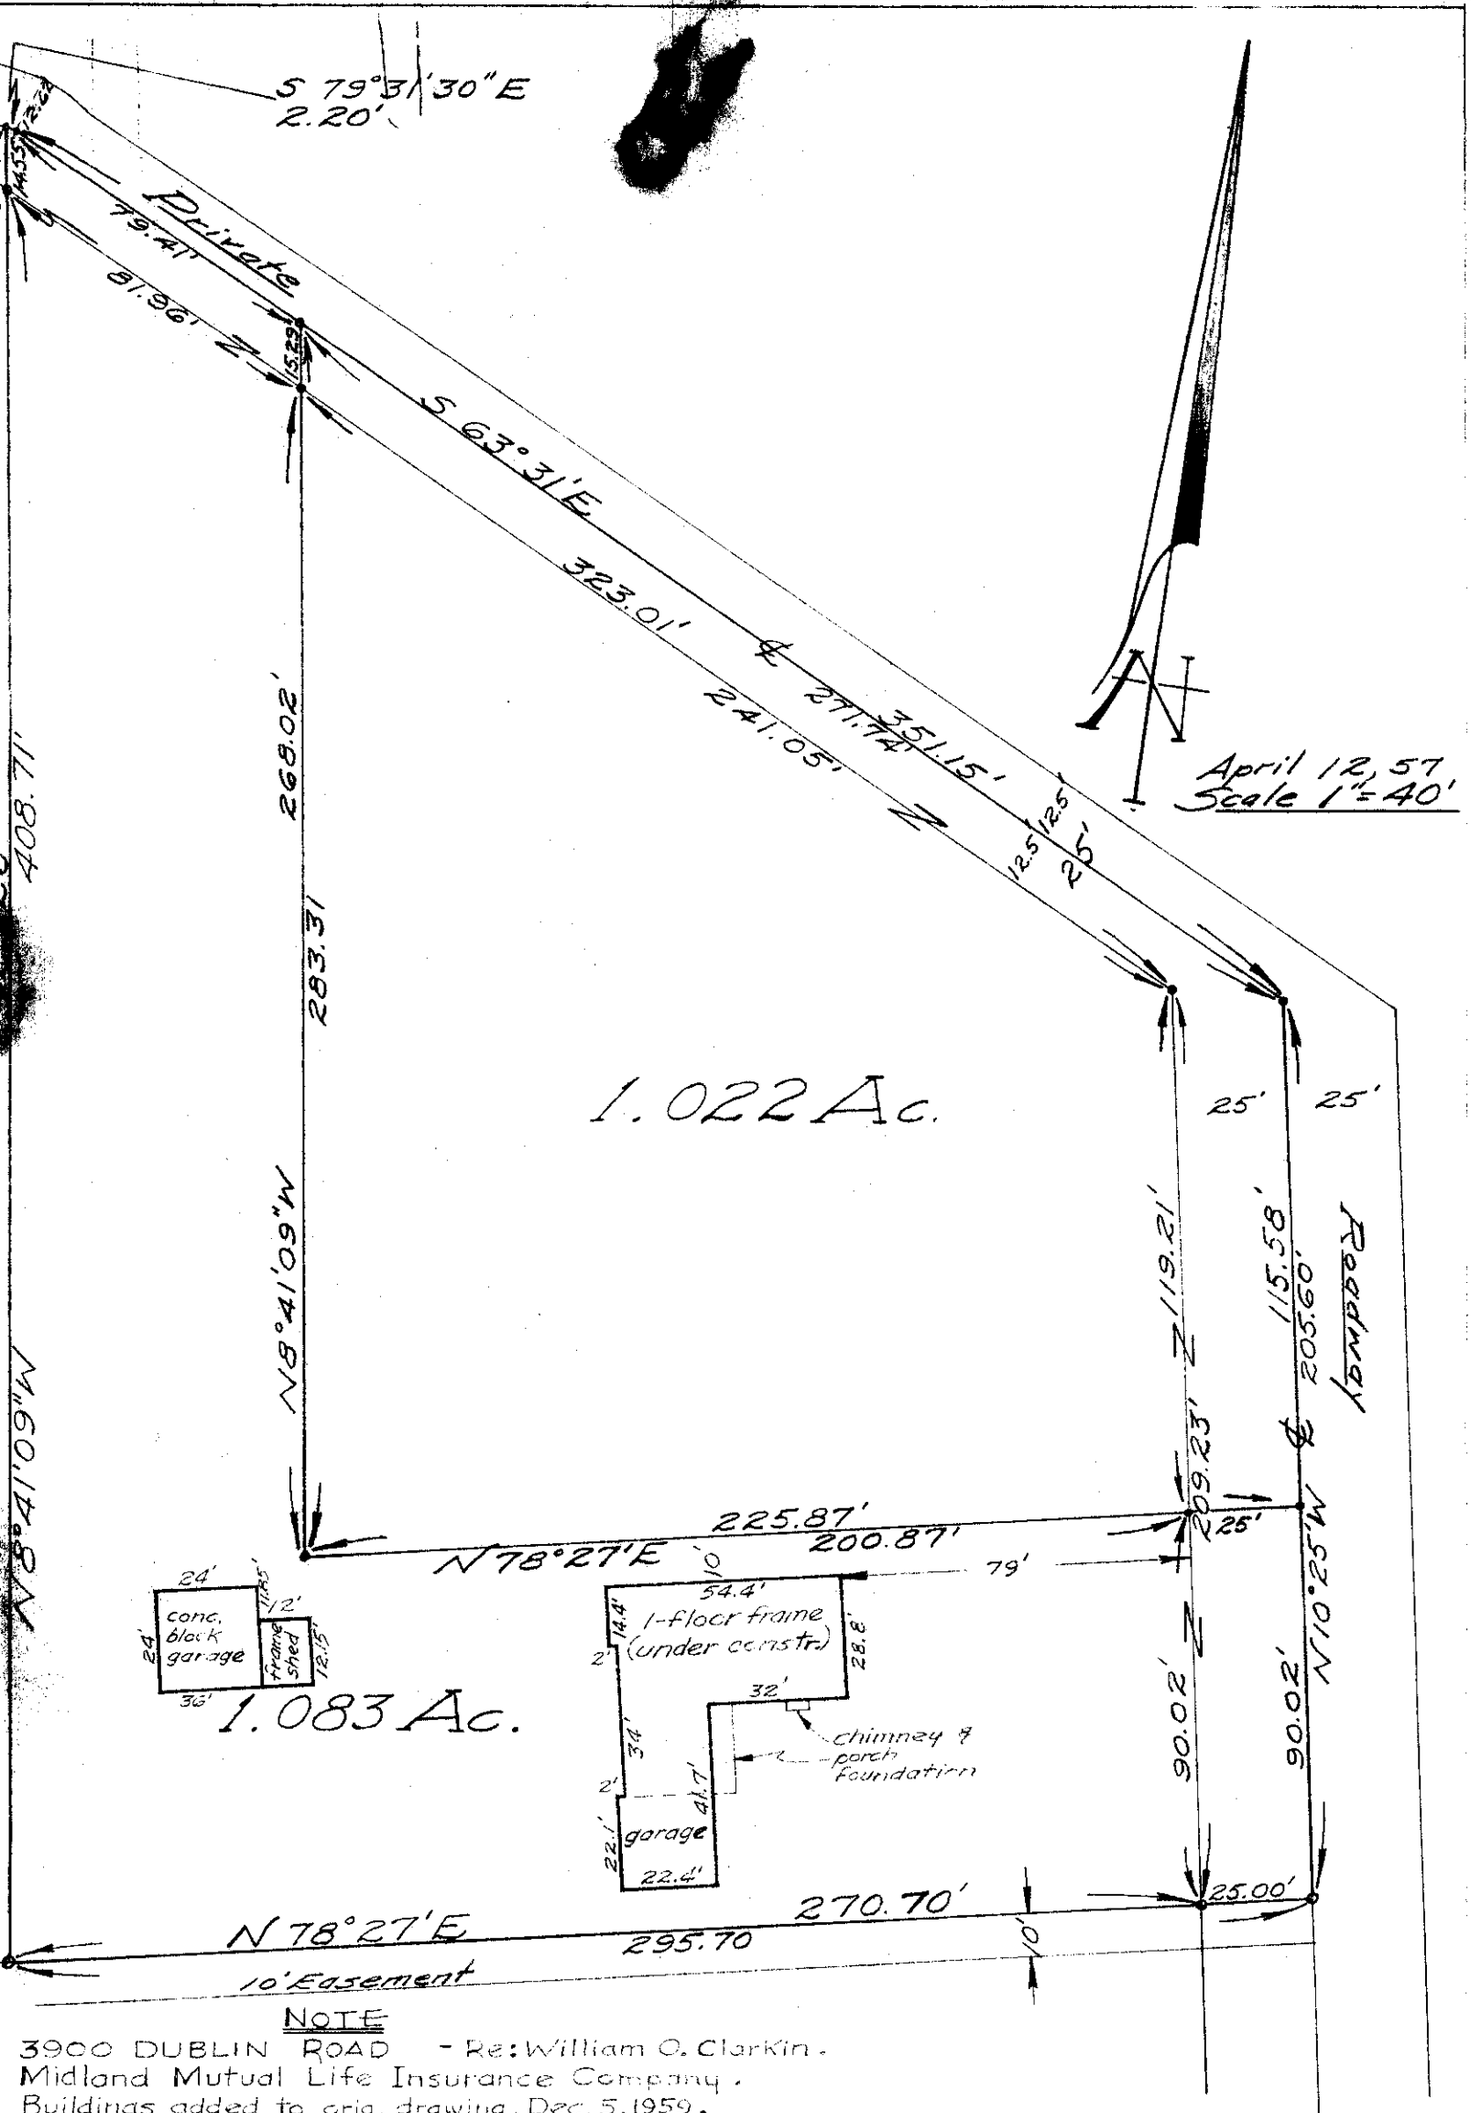

NOTE

3900 DUBLIN ROAD - Re: William O. Clarkin.
Midland Mutual Life Insurance Company.
Buildings added to orig. drawing, Dec. 5, 1959.
I hereby certify that I prepared the entire drawing from survey and inspection of the above shown property.
Being more particularly described as per attached initialed copy.

Harry L. Greene

Harry L. Greene, Reg. Surveyor No. 4058.

1.022 Ac. & 1.083 Ac., being part of Survey No. 547, Virginia Military District, Norwich Twp. Franklin County, Ohio.

05-12-59