


SCIOTANGY DRIVE

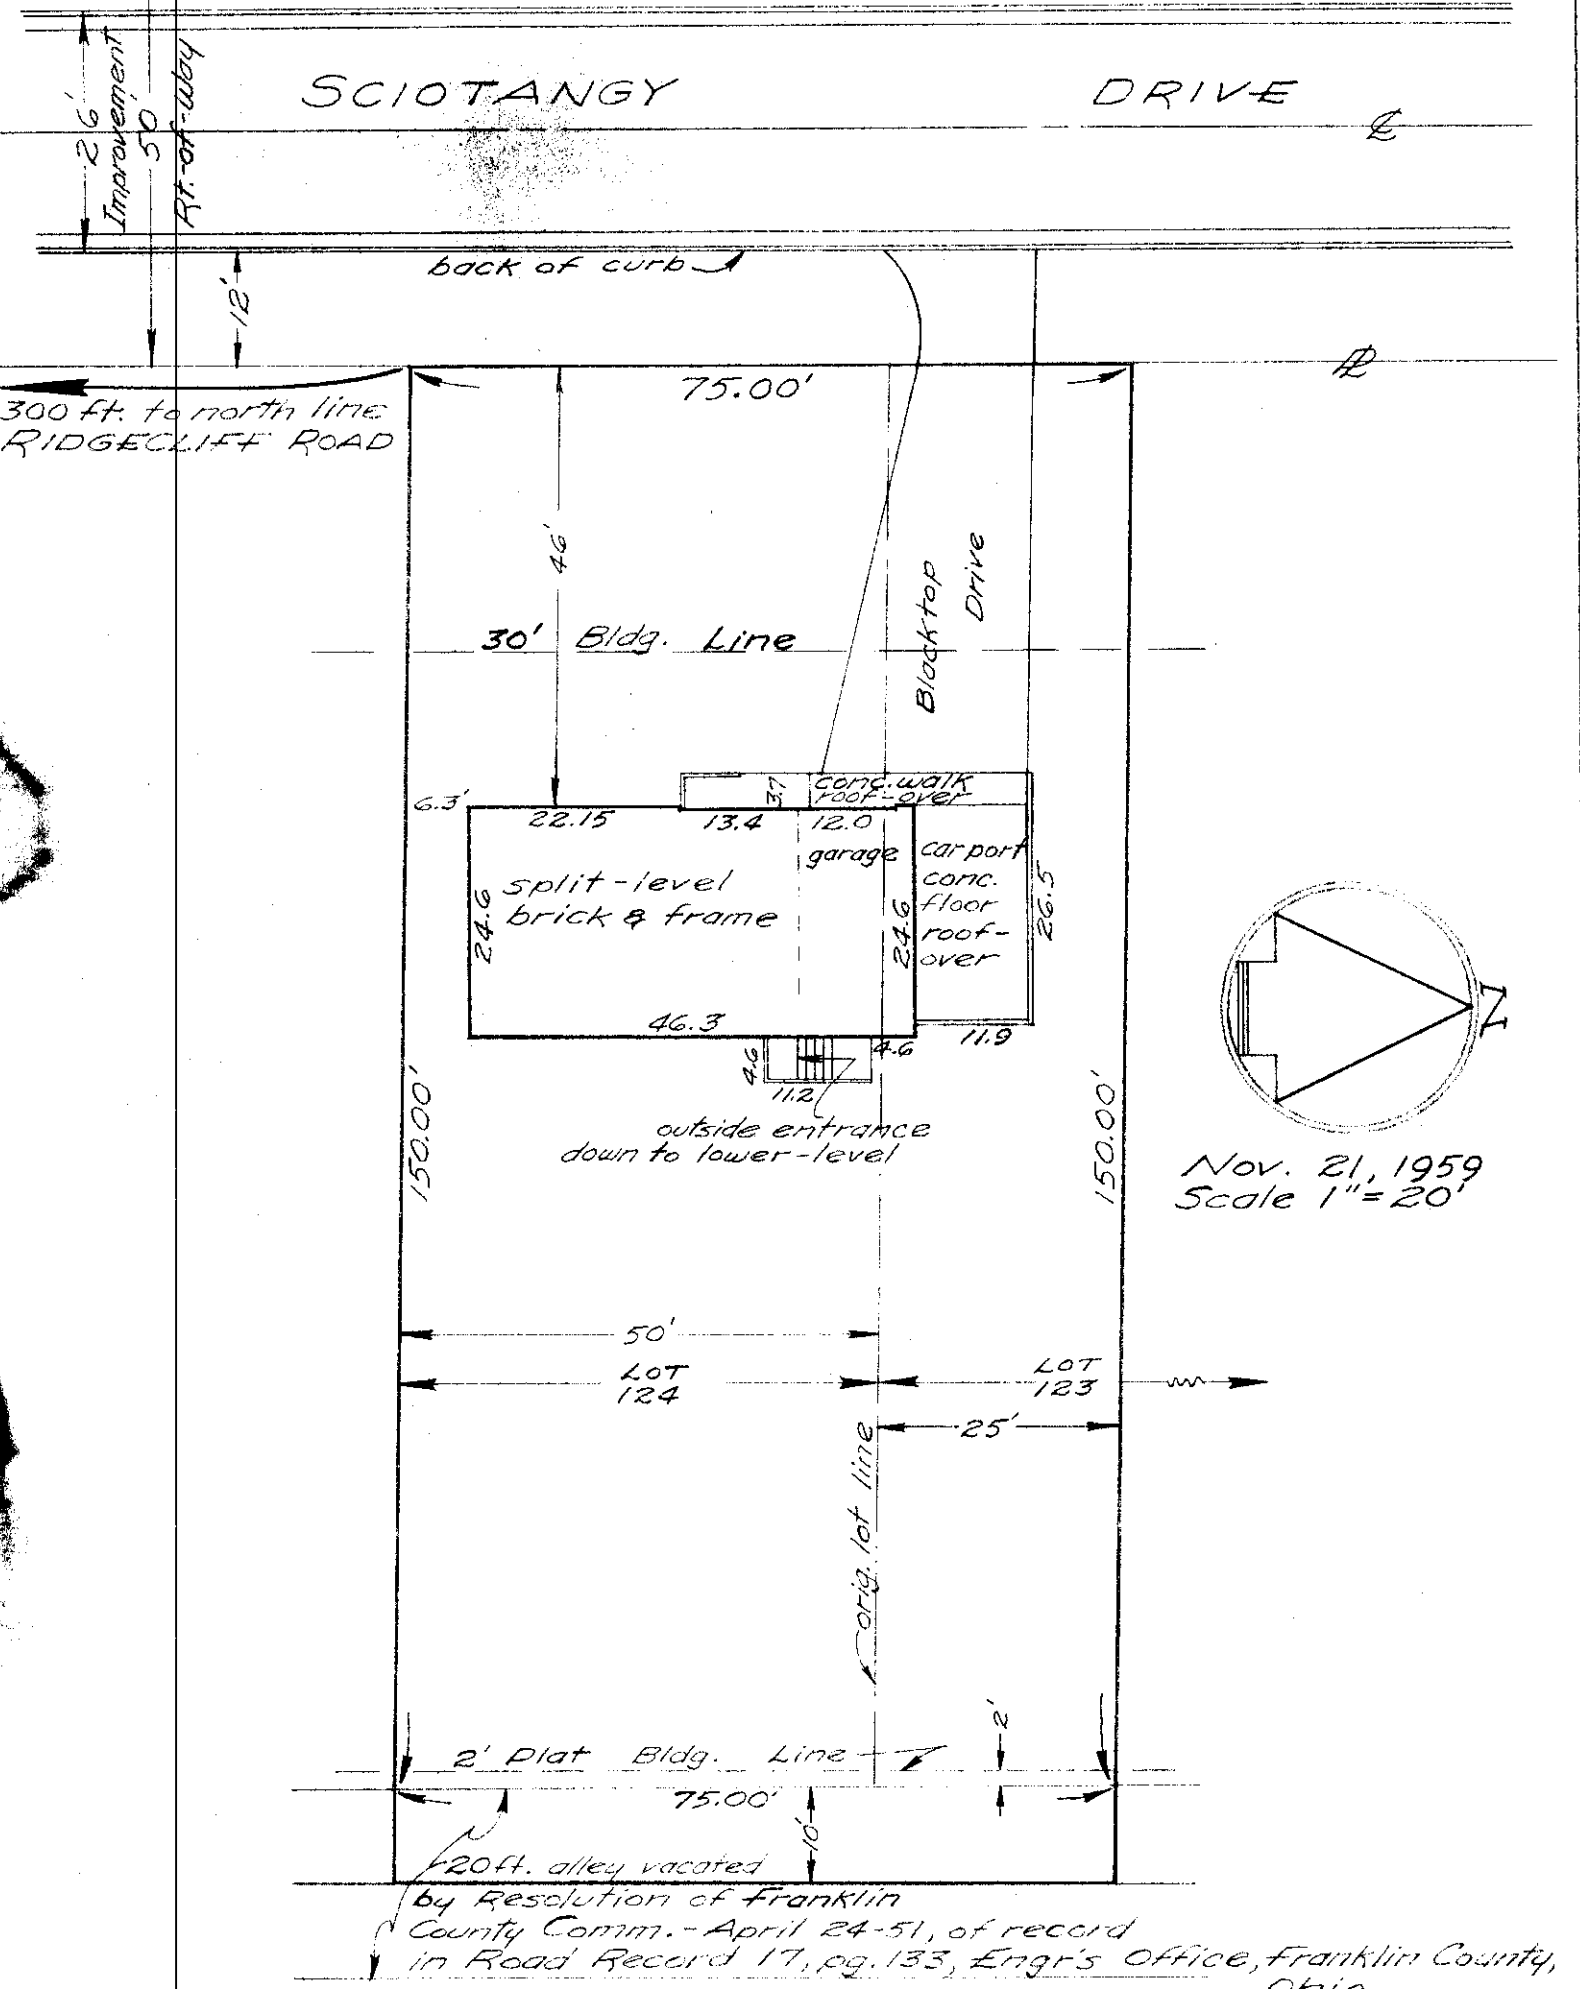

Nov. 21, 1959
Scale 1" = 20'

3314 SCIOTANGY DRIVE

21-11-59

City of Upper Arlington, Franklin County, Ohio.
Lawyers Title Ins. Corp. & Pacific Mutual Life Ins. Co.
Re: John Jeffries.

Blue Print Survey

I hereby certify that I have prepared the above plat from survey and inspection of herein described premises and existing conditions as shown above.

Being Lot No. 124 and including 25.0 ft. off of the south side of Lot No. 123, of the First Amended Subdivision of Lots No. 1-5, both incl. and Nos. 52 to 54, both incl., of Harold E. Duesenberry's Sciotangy Heights Acre Subdivision, as the same is shown of record in Plat No. 14, pg. 38, Recorder's Office, Franklin County, Ohio.

HARRY B. GREENE
HARRY B. GREENE, P.E. SURVEYOR - No. 4058