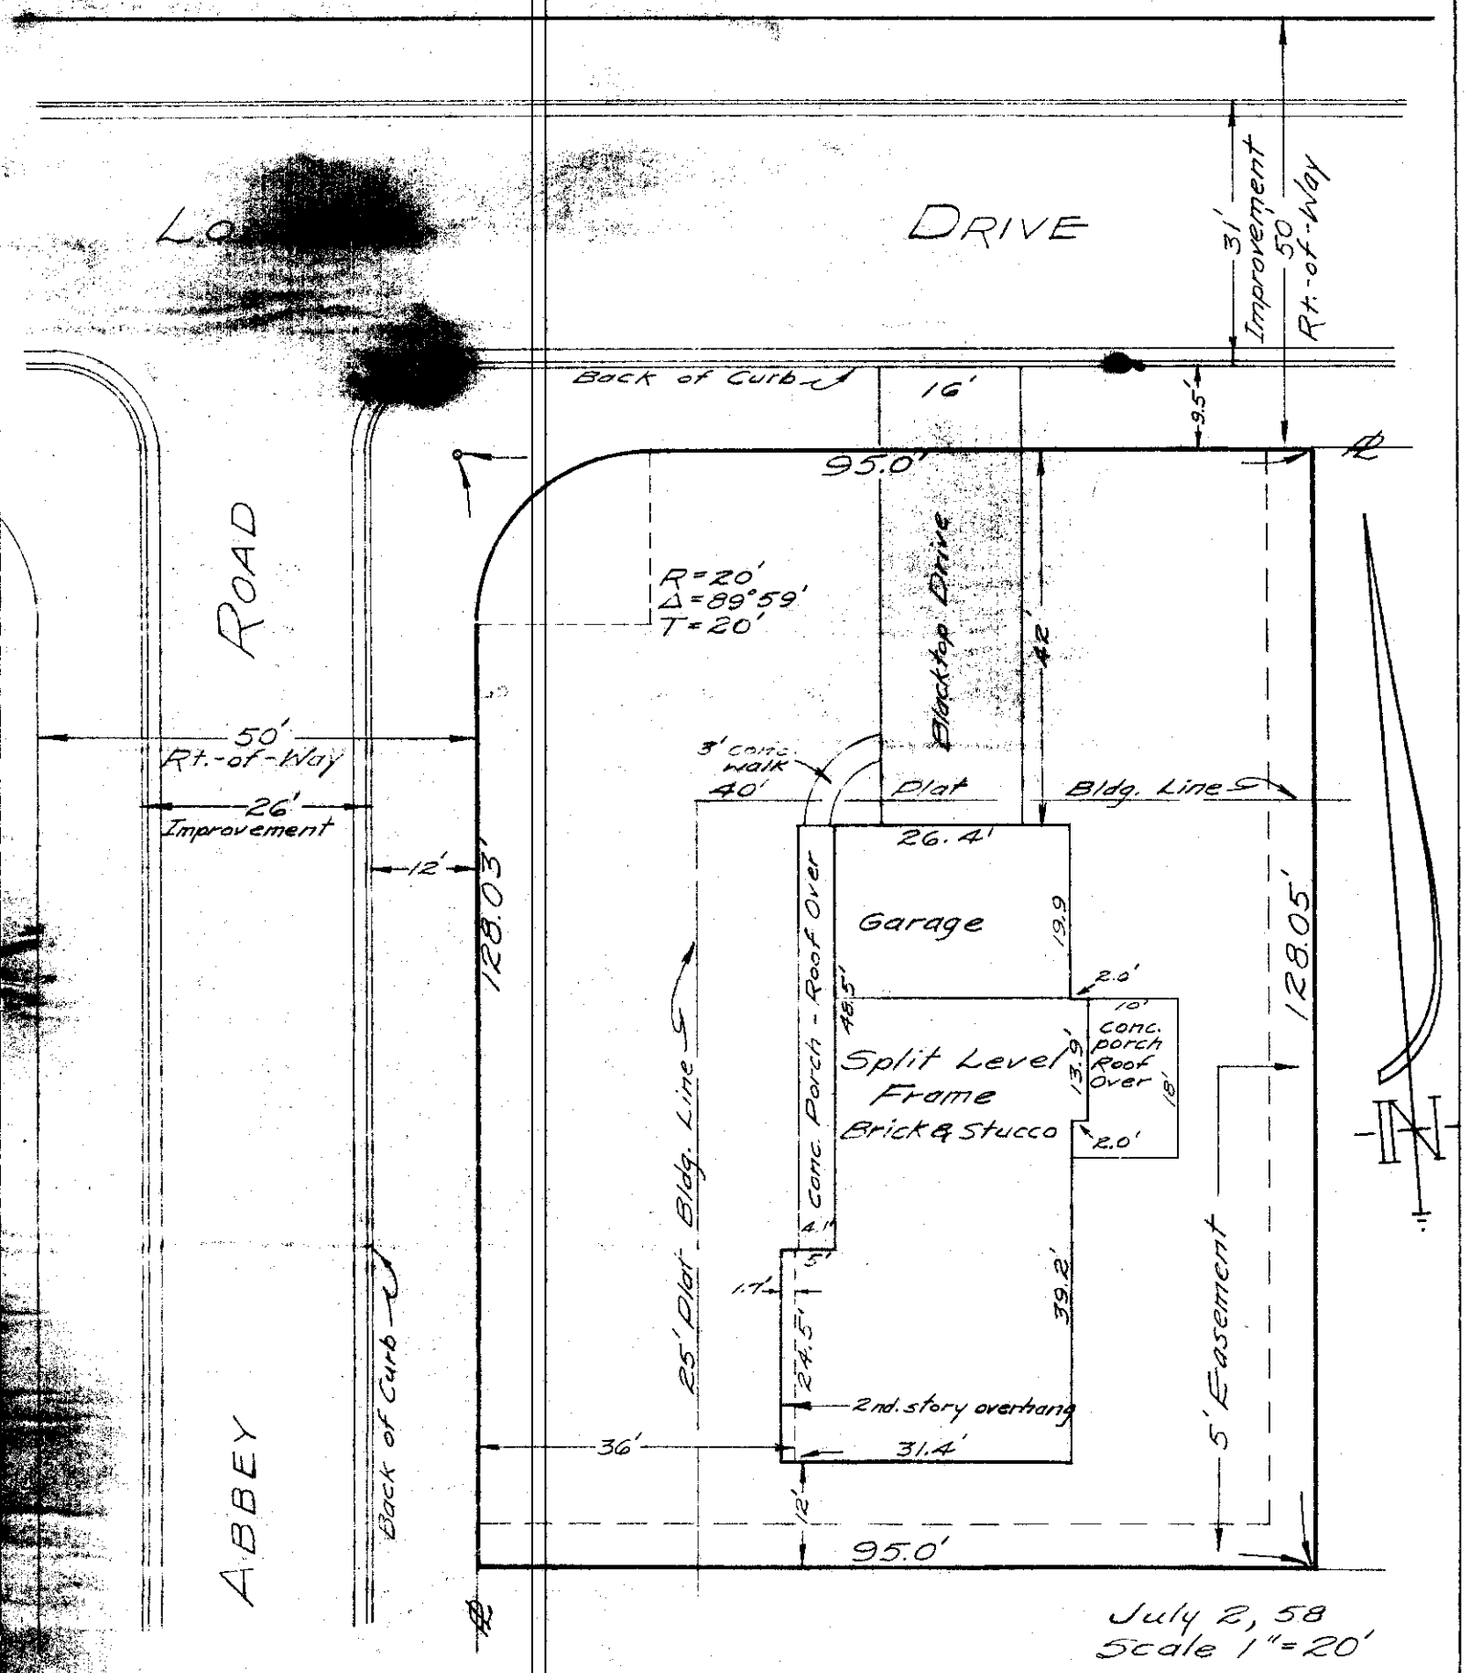

3376 ABBEY ROAD
City of Upper Arlington, Franklin County, Ohio.
Re: Howard N. & Helen B. Bullock.
~ Blue Print Survey ~

I hereby certify that I have prepared the above plat from survey and inspection of herein described premises and existing conditions are as shown above.

Being Lot No. 54 of WESTWOOD ACRES of record in Plat Book 28, page 50, Recorder's Office, Franklin County, Ohio.

Harry L. Greene 2-07-58

Harry L. Greene, Reg. Surveyor, No. 4058.