
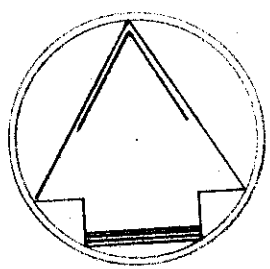


FRIAR LANE

672.50 ft. to east line ABBEY ROAD.

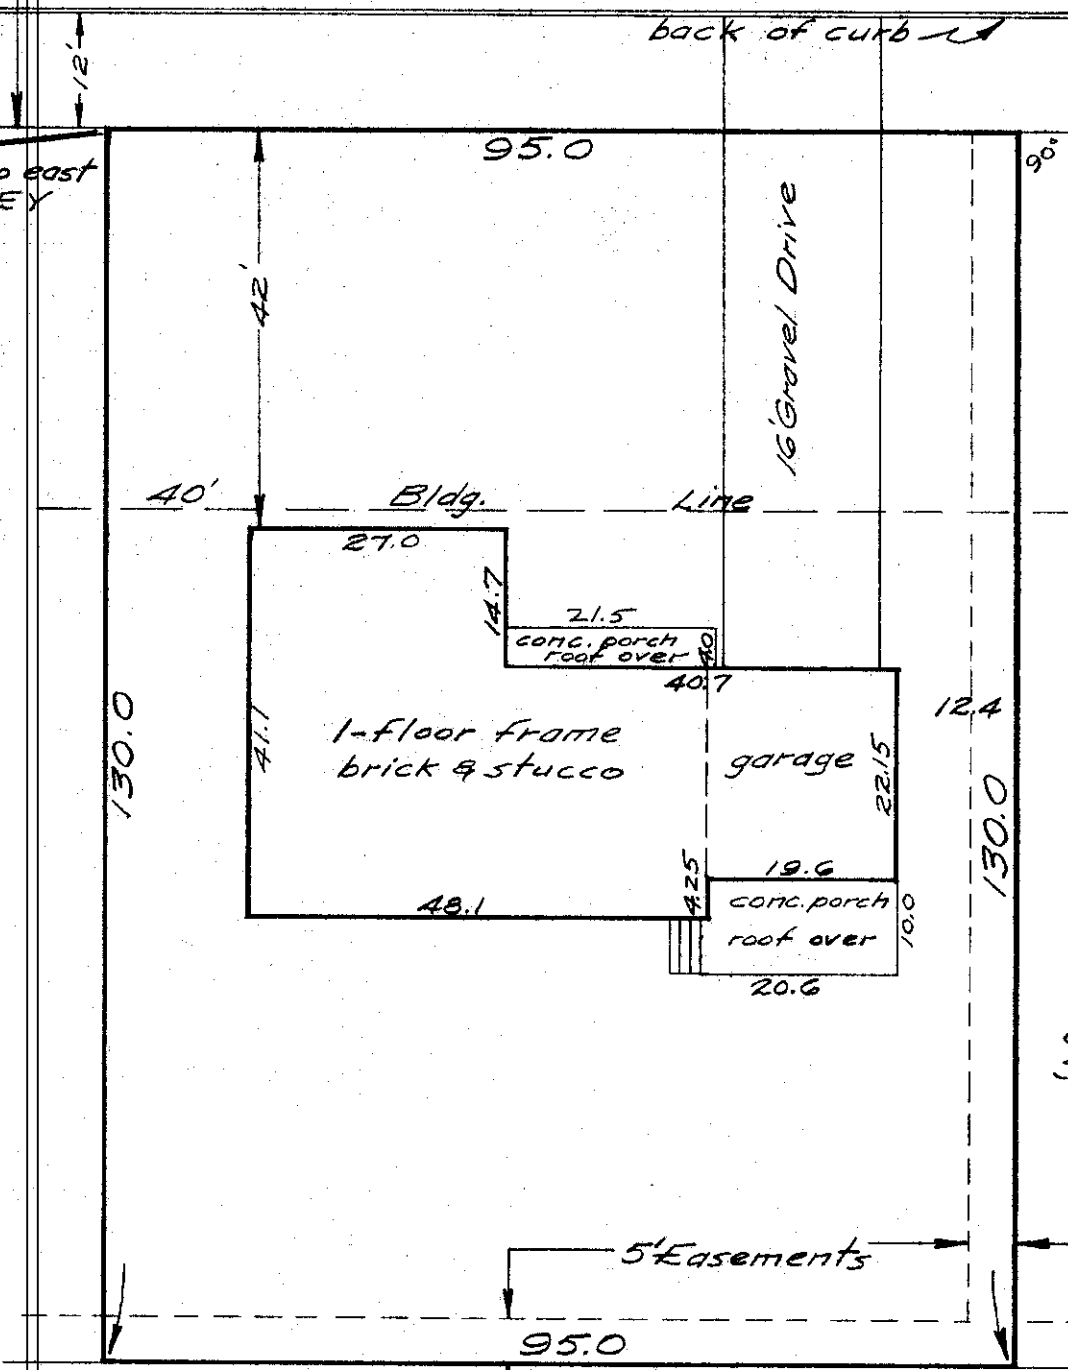

July 9, 1959
Scale 1" = 20'

09-07-59A

1375 FRIAR LANE
City of Upper Arlington, Franklin County, Ohio.
Galbreath Mortgage Company.
Re: John F. & Mary T. Moyer.

~ BLUE PRINT SURVEY ~
I hereby certify that I have prepared the above plat from survey and inspection of herein described premises and existing conditions are as shown above. Being Lot No. 96 of WESTWOOD ACRES, of record in Plat Book No. 28, page 50A, Recorder's Office, Franklin County, Ohio.

Harry L. Greene, Reg. Surveyor - No. 4053.