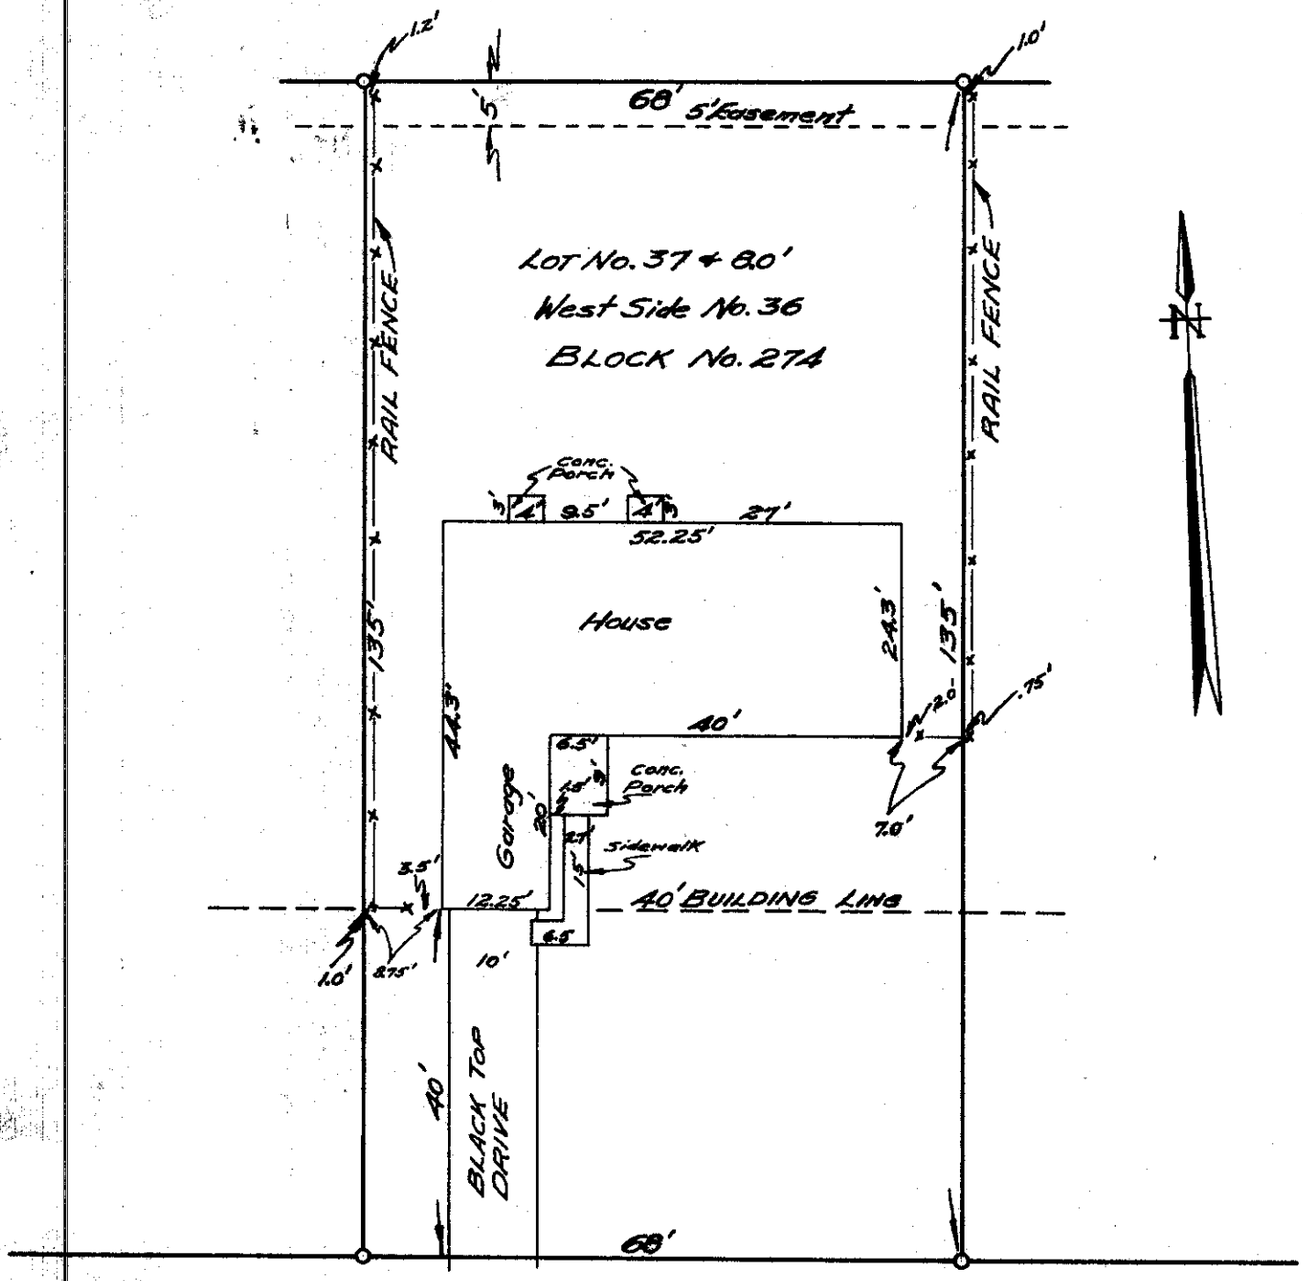

40'

℄ ZOLLINGER ROAD

40'

I hereby certify that I have surveyed and staked the premises shown above, Known as 2014 ZOLLINGER ROAD and being LOT No. 37 and 8.0' off of the West Side of LOT No. 36, NORTH MOUNTVIEW ADDITION, City of Upper Arlington, Franklin County, Ohio, and that said survey is correct.

Harry L. Greene

Harry L. Greene Reg. Surveyor No. 4059

To: Northwestern Mutual Life Insurance Co. Re: Robert G. Youngquist

Mar. 16, 1955 SCALE 1" = 20'

16-03-55