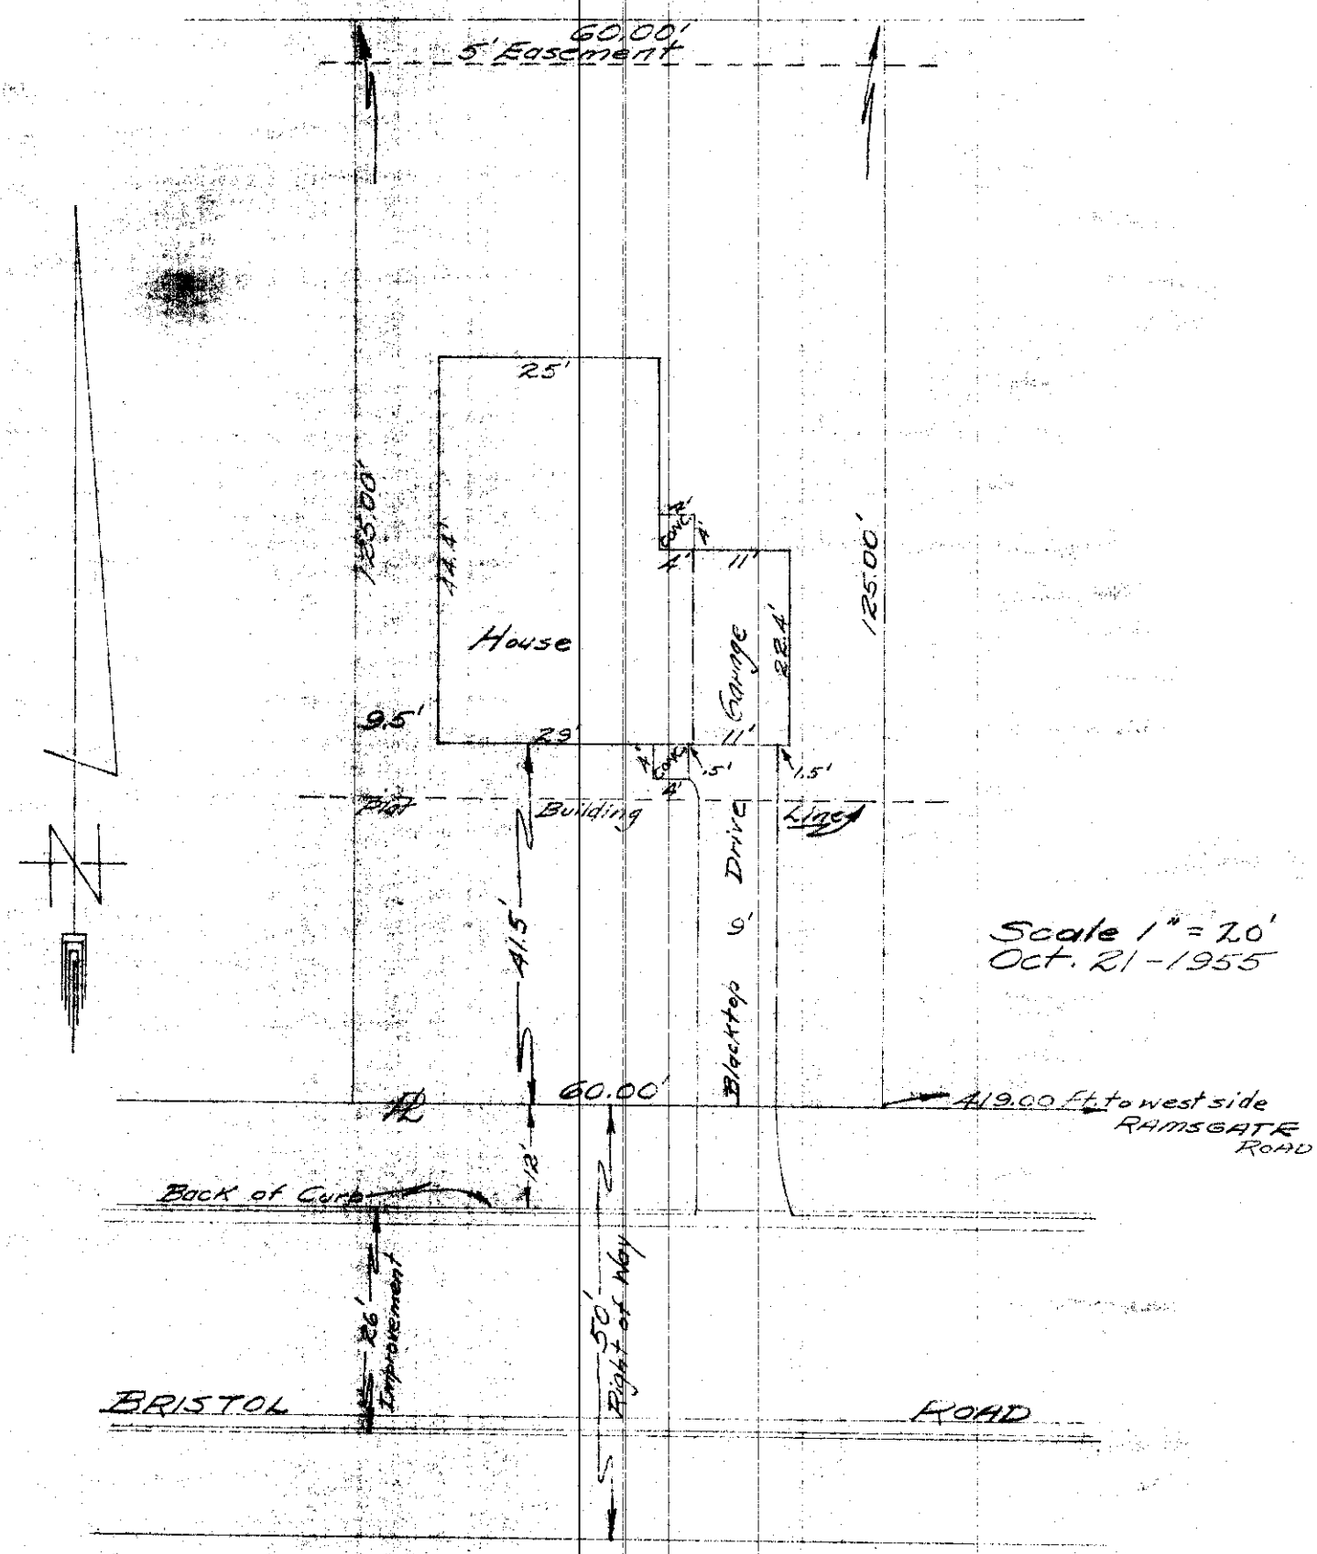

2358 BRISTOL ROAD
City of Upper Arlington Ohio
Re: John E. + Patricia L. Selby
John Hancock Mutual Life Ins. Co.
- Blue Print Survey -

Being 20 ft. of the east side Lot No. 30 + Lot No. 29 except 10 ft. of the east side thereof; Block B Amended Plat Country Homes Addition, Plat Book 22, Page 29, Recorder's Office, Franklin County, Ohio.

The building + driveway shown on the above property are wholly within the boundary lines of the property; No Exceptions.

Harry L. Greene

21-10-55