2341 EDGEVALE ROAD
City of Upper Arlington, Franklin County, Ohio
Re: Fred L. Martin
Ohio National Life Insurance Company
—Blue Print Survey—
Being Lot No. 12, excepting 40 ft. off the West side thereof and all of Lot No. 13, Block "B", Country Homes Addition Amended, Plat Book 22, page 29, Recorder's Office, Franklin County, Ohio. The building & driveway shown on the above property are wholly within the boundary lines of the property. No exceptions.

Harry L. Greene
Harry L. Greene Reg. Surveyor No. 4058

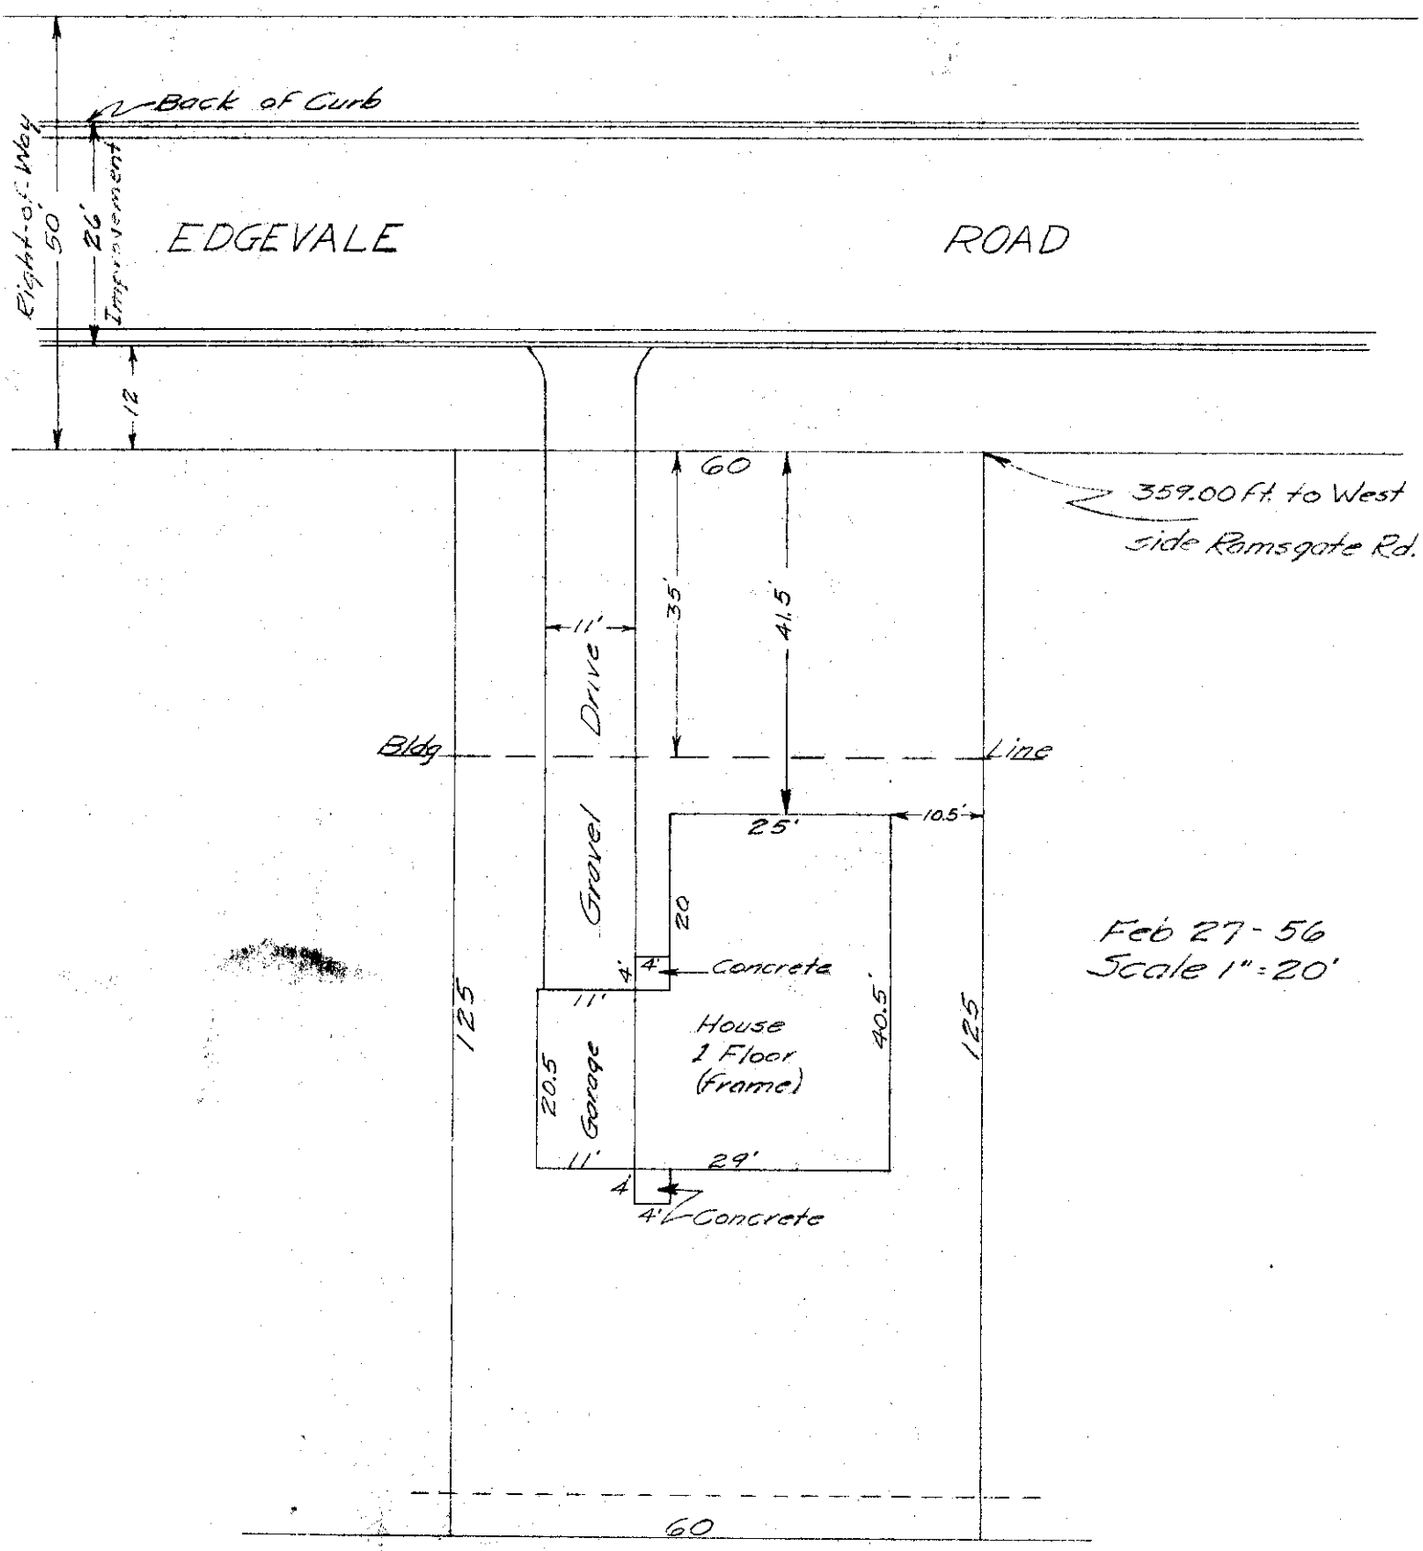

Feb 27-56
Scale 1" = 20'

27-02-56B