265 S

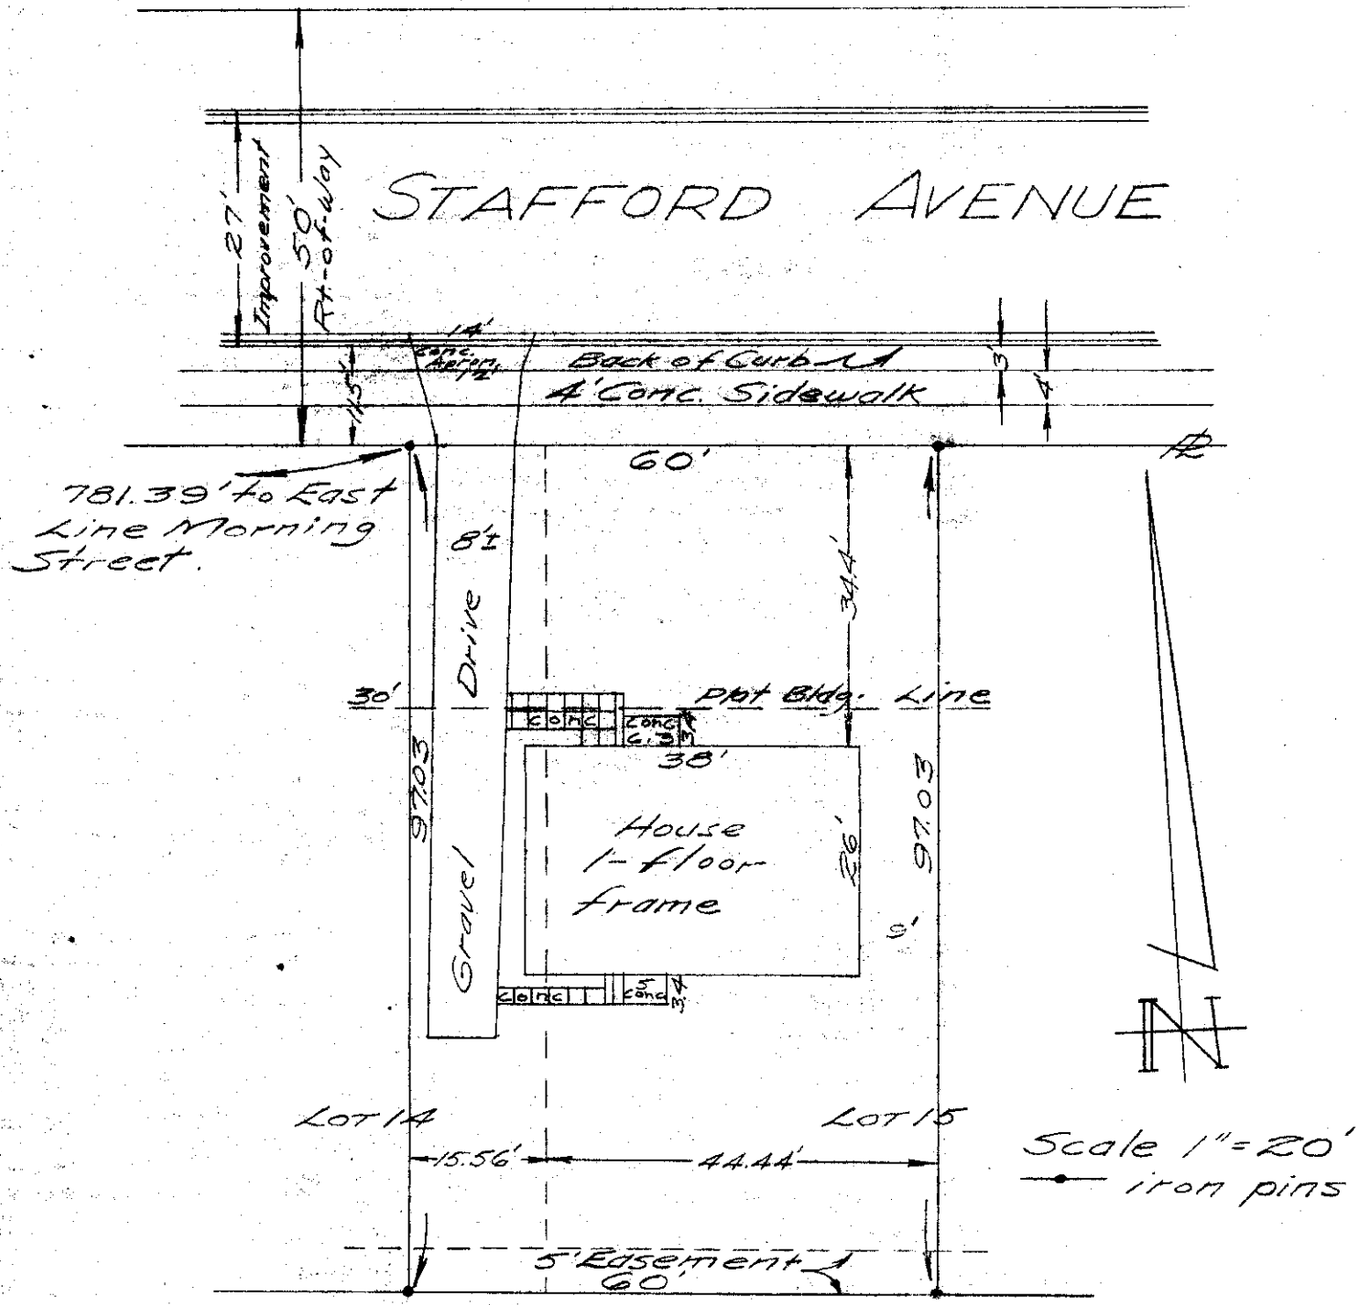

265 STAFFORD AVENUE
City of Worthington, Franklin County, Ohio.
For—
Ref:

~ Blue Print Survey ~

Being 15.56 ft. off East Side Lot 14 and 44.44 ft. off West Side of Lot 15, of Amended Plat of Lots 1, 2, 3, 4, 5 part of Lot 6 of Fuller & Riley's Addition To The Village of Worthington, Ohio, of Record in Plat Book 27, page 55, Recorders Office, Franklin County, Ohio.
The building & drive shown on the above drawing are wholly within the boundary lines of said Lot. At date of this survey, no encroachments exist.

Harry L. Greene May 8, 1957 8-05-57 S
Harry L. Greene - Reg. Surveyor No. 4058