


CLUBVIEW BOULEVARD 60'R/W
33' Improvement

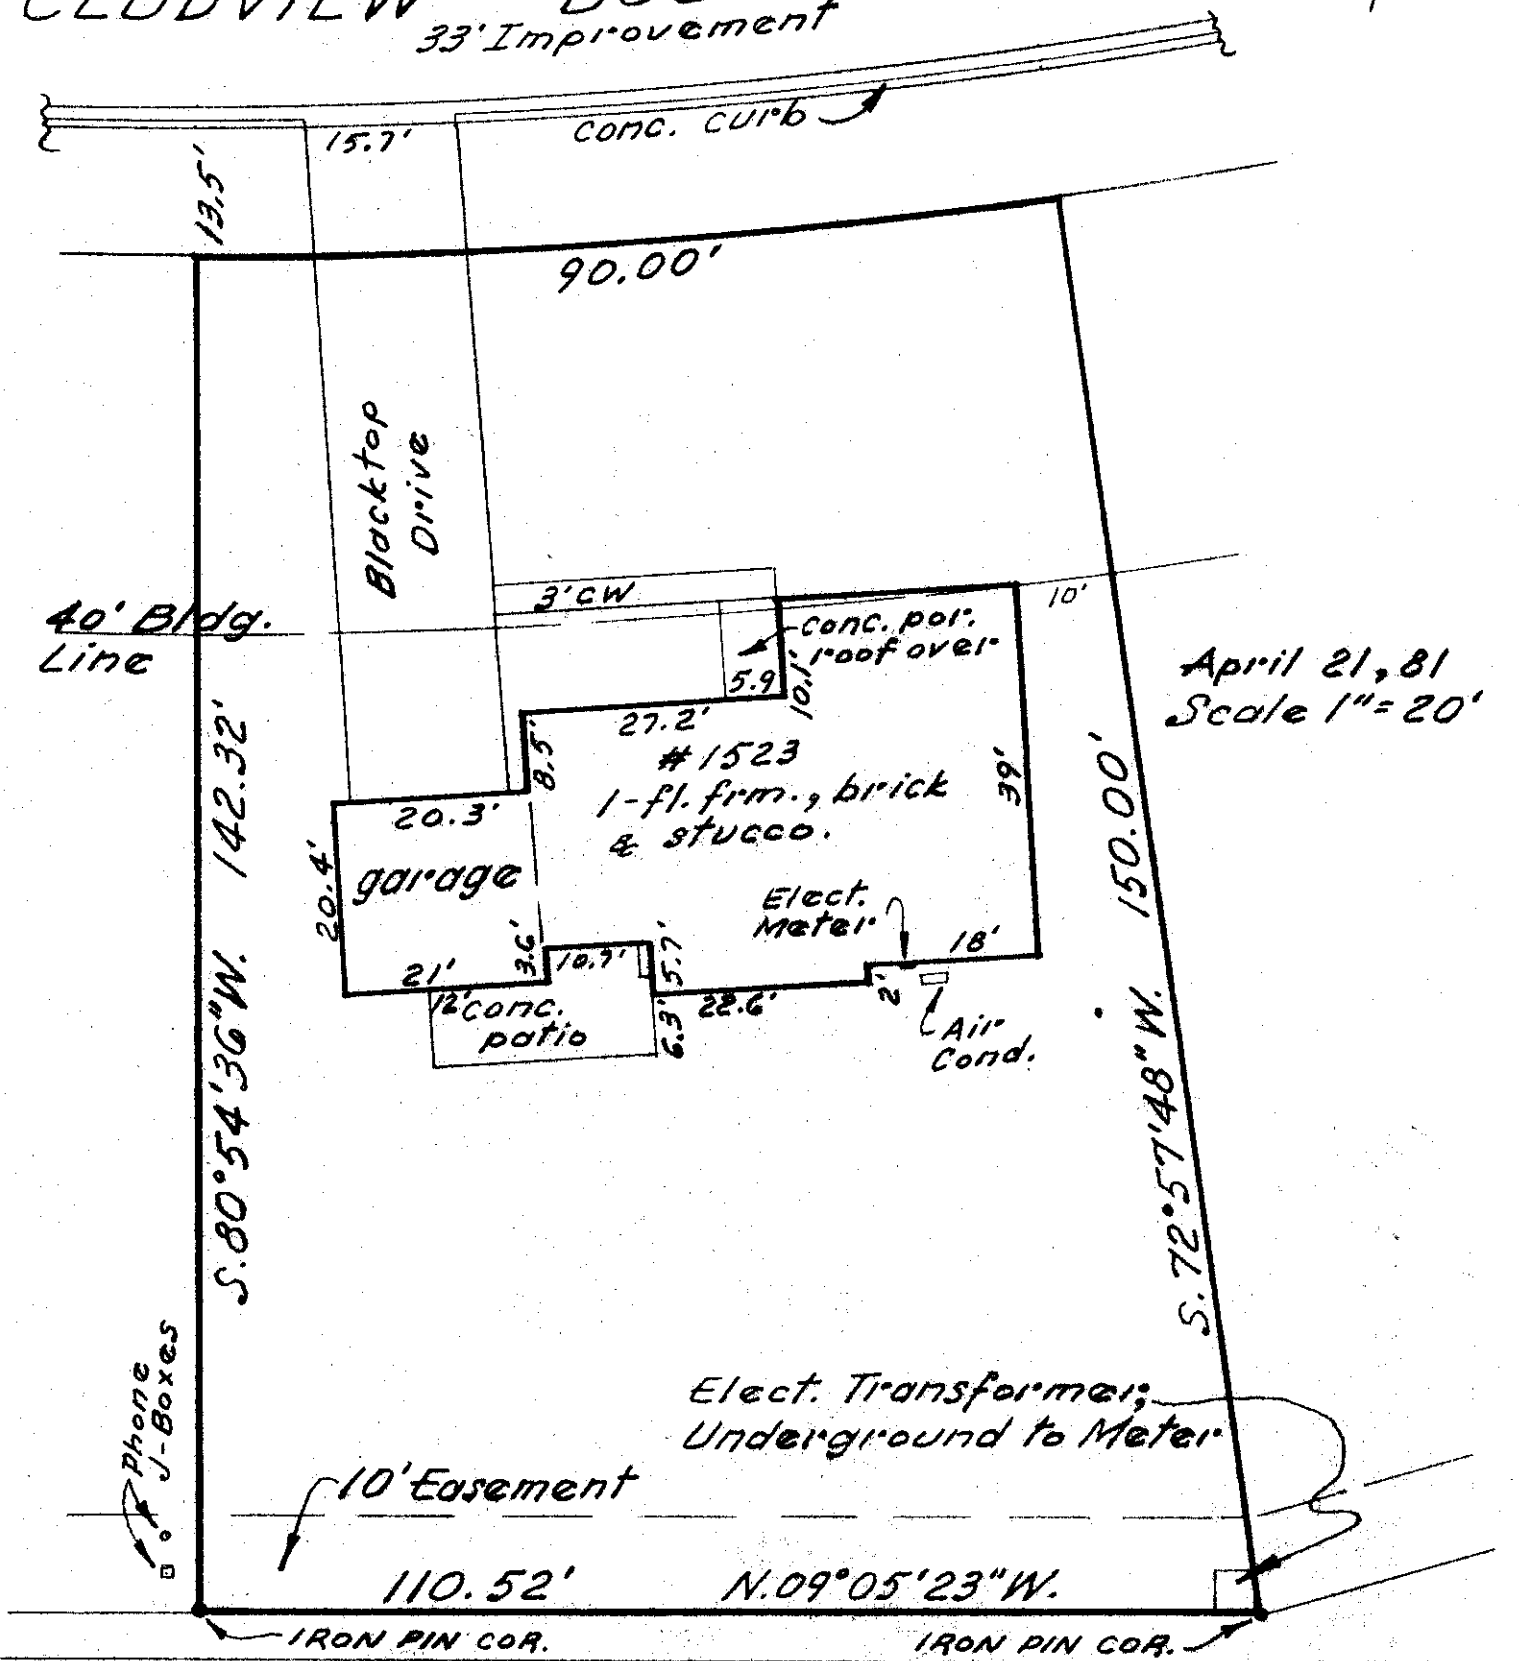

April 21, 81
Scale 1" = 20'

1523 CLUBVIEW BOULEVARD
Perry Township, Franklin County, Ohio.
T.C. GRAHAM BLDG'S.
Re: Ralph Ring.

~ Blue Print Survey ~

I hereby certify that I have prepared the above plat from survey and inspection of herein described premises and existing conditions are as shown above. Being LOT 320 of WORTHINGTON HILLS NO. 2, of record in Plat Book 36, Pgs. 76-77, Recorder's Office, Franklin County, Ohio.

Harry L. Greene

Harry L. Greene, Reg. Surveyor - 4058.