


Harry L. Greene, Surveyor

2160 Tremont Center, Columbus, Ohio 43221

To: Diamond Savings & Loan Company
Re: Jeffrey G. & Kathleen Swarts
Being Lot No. 88 of York Place No. 3, of record in Plat Book 43,
Page 104, Recorders Office, Franklin County, Ohio.

PB. 43 Page 104 Recorders Office, FRANKLIN County, Ohio.
Scale 1" = 20' Date MAY 19, 1982

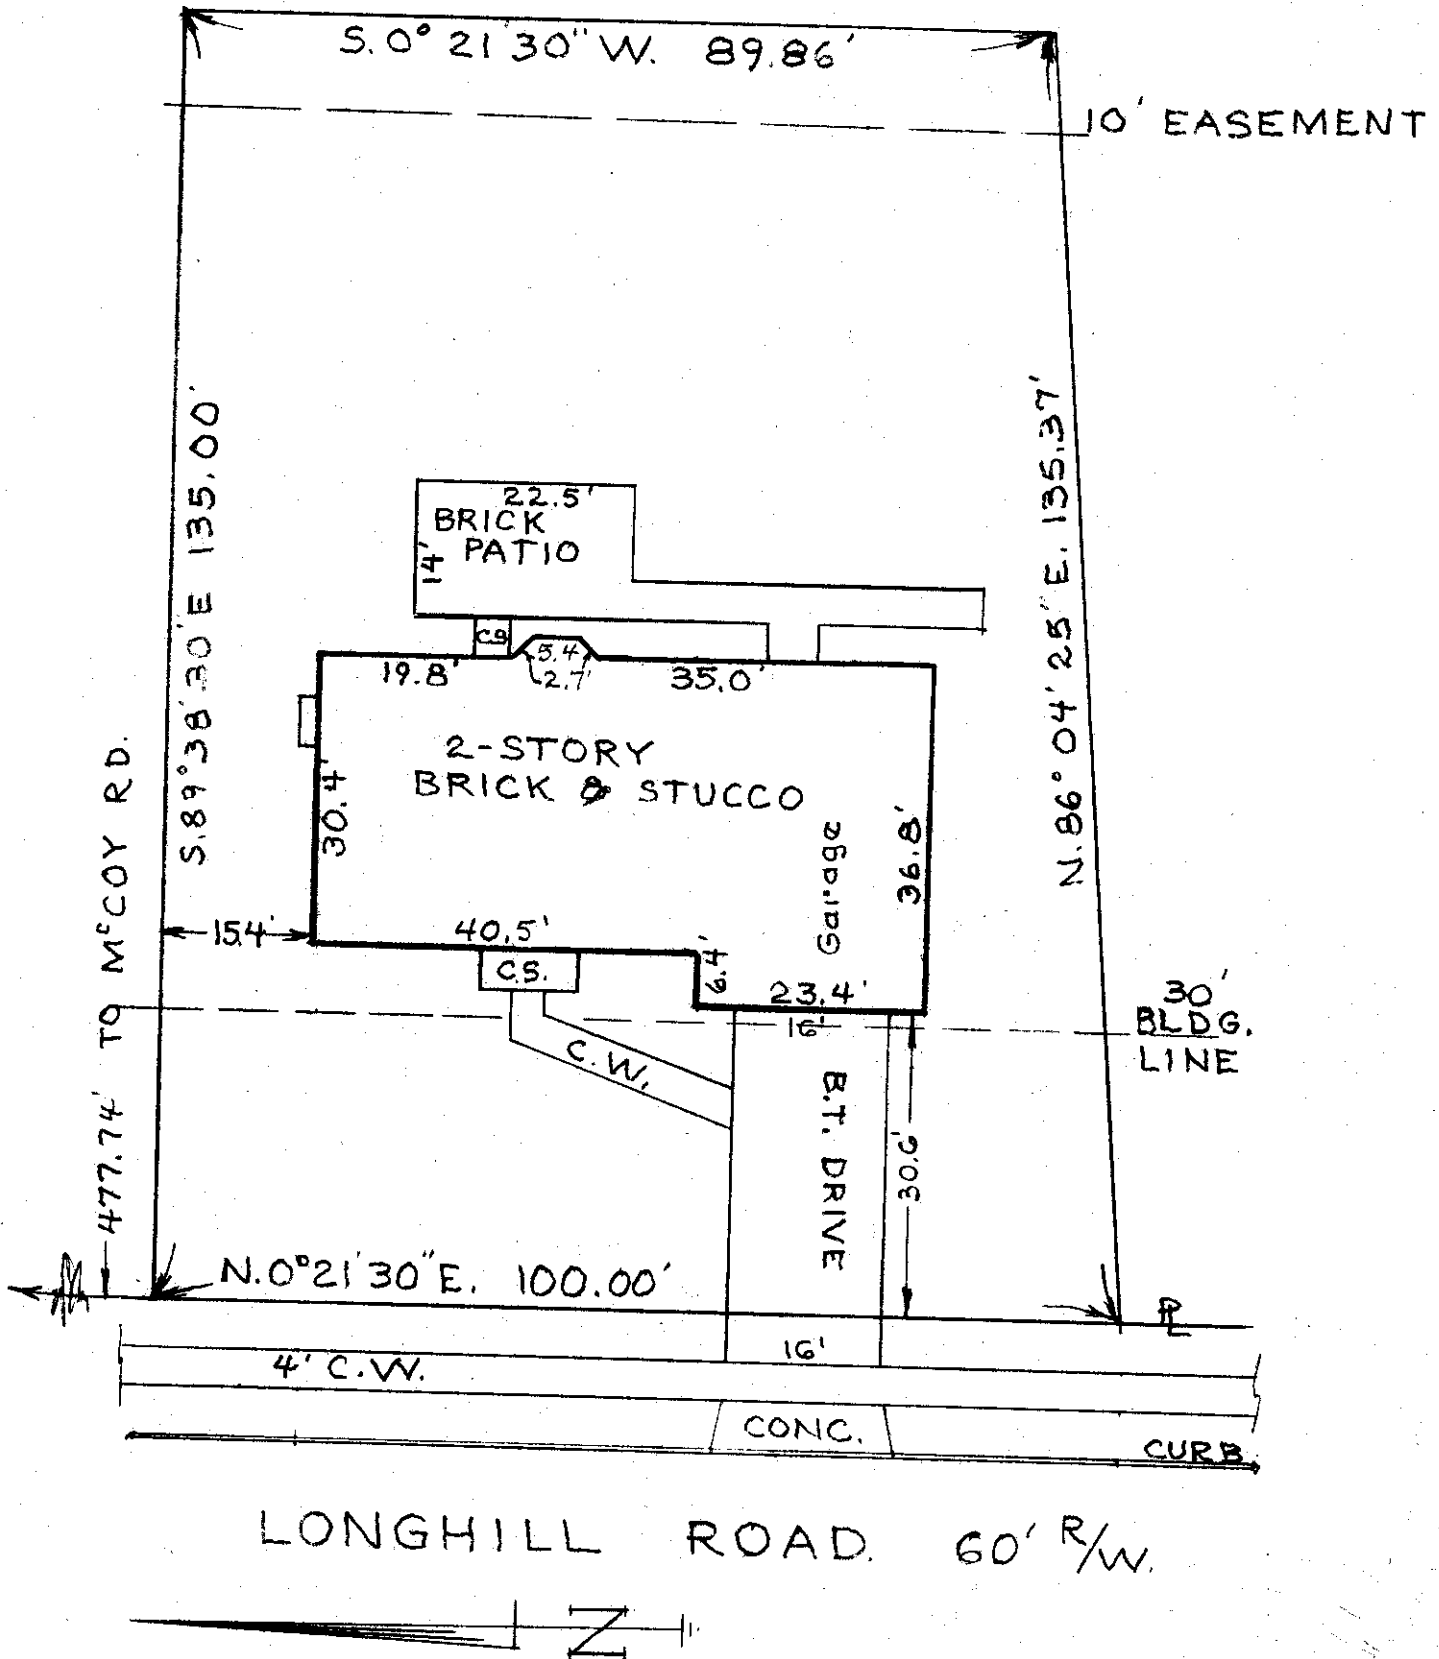

I hereby certify the above plat has been prepared from actual survey of the premises for use in mortgage loan and title purposes only. No sideline of principal building is less than dimension shown. Property corners not located unless shown thus -o-.

Harry L. Greene
Harry L. Greene, Registered Surveyor, No. 4058