

# Harry L. Greene, Surveyor


2160 Tremont Center, Columbus, Ohio 43221

For: Diamond Savings and Loan Company  
Re: Andrew J. & Kathy J. Zakrajsek

Lot No. 52, GABLES EAST, City of Columbus, Ohio. (1167 Slade Ave.,)

PB. 42 Page 94-95 Recorders Office, Franklin County, Ohio.  
Scale 1" = 20' Date June 4, 1982

SLADE AVE. 50'

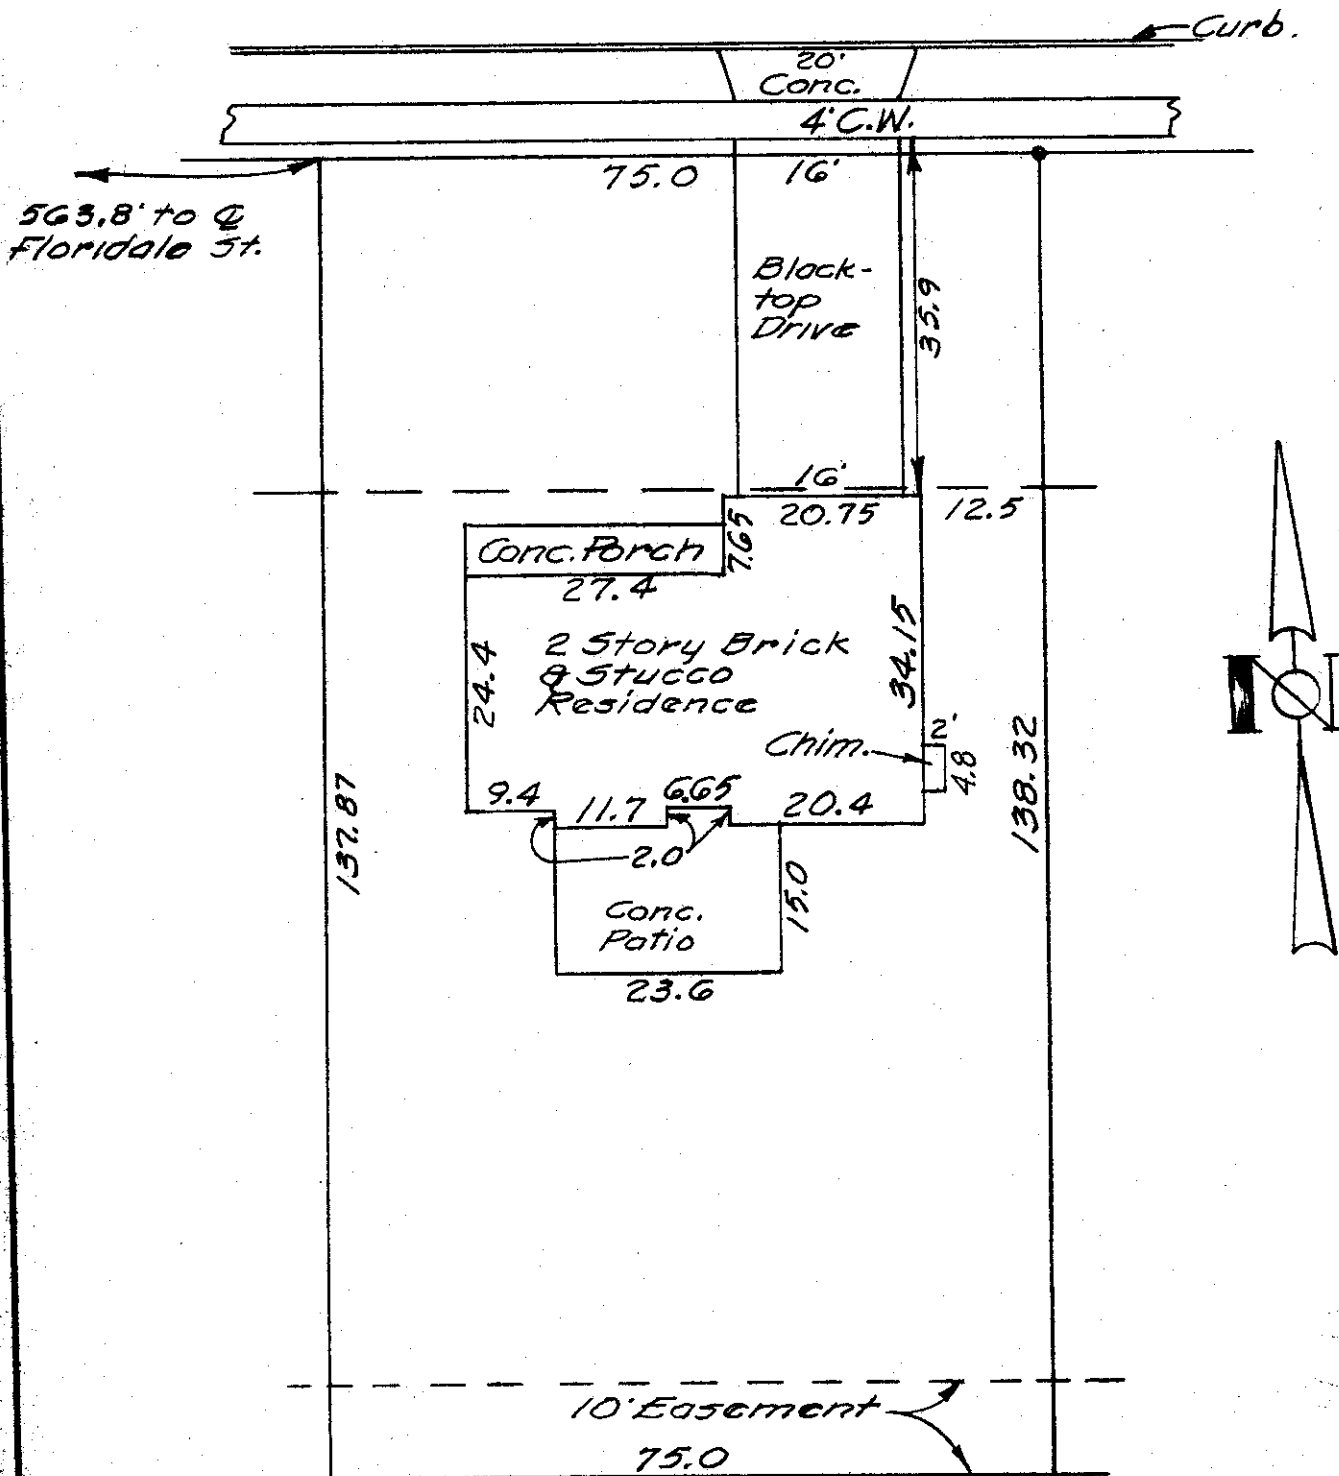

I hereby certify the above plat has been prepared from actual survey of the premises for use in mortgage loan and title purposes only. No sideline of principal building is less than dimension shown. Property corners not located unless shown thus -o-.

*Harry L. Greene*  
Harry L. Greene, Registered Surveyor, No. 4058