

Harry L. Greene, Surveyor


2160 Tremont Center, Columbus, Ohio 43221

BLUE PRINT SURVEY Re: Phyllis K. Showe
To: BancOhio National Bank
Lawyers Title Insurance Corporation
TransOhio Title Agency, Inc.

Being Lot Number 291 of DENNISON SUMMIT ADDITION, as the same is numbered and delineated upon the recorded plat thereof, of record in Plat Book 7, page 172 Recorder's Office, Franklin County, Ohio. (150 E. 13th Ave., Columbus, Ohio)

P.B. 7 Page 172 Recorder's Office, Franklin County, Ohio.

Scale 1" = 20' Date June 14, 1983

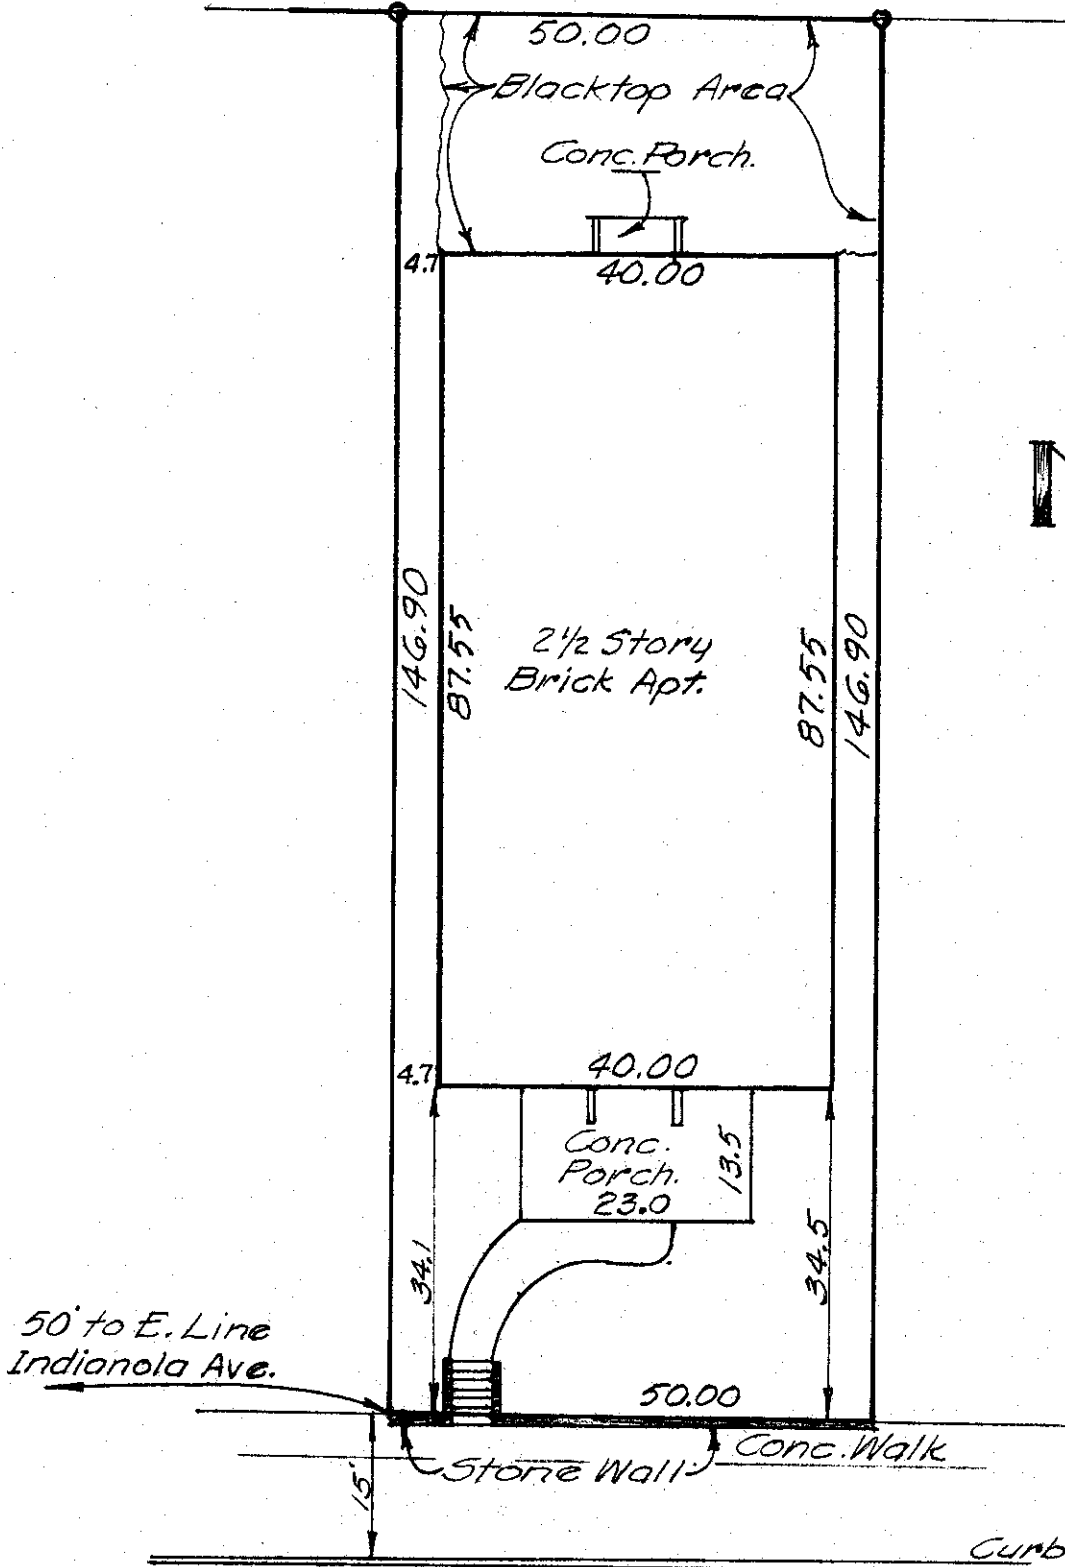

13TH. AVE. 60'

I hereby certify the above plat has been prepared from actual survey of the premises for use in mortgage loan and title purposes only. No sideline of principal building is less than dimension shown. Property corners not located unless shown thus -o-.

Harry L. Greene
Harry L. Greene, Registered Surveyor, No. 4058

