


Harry L. Greene, Surveyor

2160 Tremont Center, Columbus, Ohio 43221

PLAT SHOWING SURVEY OF LOT NO. 65, OF MARBURN, A SUBDIVISION IN THE CITY OF COLUMBUS, OHIO, OF RECORD IN PLAT BOOK 19, PAGE 24, RECORDER'S OFFICE FRANKLIN COUNTY, OHIO.

For: Duane & Annie Tolle

PB. 19 Page 24 Recorders Office, Franklin County, Ohio.
Scale 1" = 40 Date April 8, 1983.

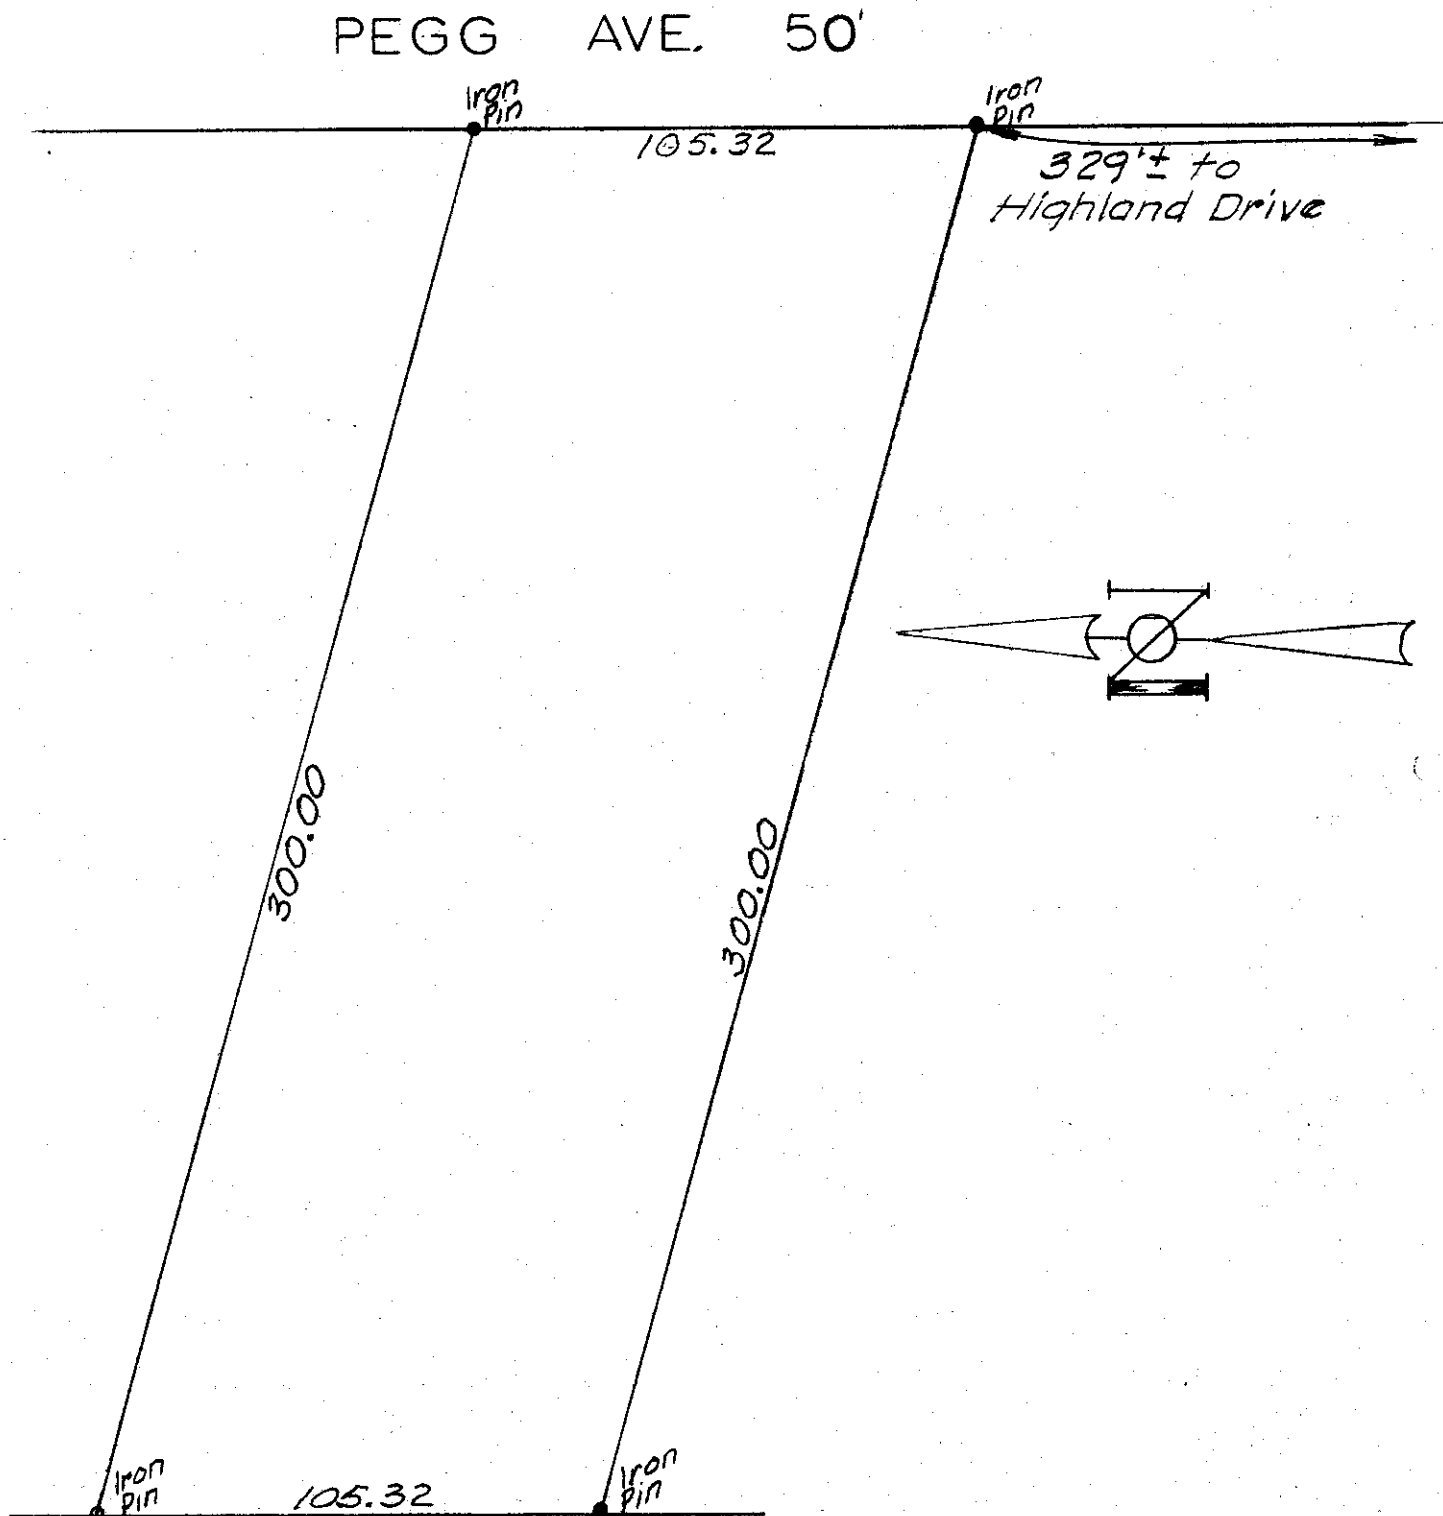

I hereby certify the above plat has been prepared from actual survey of the premises for use in mortgage loan and title purposes only. No sideline of principal building is less than dimension shown. Property corners not located unless shown thus -o-.

Harry L. Greene
Harry L. Greene, Registered Surveyor, No. 4058