

Harry L. Greene, Surveyor

2160 Tremont Center, Columbus, Ohio 43221


PLAT SHOWING SURVEY OF PART OF LOT NO. 7, AND PART OF LOT NO. 8, OLD COACH SQUARE AMENDED, CITY OF UPPER ARLINGTON, OHIO, OF RECORD IN PLAT BOOK 50, PAGE 41, RECORDER'S OFFICE, FRANKLIN COUNTY, OHIO. Being 2073 & 2077 Mackenzie Dr.

For.

Mr. Anthony F. Mellica

(See attached legal description)

P.B. 50 Page 41 Recorder's Office, Franklin, County, Ohio.
Scale 1" = 20 Date February 4, 1983

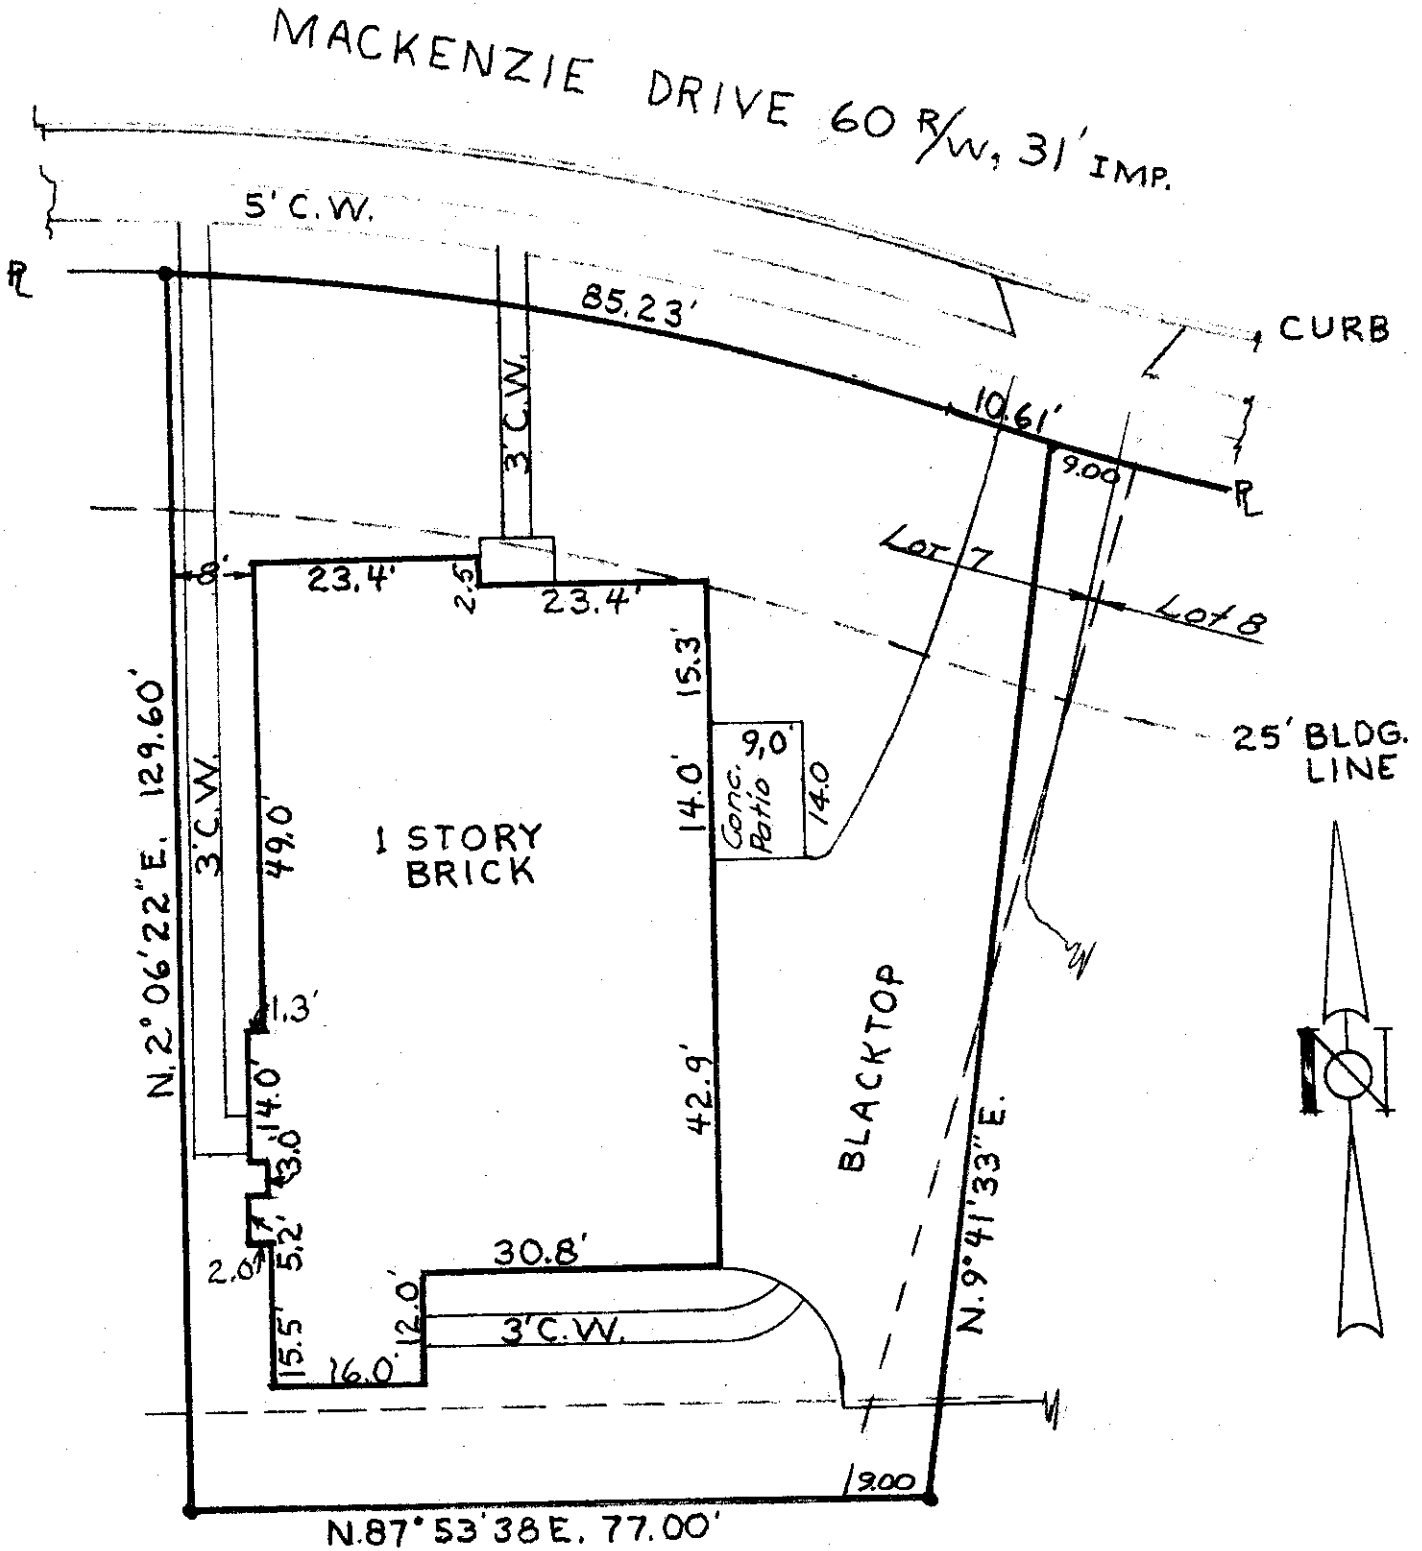

I hereby certify the above plat has been prepared from actual survey of the premises for use in mortgage loan and title purposes only. No sideline of principal building is less than dimension shown. Property corners not located unless shown thus -o-.

Harry L. Greene
Harry L. Greene, Registered Surveyor, No. 4058