


Harry L. Greene, Surveyor

2160 Tremont Center, Columbus, Ohio 43221

PLAT SHOWING SURVEY OF LOTS NOS. 4 & 36 DOBYNS & LATHAMS ADDITION,
CITY OF HILLIARD, OHIO.
For; Roger Reedy, 5089 Norwich Street, Hilliard, Ohio.

PB. 10 Page 258 Recorders Office, Franklin County, Ohio.
Scale 1" = 40 Date September 11, 1984

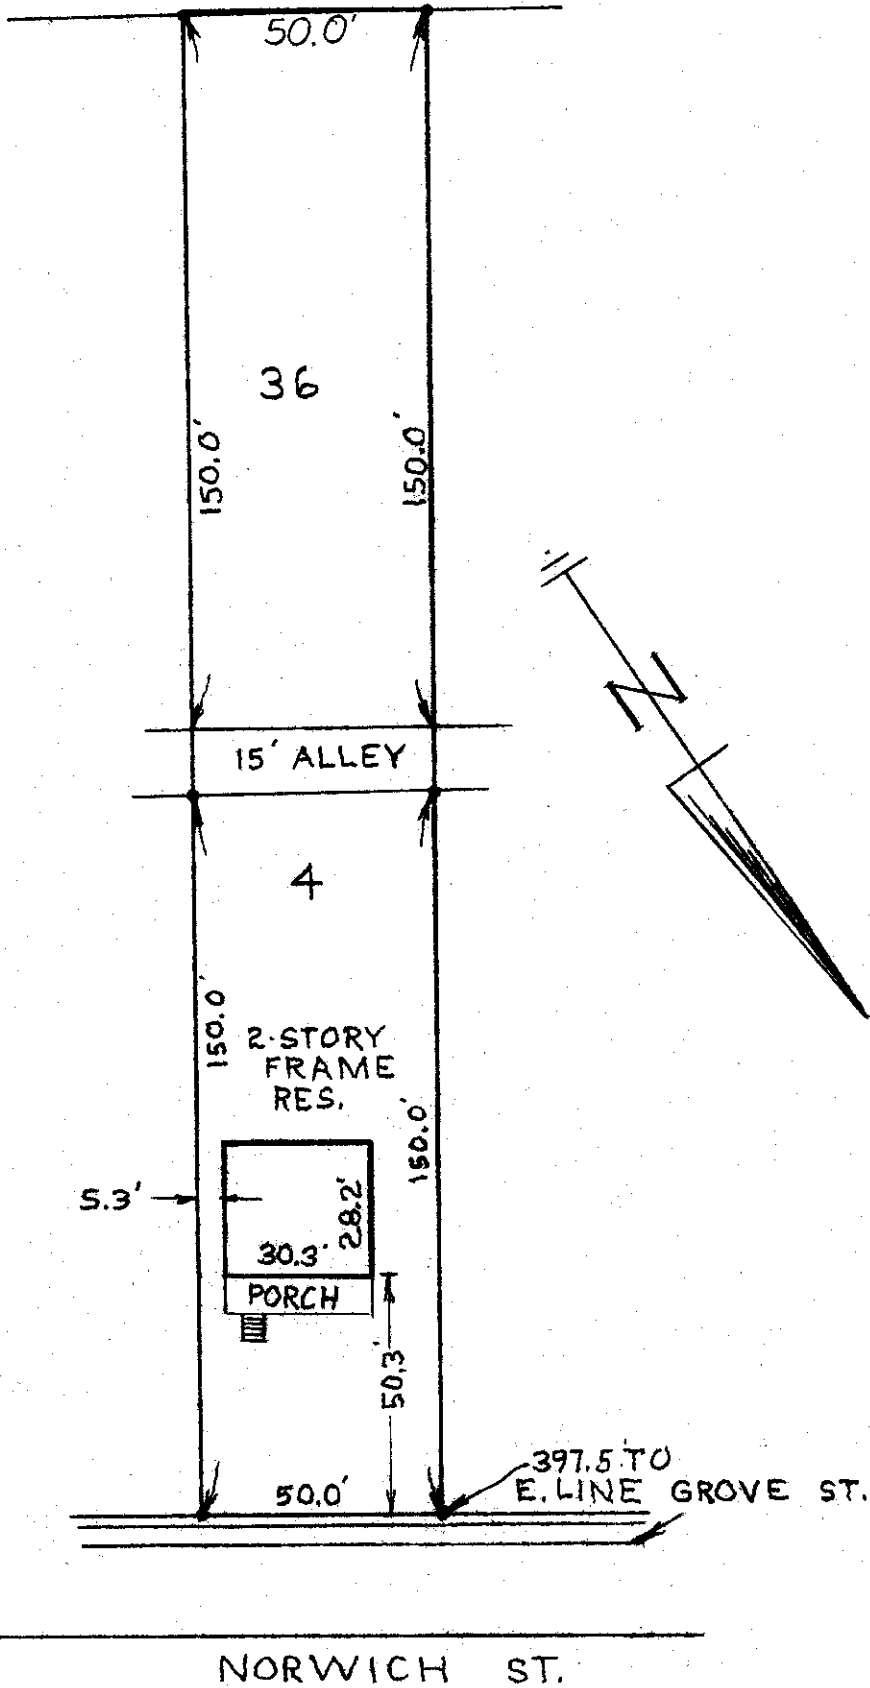

I hereby certify the above plat has been prepared from actual survey of the premises

No sideline of principal building is less than dimension shown. Property corners not located unless shown thus -o-.

Harry L. Greene
Harry L. Greene, Registered Surveyor, No. 4058