

Harry L. Greene, Surveyor


2160 Tremont Center, Columbus, Ohio 43221

PLAT SHOWING SURVEY OF LOTS 19, 20 AND 21, OF MERIBIAN ADDITION, CITY OF COLUMBUS, OHIO.

For:

Mr. James R. Young

P.B. 5 Page 22 Recorders Office, Franklin County, Ohio.
Scale 1" = 20' Date July 20, 1984

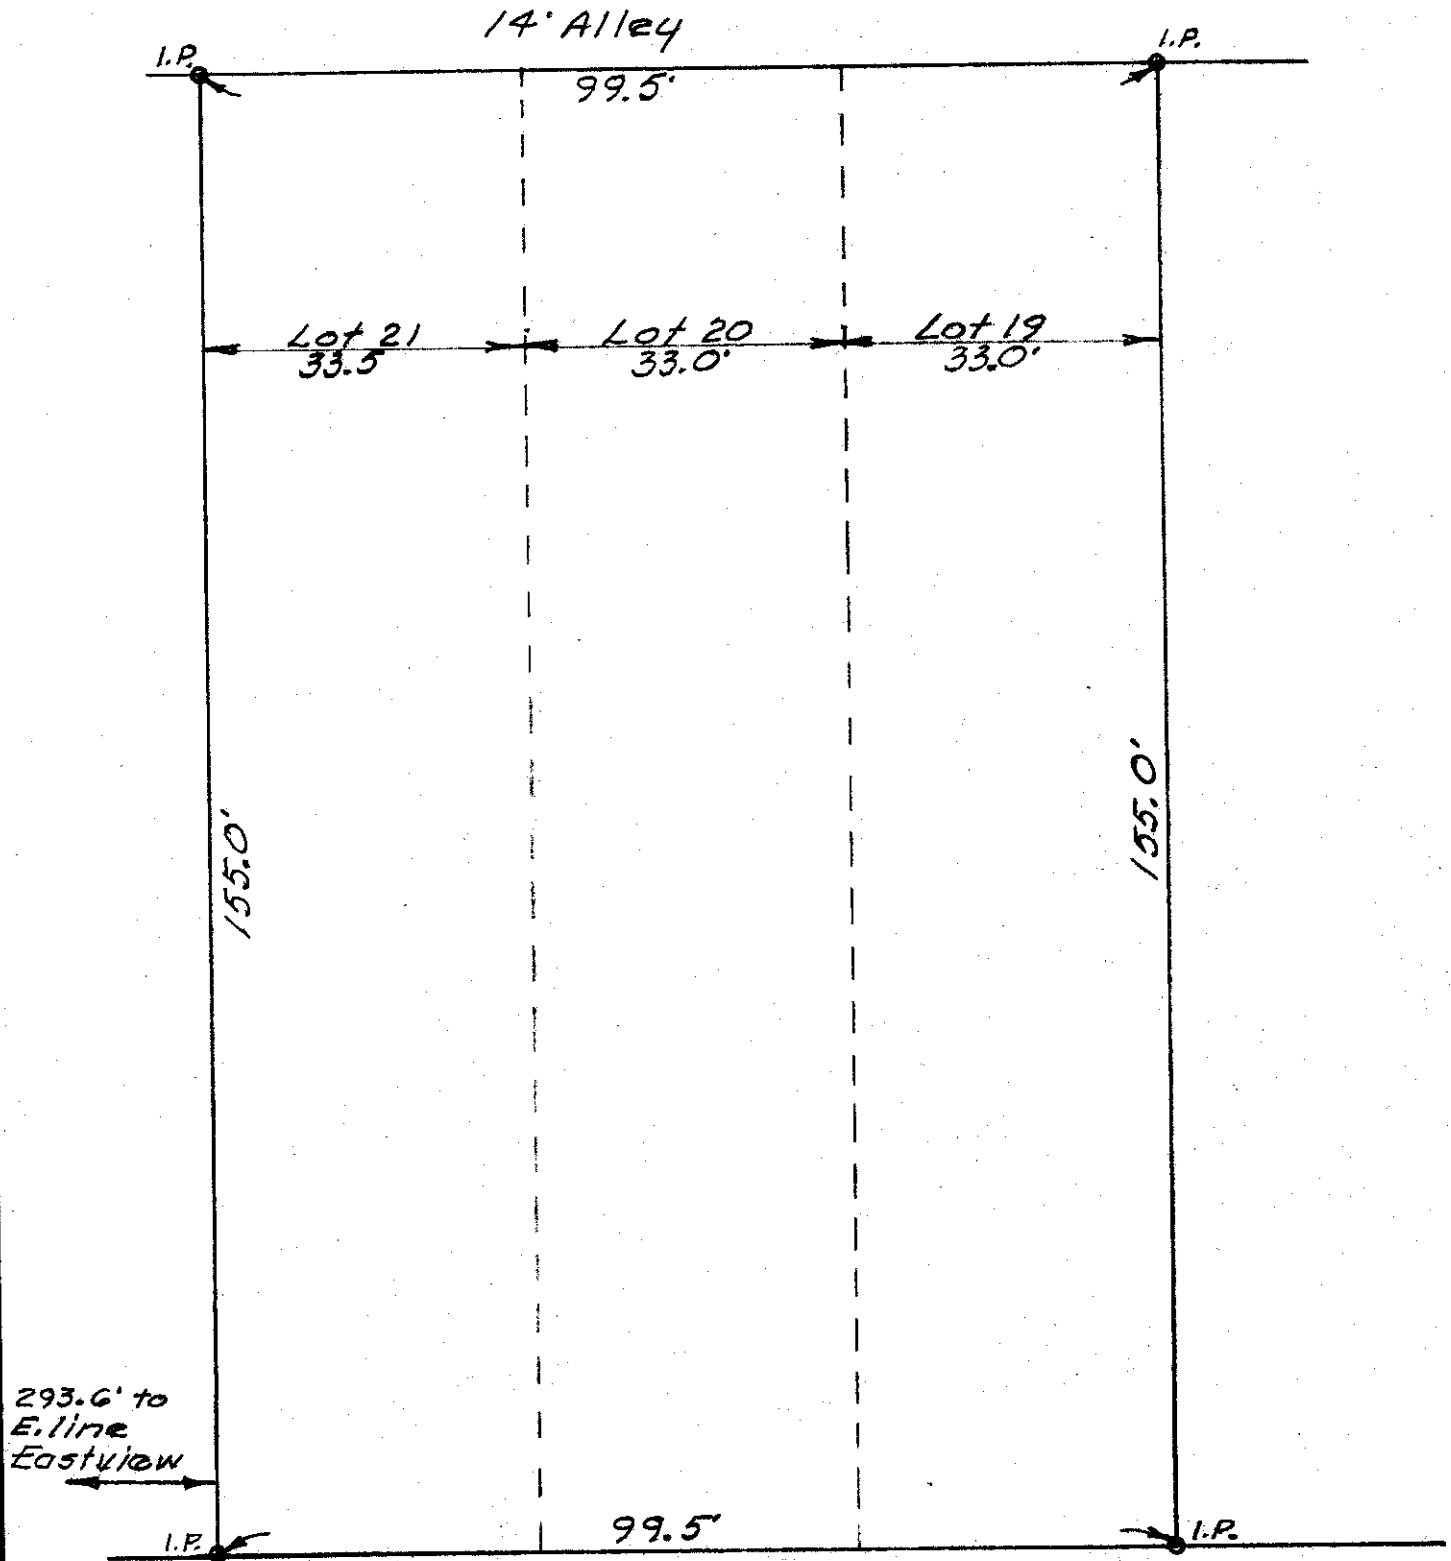

KING AVE 60'

I hereby certify the above plat has been prepared from actual survey of the premises

Harry L. Greene
Harry L. Greene, Registered Surveyor, No. 4058