


# Harry L. Greene, Surveyor

2160 Tremont Center, Columbus, Ohio 43221

For: Chicago Title Insurance Company  
Dollar Savings  
Re. Alfred B. & Gloria P. Jefferson  
4330 Dublin Road Columbus, Ohio  
see Deed attached hereto.

PB. \_\_\_\_\_ Page \_\_\_\_\_ Records Office, Franklin County, Ohio.  
Scale 1" = 30' Date August 6, 1984

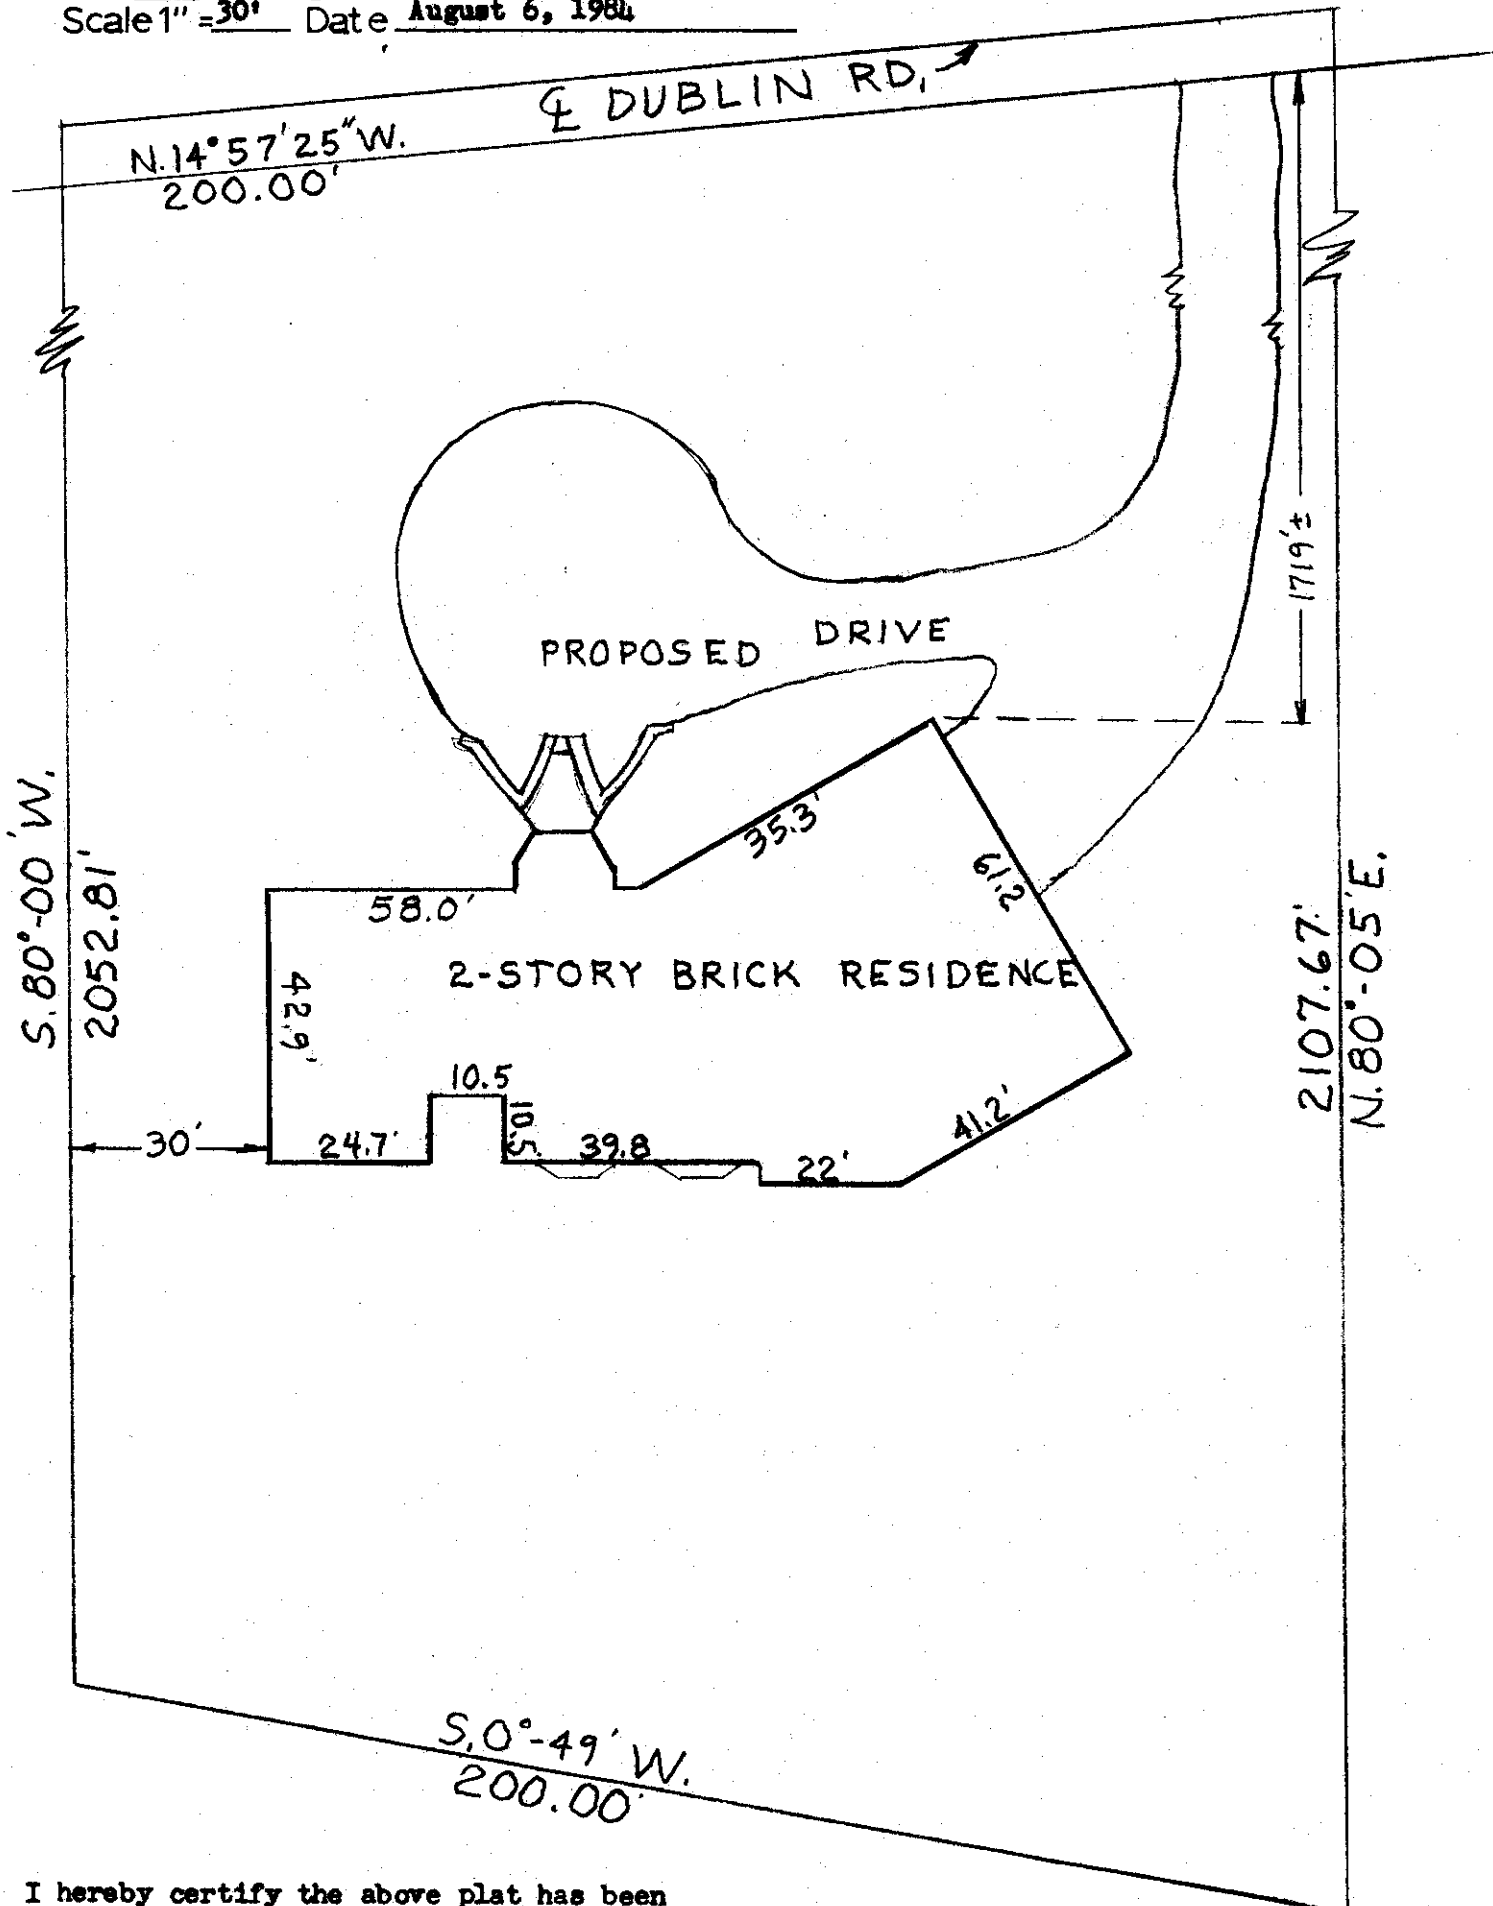

I hereby certify the above plat has been prepared from actual survey of the premises for use in mortgage loan and title purposes only. No sideline of principal building is less than dimension shown. Property corners not located unless shown thus -o-.

*Harry L. Greene*  
Harry L. Greene, Registered Surveyor, No. 4058