Harry L. Greene, Surveyor

2160 Tremont Center, Columbus, Ohio 43221

Map showing the house at 1503 Lincoln Road ,being part of Lot 15 , Lincoln Place Addition.

For MR. Richard J. Eisert

P.B. 12 Page 22 Recorders Office, Franklin County, Ohio.
Scale 1" = 20 Date August 8,1984

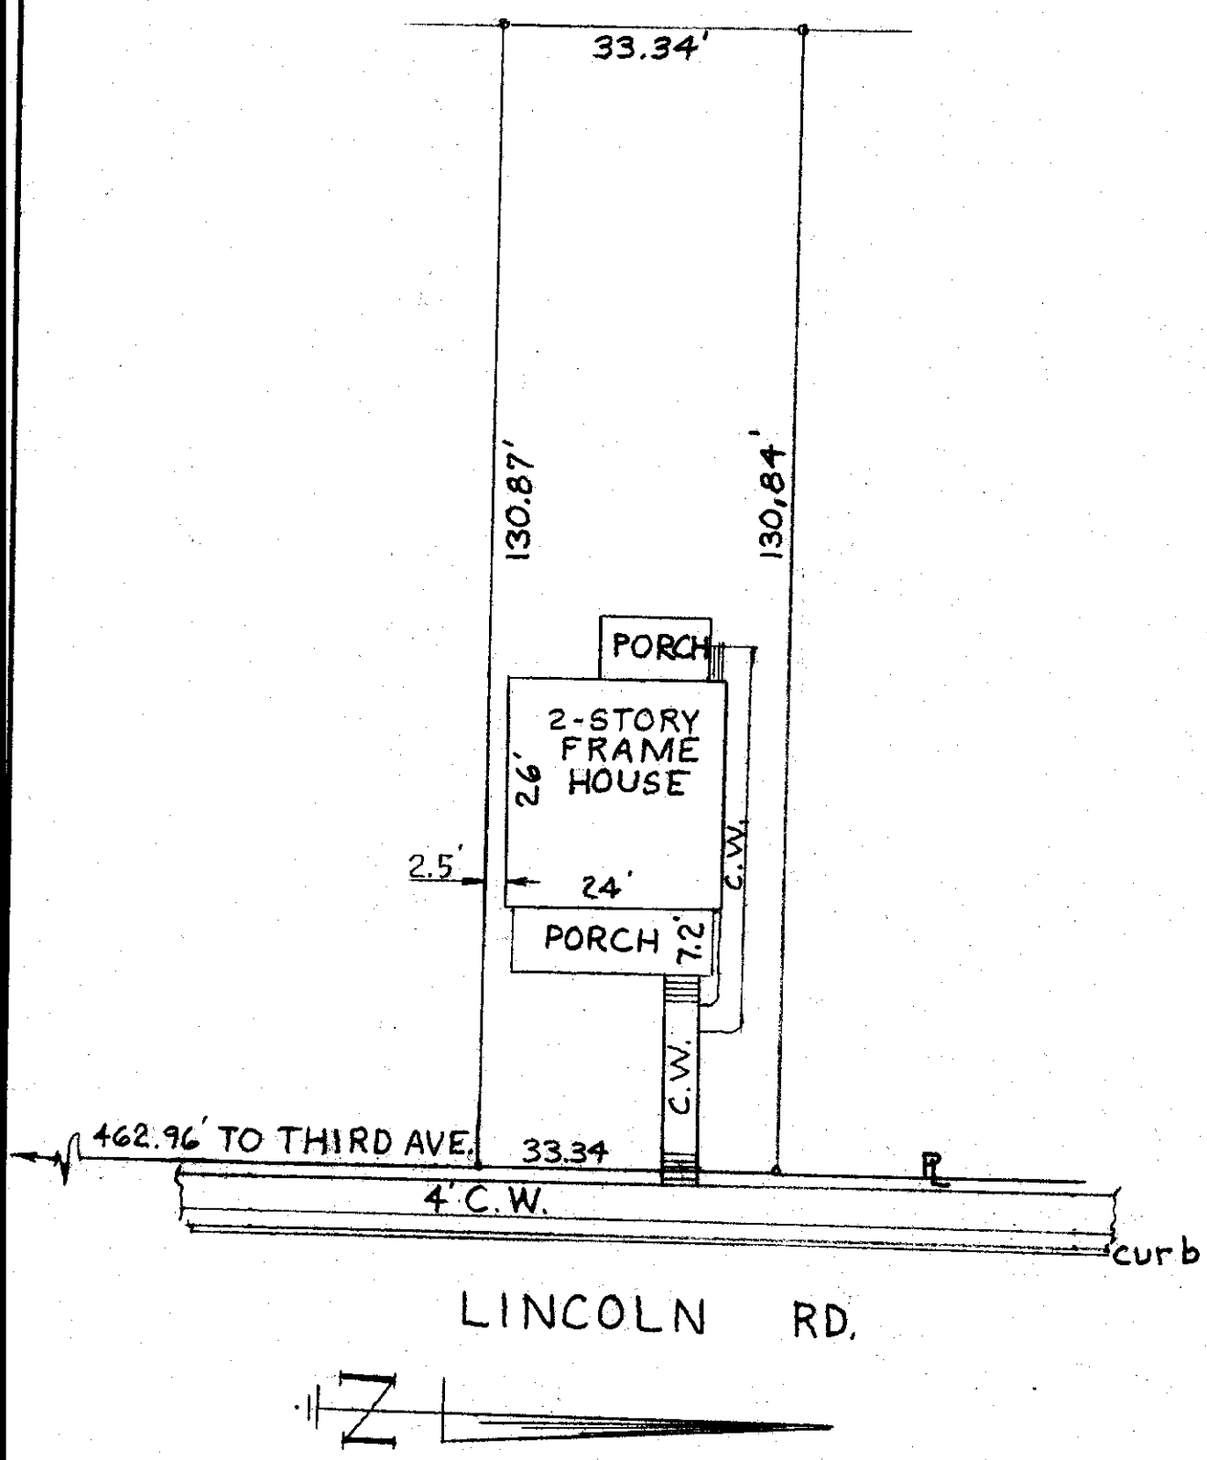

I hereby certify the above plat has been prepared from actual survey of the premises for use in mortgage loan and title purposes only. No sideline of principal building is less than dimension shown. Property corners not located unless shown thus -o-.

Harry L. Greene

Harry L. Greene, Registered Surveyor, No. 4058