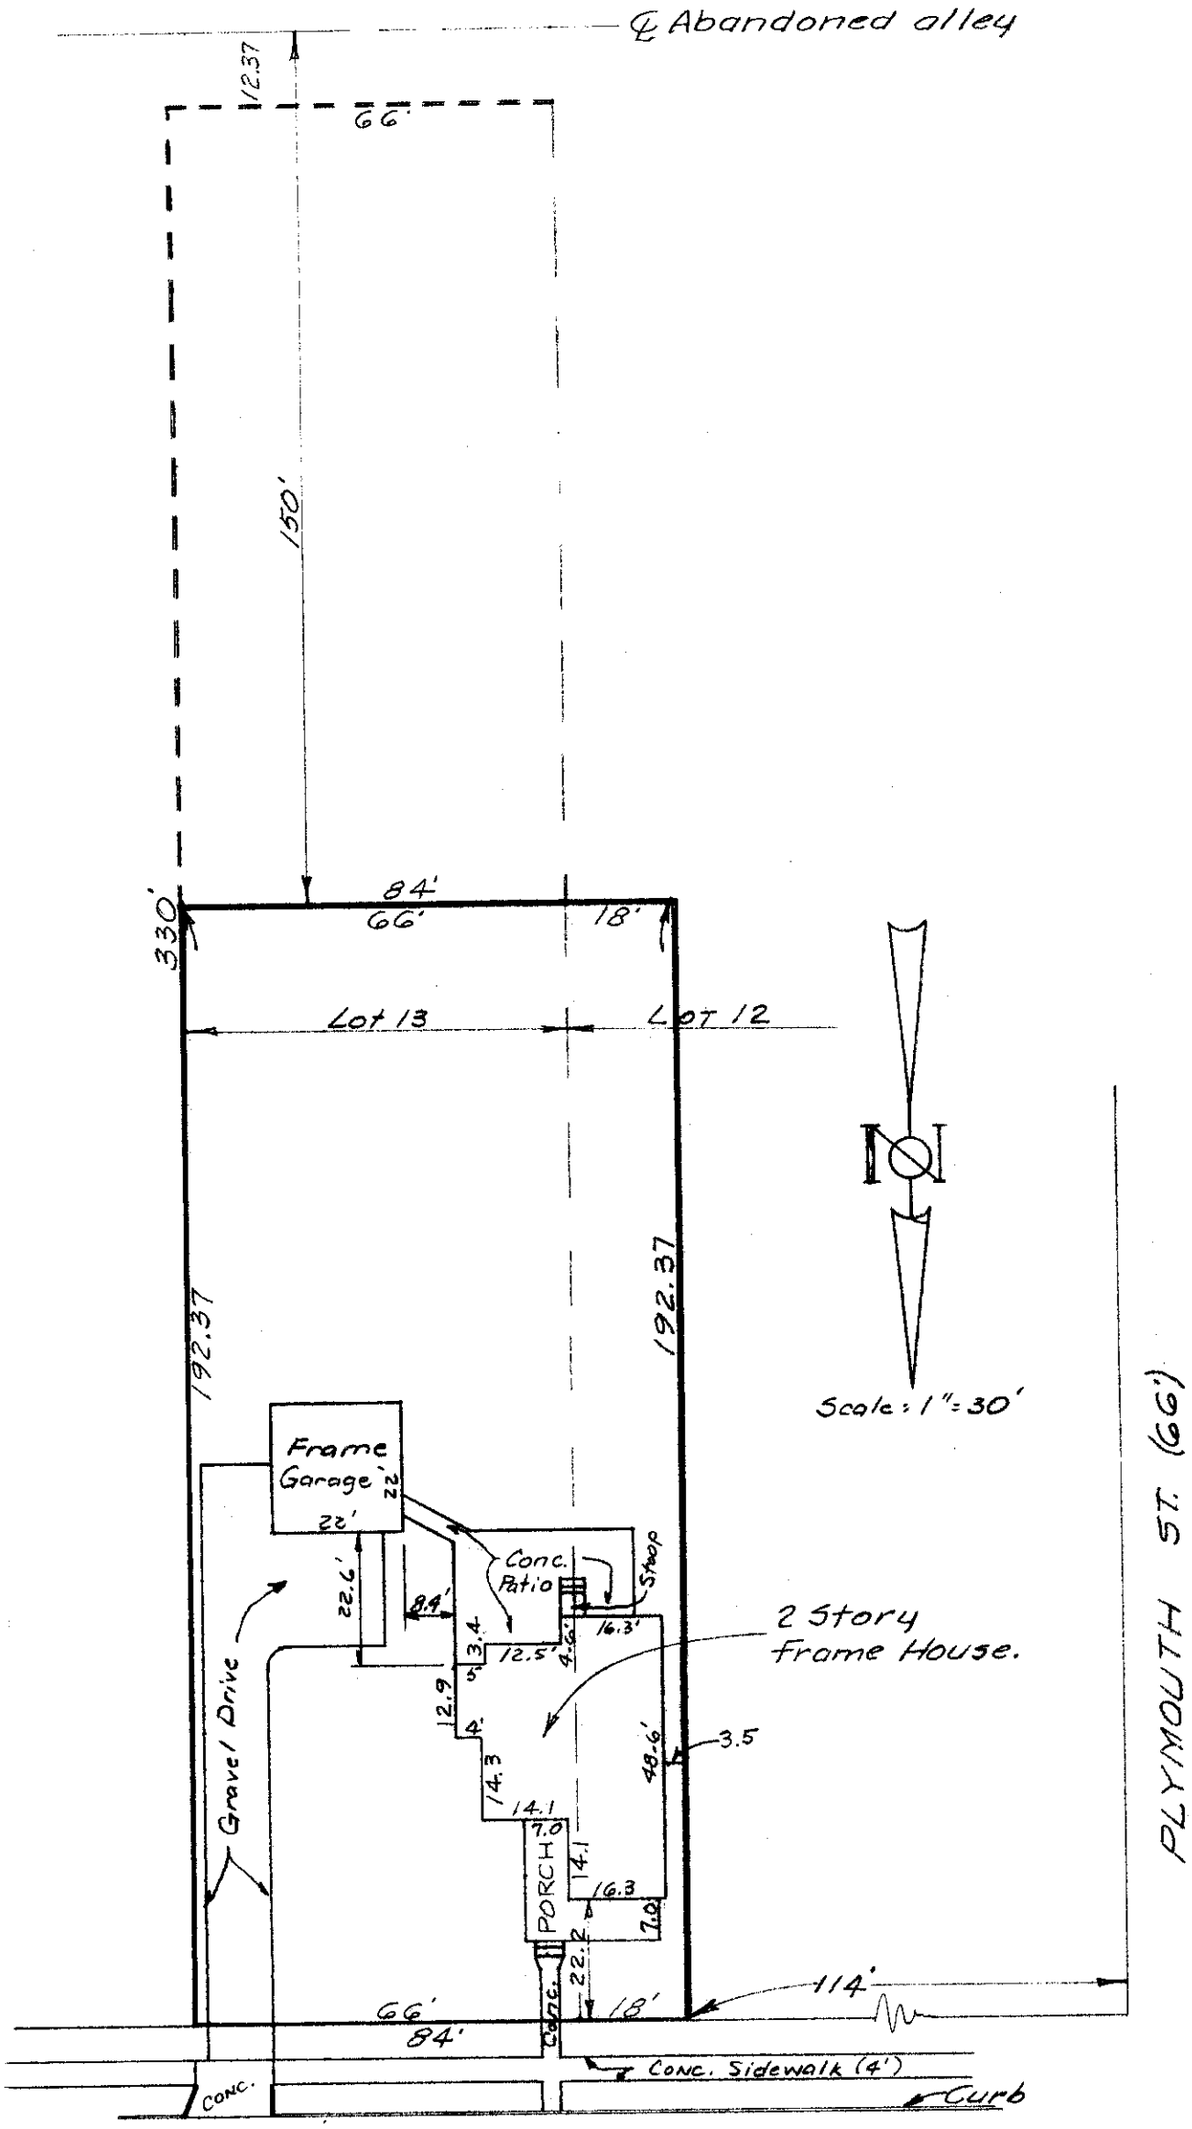

PLAT SHOWING BUILDING LOCATION FOR PREMISES AT 219 E. GRANVILLE ROAD, WORTHINGTON, OHIO, BEING LOT NO. 13 AND 18 FT. OFF ENTIRE EAST SIDE LOT NO. 12, MORRIS ADD. TO WORTHINGTON EXCEPTING 150 FT. OFF SOUTH END, MEASURED FROM CENTER OF ABANDONED ALLEY.

Harry L. Greene

Harry L. Greene, Reg. Surveyor, No. 4058

Rev. 8/30/85