

Harry L. Greene, Surveyor


2160 Tremont Center, Columbus, Ohio 43221

PLAT SHOWING SURVEY OF LOT 146 AND A PART OF LOT 147, WELLINGTON WOODS No. 5, UPPER ARLINGTON, OHIO
2448 WENBURY ROAD

RE: DI-PAOLO

FOR: BANCOHIO MORTGAGE Co.

PB. 52 Page 81 Recorders Office, FRANKLIN County, Ohio.
Scale 1" = 20' Date Aug. 21, 1985

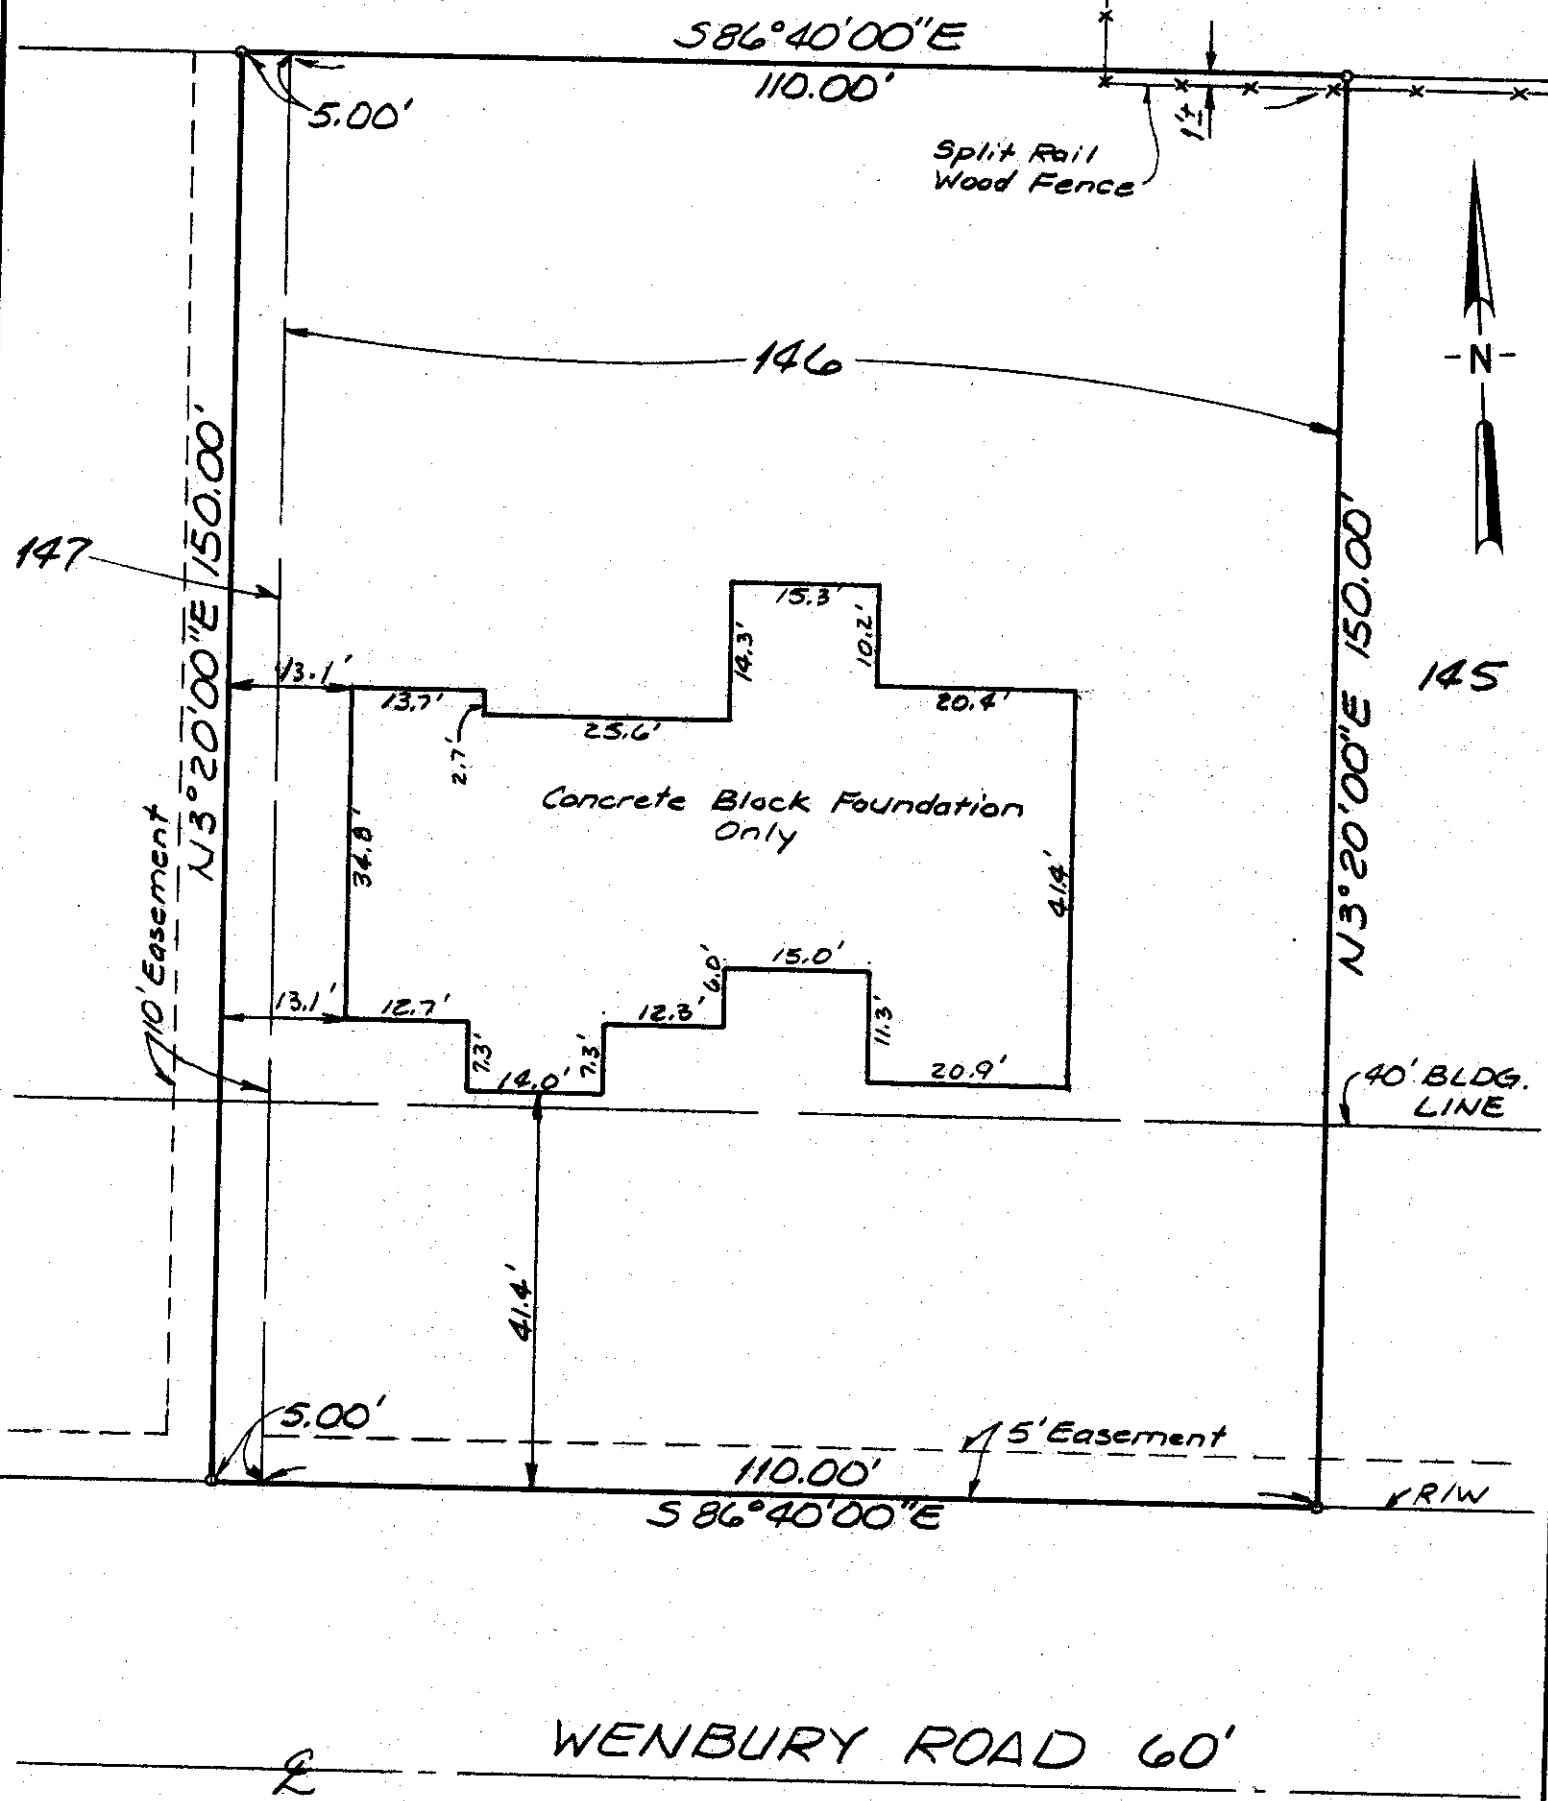

WENBURY ROAD 60'

I hereby certify the above plat has been prepared from actual survey of the premises for use in mortgage loan and title purposes only. No sideline of principal building is less than dimension shown. Property corners not located unless shown thus -o-.

Harry L. Greene
Harry L. Greene, Registered Surveyor, No. 4058