Harry L. Greene, Surveyor

2160 Tremont Center, Columbus, Ohio 43221

Plat showing Survey of Lot 27 of HASTINGS PLACE, City of Upper Arlington, Franklin County, Ohio

3662 Pevensey Drive

RE: Mrs. Paul A. Hanke

P.B. 34 Page 75 Recorders Office, Franklin County, Ohio.

Scale 1" = 20' Date August 8, 1985

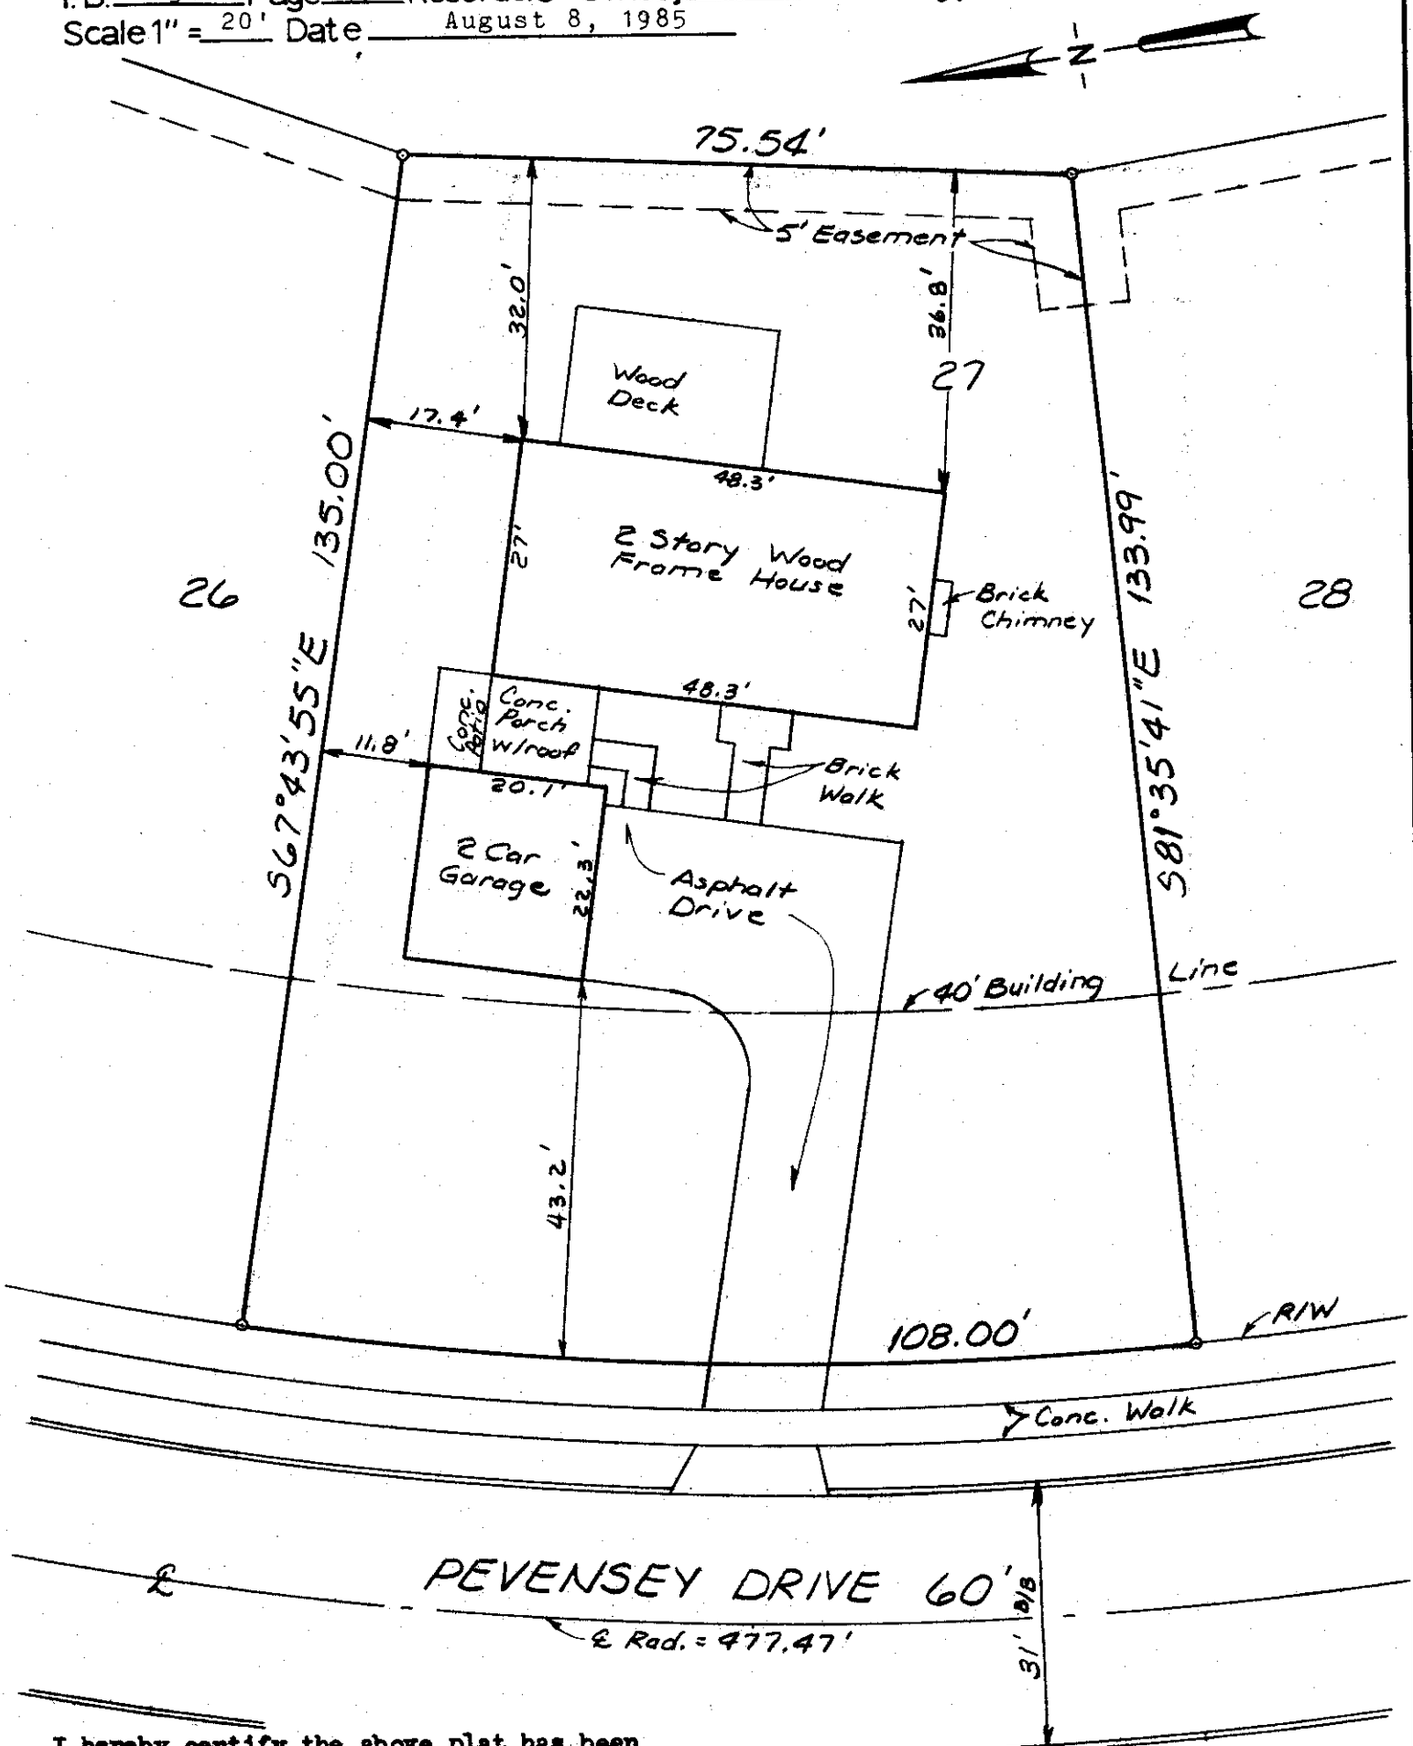

I hereby certify the above plat has been prepared from actual survey of the premises for use in mortgage loan and title purposes only. No sideline of principal building is less than dimension shown. Property corners not located unless shown thus -o-.

Harry L. Greene

Harry L. Greene, Registered Surveyor, No. 4058