


# Harry L. Greene, Surveyor

2160 Tremont Center, Columbus, Ohio 43221

Plat showing Survey of Lot 25, Saddlebrook Section No. 1,  
City of Columbus, Ohio

RE: Karen Carraher

PB. 59 Page 94 Recorders Office, Franklin County, Ohio.  
Scale 1" = 20' Date July 2, 1985

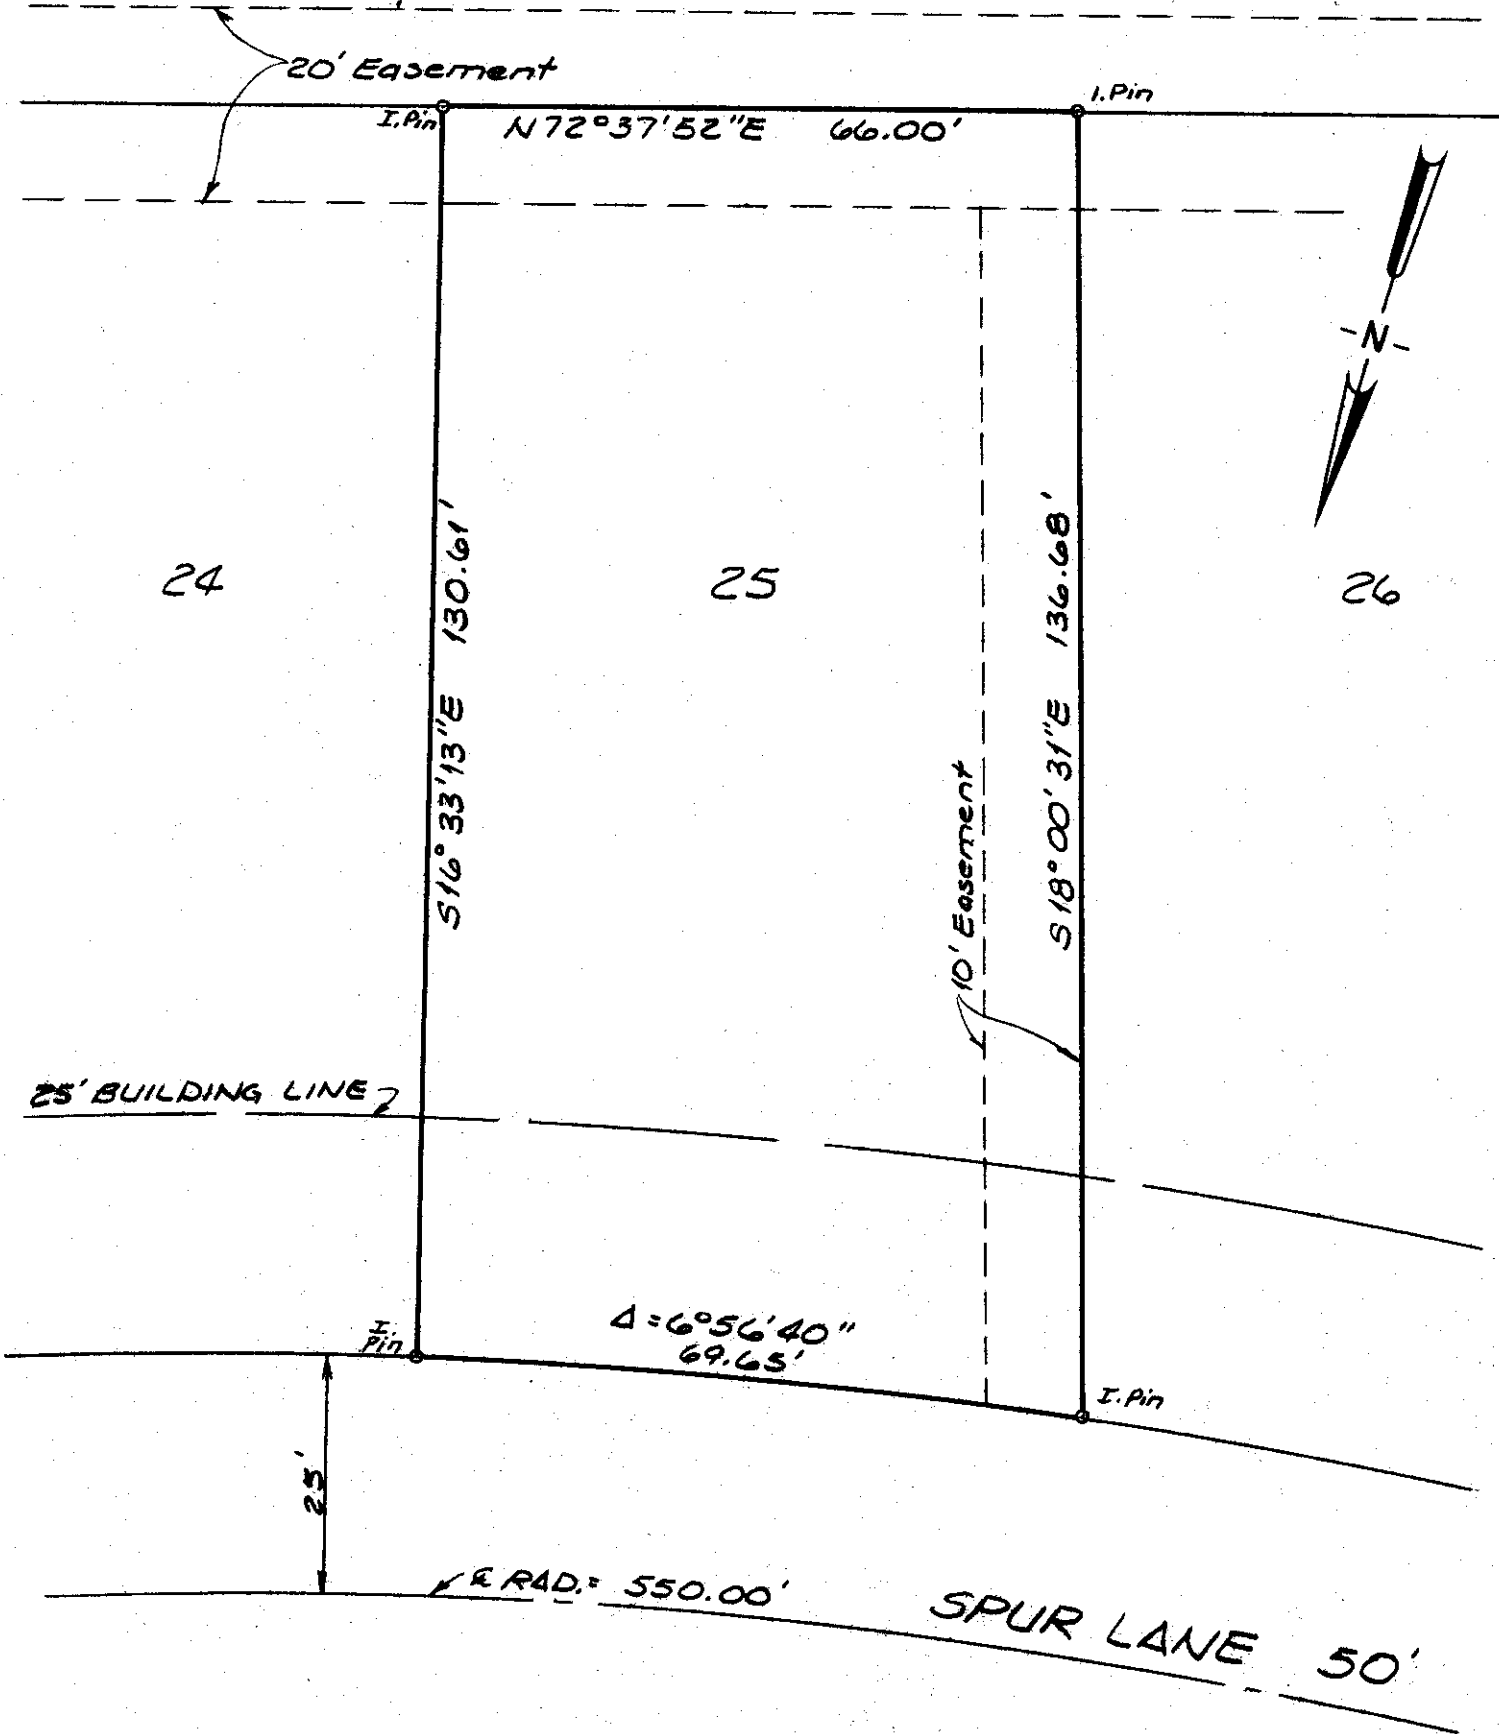

I hereby certify the above plat has been prepared from actual survey of the premises ~~for use in mortgage loans and title purposes only. No addition of principal buildings less than dimensions shown.~~ Property corners not located unless shown thus -o-.

*Harry L. Greene*  
Harry L. Greene, Registered Surveyor, No. 4058