


Harry L. Greene, Surveyor

2160 Tremont Center, Columbus, Ohio 43221

To: Buckeye Federal Savings and Loan Association
Re: Dale and Neil Iacovetta

Lot No. 304, BLESCH AND KRAMER'S SUBDIVISION
City of Columbus, Ohio

P.B. 4 Page 306 Recorder's Office, FRANKLIN County, Ohio.
Scale 1" = 20' Date March 26, 1985

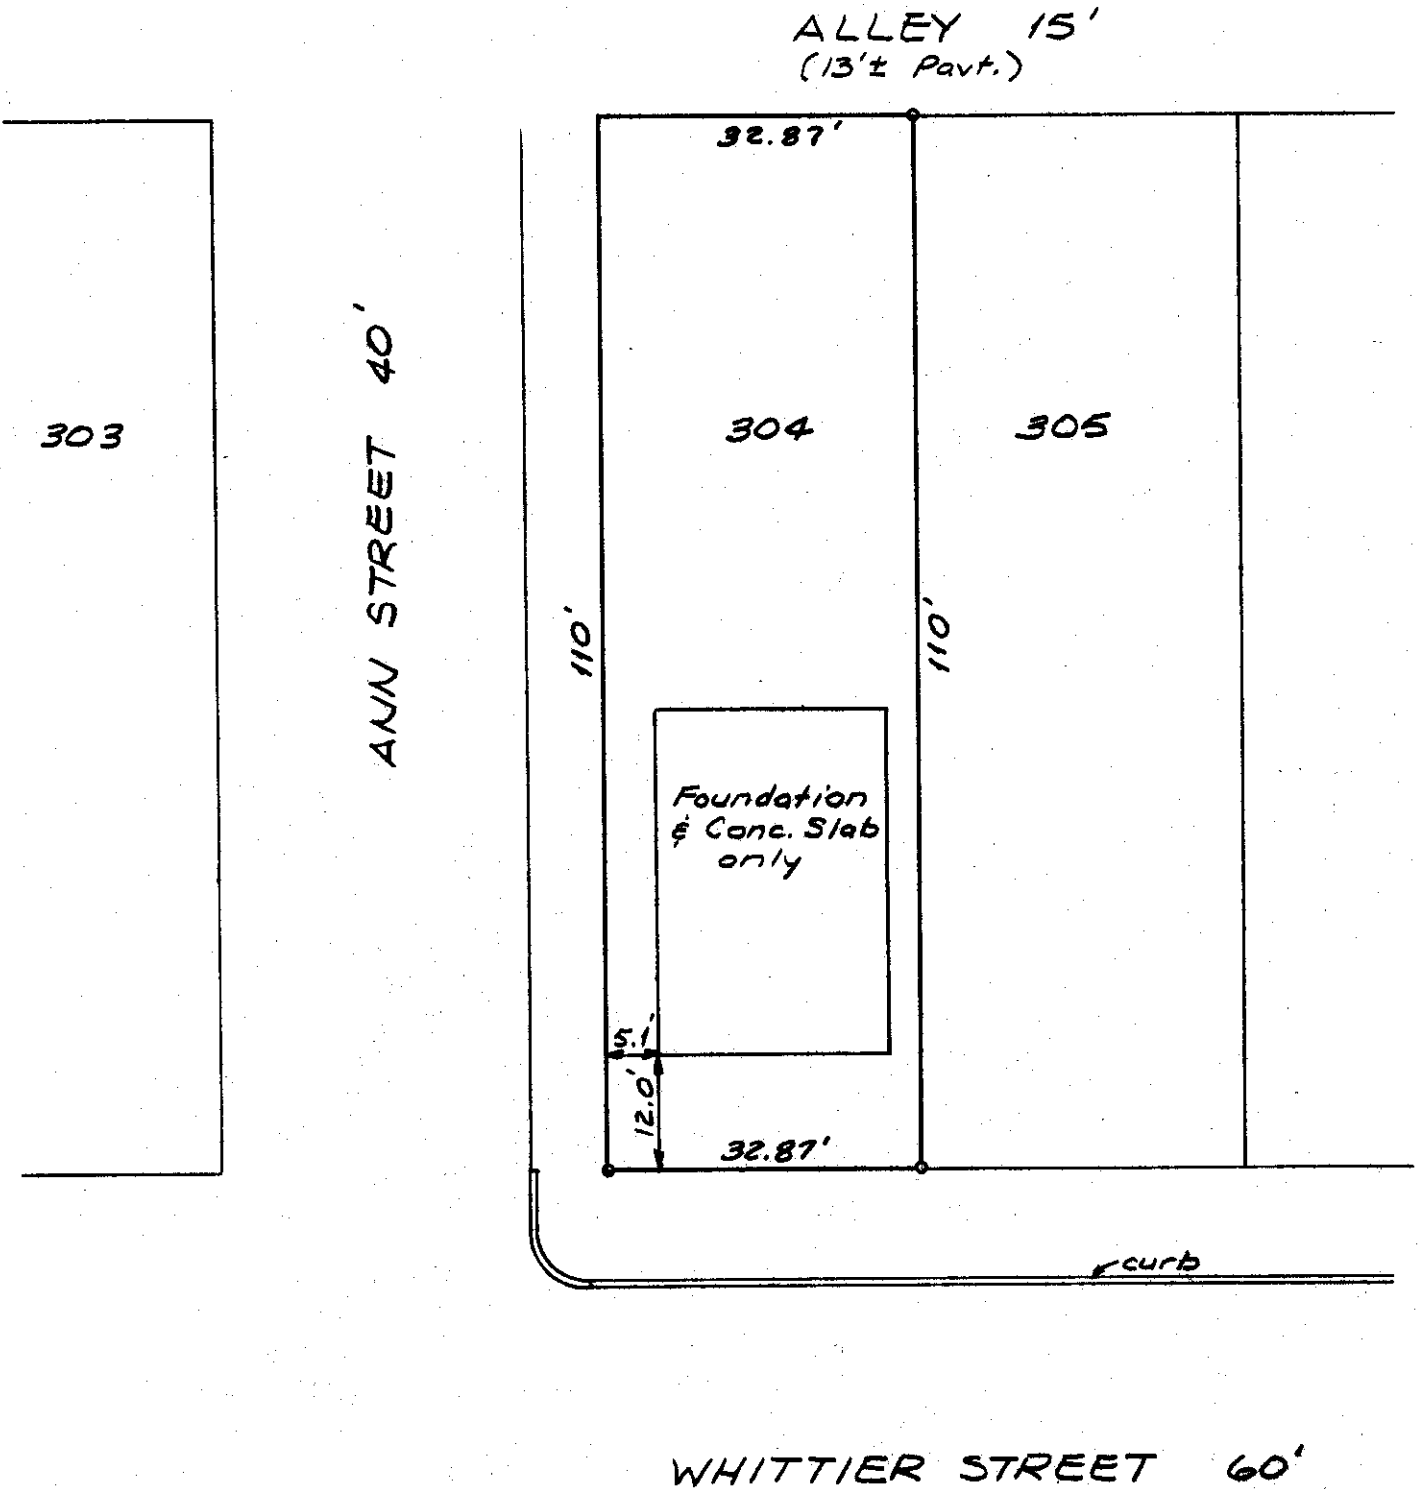

I hereby certify the above plat has been prepared from actual survey of the premises for use in mortgage loan and title purposes only. No sideline of principal building is less than dimension shown. Property corners not located unless shown thus -o-.

Harry L. Greene
Harry L. Greene, Registered Surveyor, No. 4058