


Harry L. Greene, Surveyor

2160 Tremont Center, Columbus, Ohio 43221

Plat showing survey Lot No. 20 and 15' off the entire easterly side of Lot No. 19, Block 255, City of Upper Arlington, Ohio.

RE; Jeff Criss.

PB. 20 Page 48 Records Office, Franklin County, Ohio.
Scale 1" = 20' Date January 11, 1985

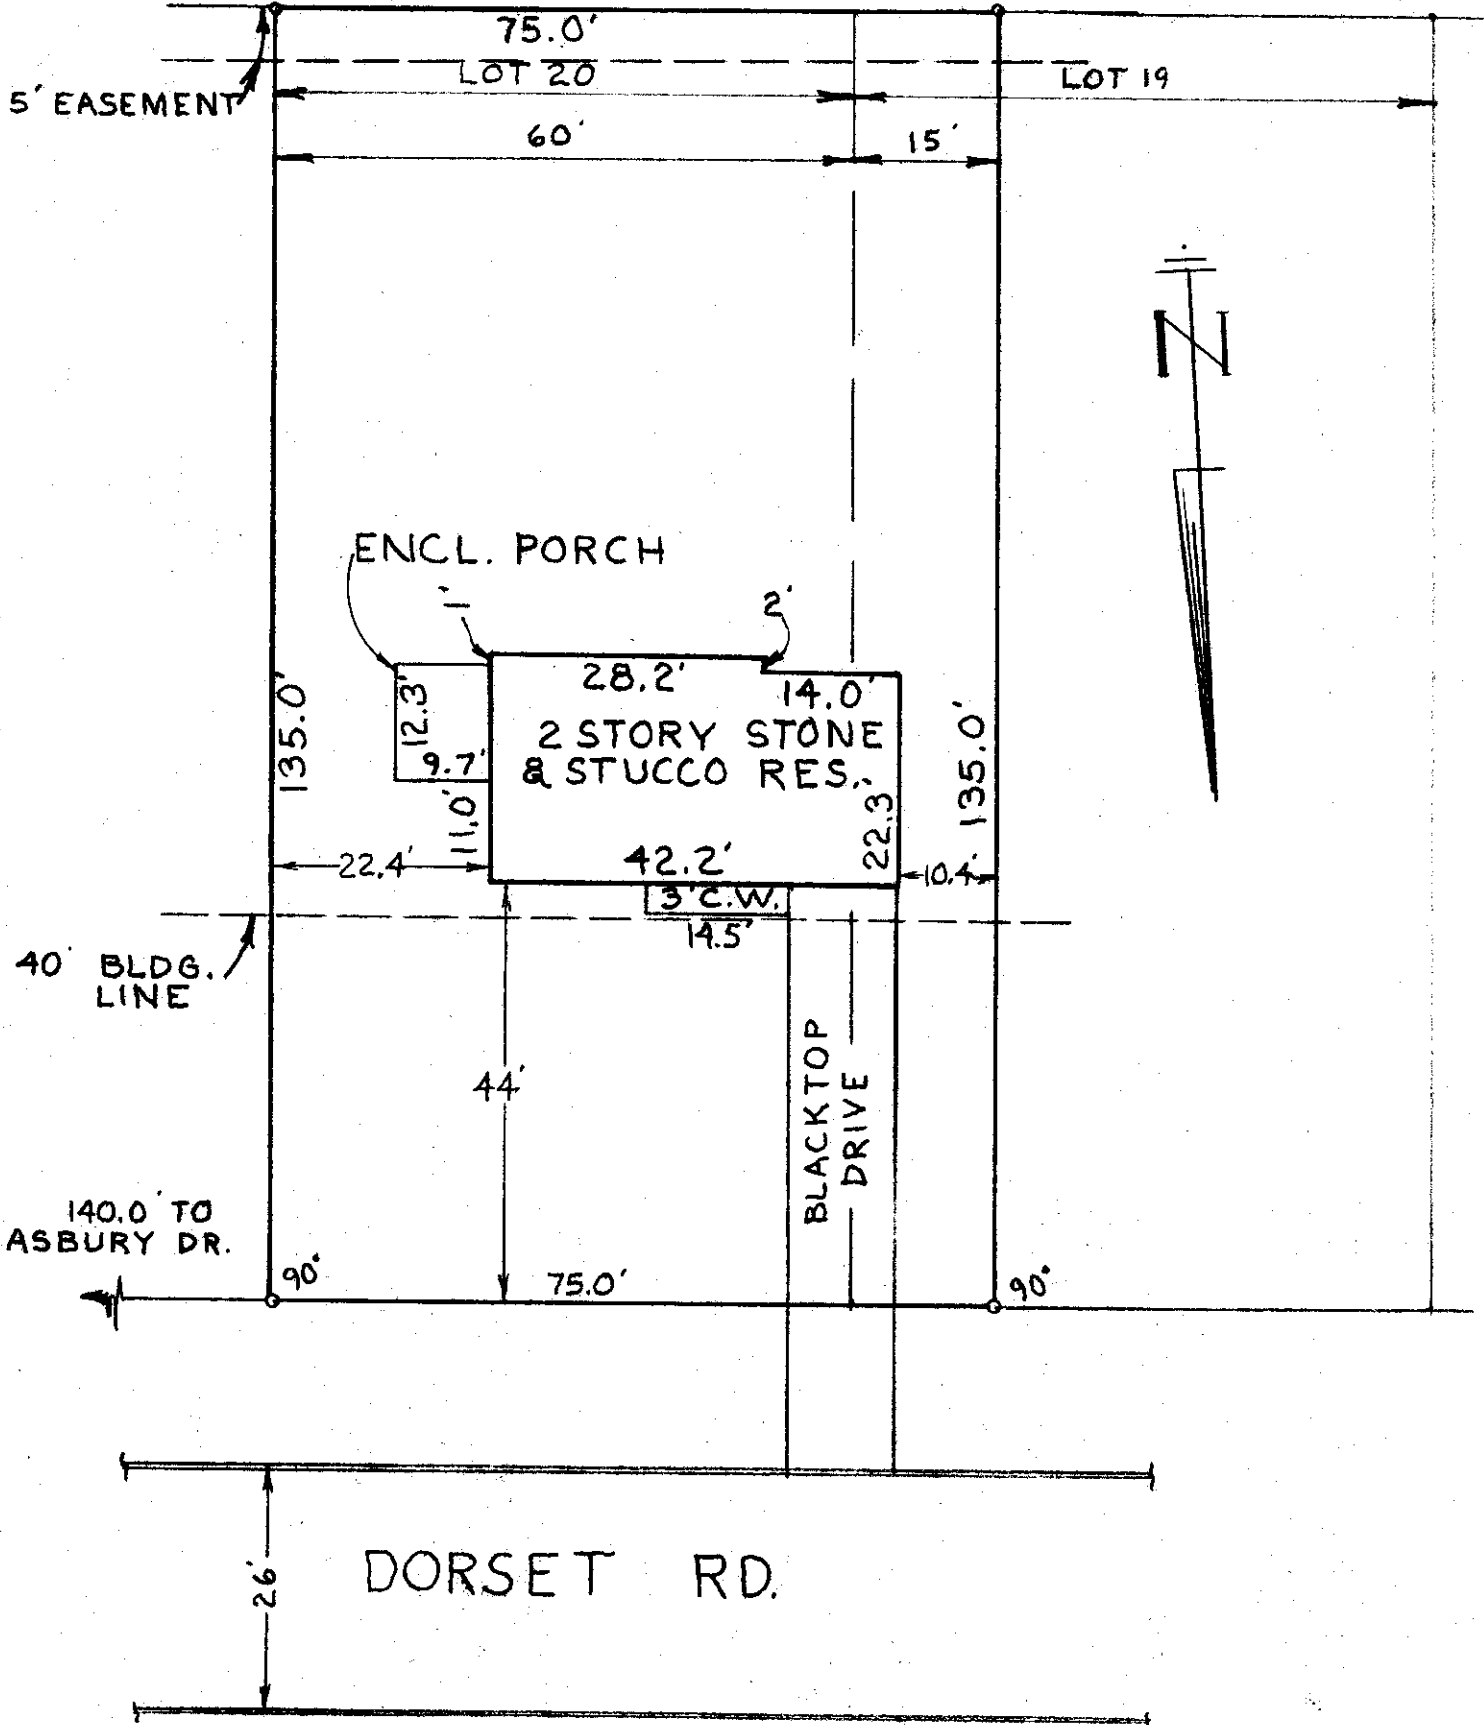

I hereby certify the above plat has been prepared from actual survey of the premises

No sideline of principal building is less than dimension shown. Property corners not located unless shown thus -o-.

Harry L. Greene
Harry L. Greene, Registered Surveyor, No. 4058