


Harry L. Greene, Surveyor

2160 Tremont Center, Columbus, Ohio 43221

PLAT SHOWING SURVEY OF LOT NO. 71, WISHING WELL ACRES, NO. 1, CITY OF COLUMBUS, OHIO, AS SHOWN OF RECORD IN PLAT BOOK 46 PAGE 86, RECORDER'S OFFICE, FRANKLIN COUNTY, OHIO.

For: Northwest Construction, Inc.

PB. 46 Page 86 Recorder's Office, Franklin County, Ohio.
Scale 1" = 20' Date December 16, 1986

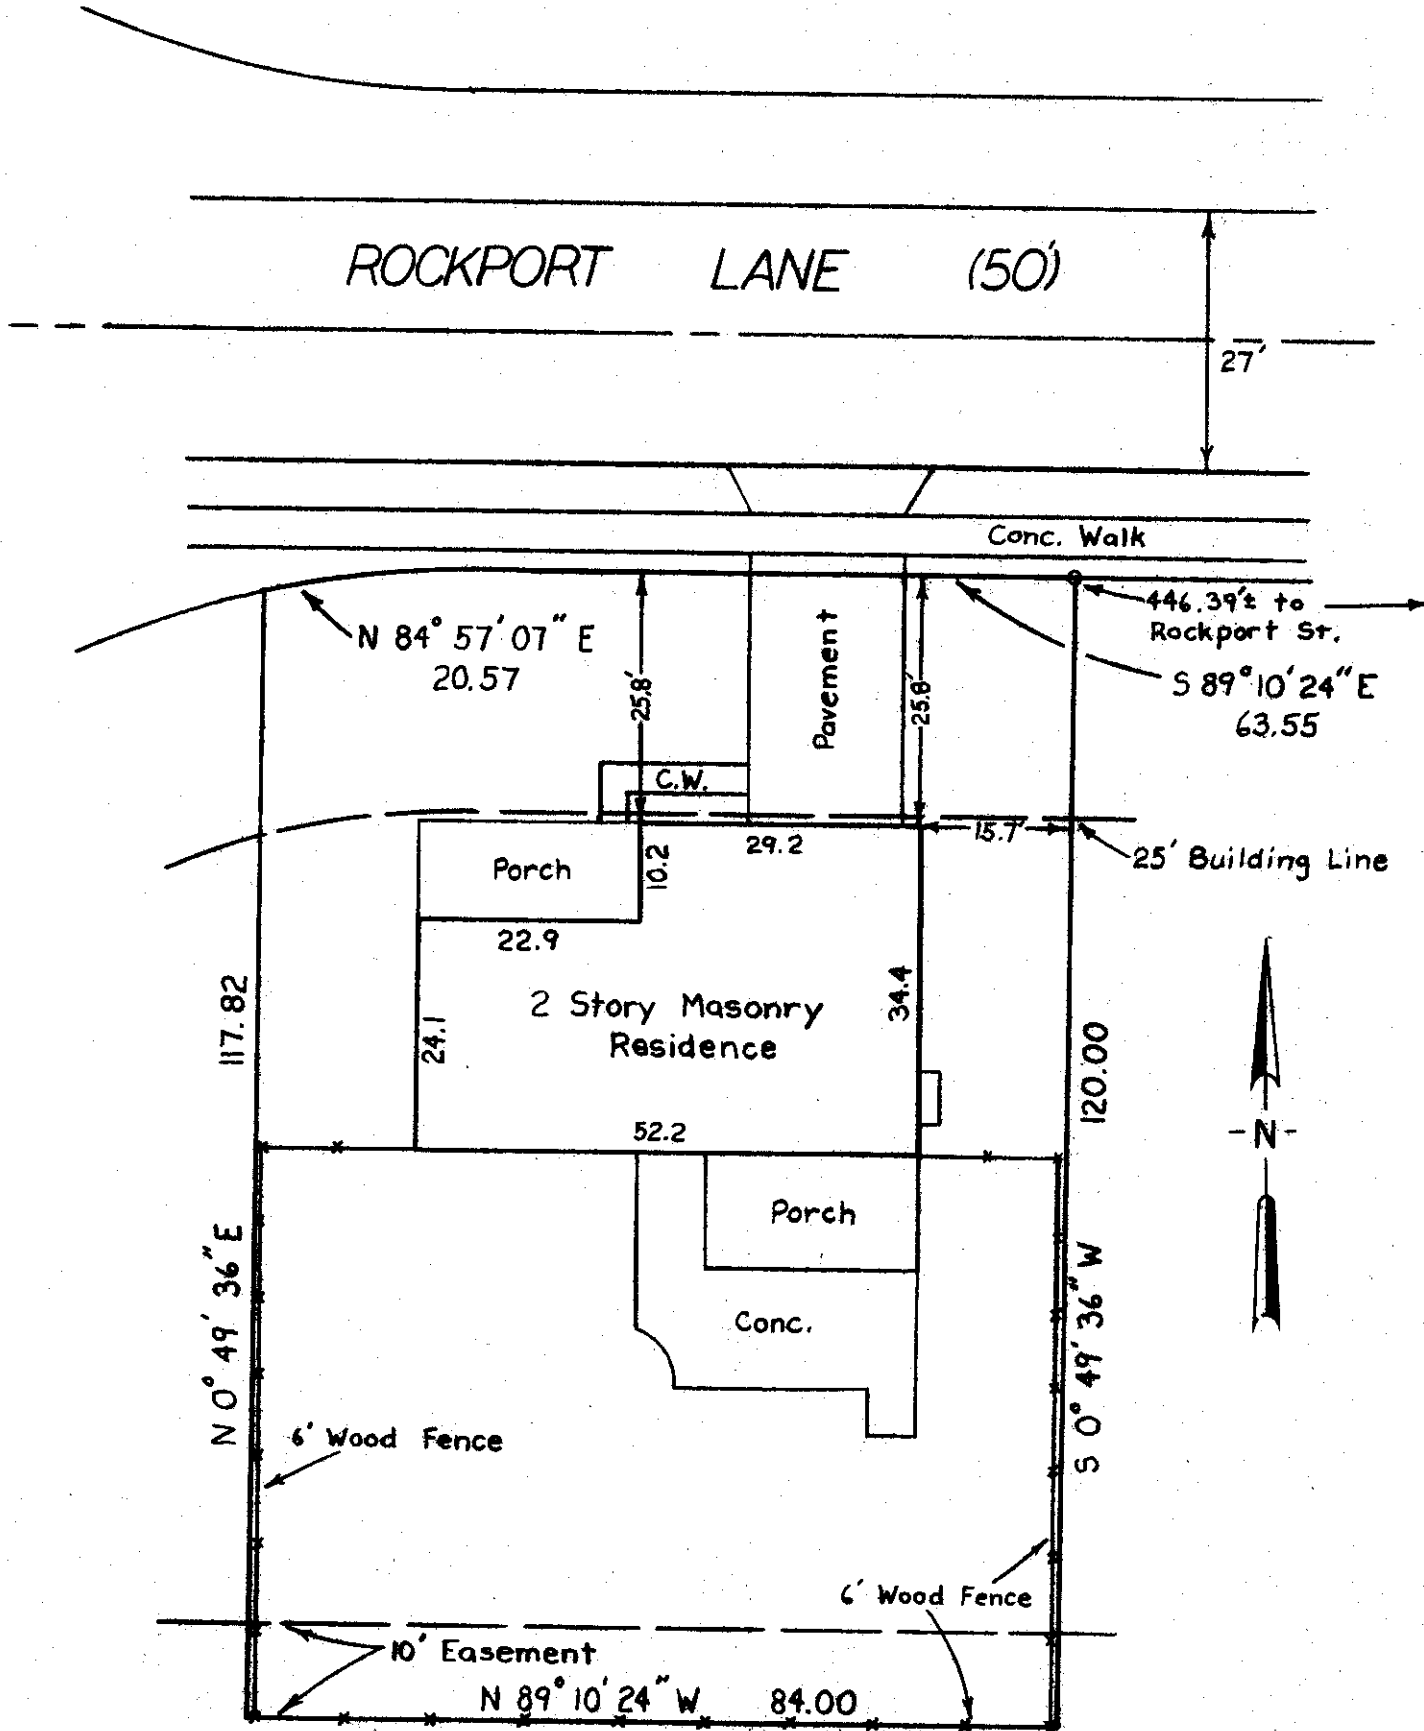

I hereby certify the above plat has been prepared from actual survey of the premises for use in mortgage loan and title purposes only. No sideline of principal building is less than dimension shown. Property corners not located unless shown thus -o-.

Harry L. Greene
Harry L. Greene, Registered Surveyor, No. 4058