Harry L. Greene, Surveyor

2160 Tremont Center, Columbus, Ohio 43221

This survey made for and at the instance of:
Arlington Manor Company, Ltd., Armstrong Mortgage Company,
Chicago Title Insurance Company,
The Columbus Mutual Life Insurance Company

Being two tracts of land, 0.66097 acre and 22,499 sq. ft.
See attached legal descriptions.

P.B. ____ Page ____ Recorders Office, Franklin County, Ohio.
Scale 1" = 40' Date ~~September 24, 1986~~ Revised Oct. 6, 1986

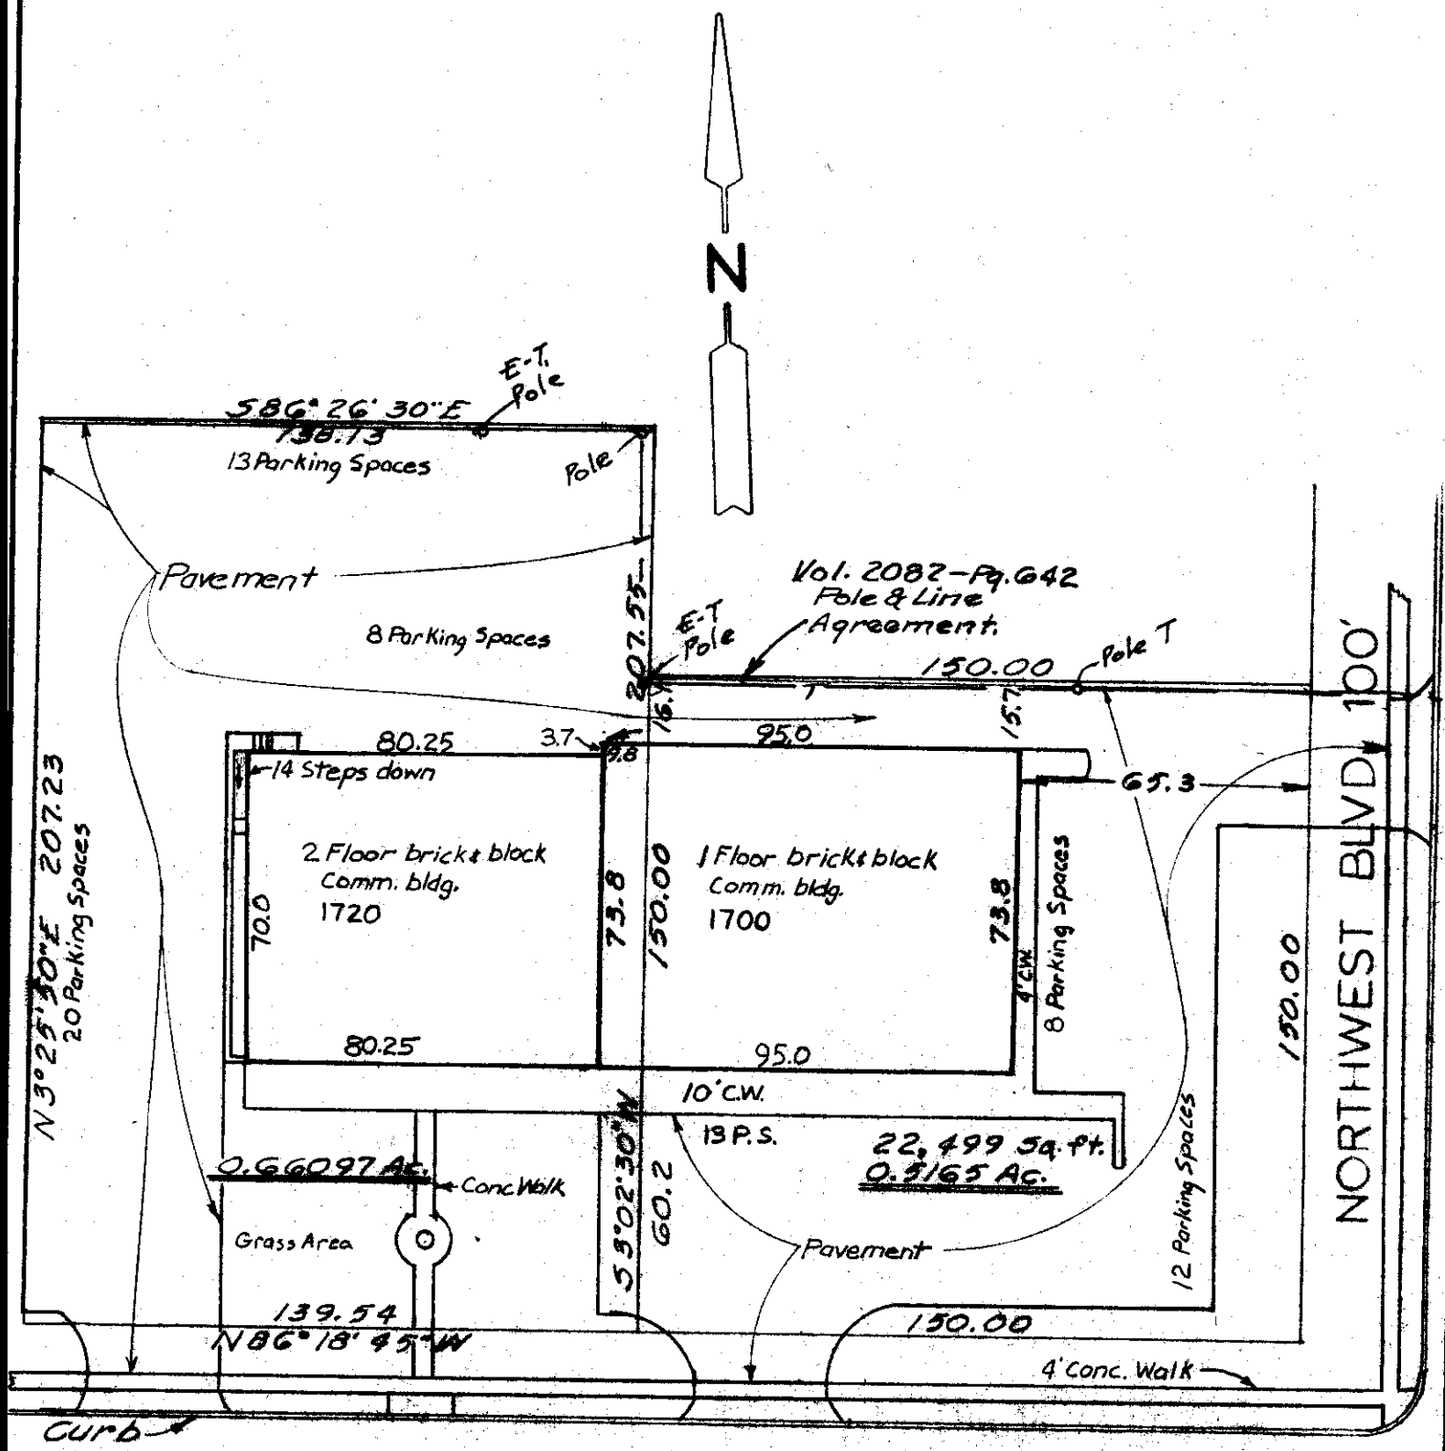

STATE OF OHIO
HARRY L. GREENE 4058
REGISTERED SURVEYOR

I hereby certify the above plat has been prepared from actual survey of the premises for use in mortgage loan and title purposes only. No sideline of principal building is less than dimension shown. Property corners not located unless shown thus -o-.

Harry L. Greene

Harry L. Greene, Registered Surveyor, No. 4058