Harry L. Greene, Surveyor

2160 Tremont Center, Columbus, Ohio 43221

To: Chicago Title Agency,
Huntington National Bank

Re: Buchanan — Being Lot No. 26, HASTINGS PLACE, Plat Book 34, Page 75, Recorder's Office, Franklin County, Ohio, and in the City of Upper Arlington, Ohio.

P.B. 34 Page 75 Recorders Office, Franklin County, Ohio.
Scale 1" = 20' Date Oct. 28, 1986

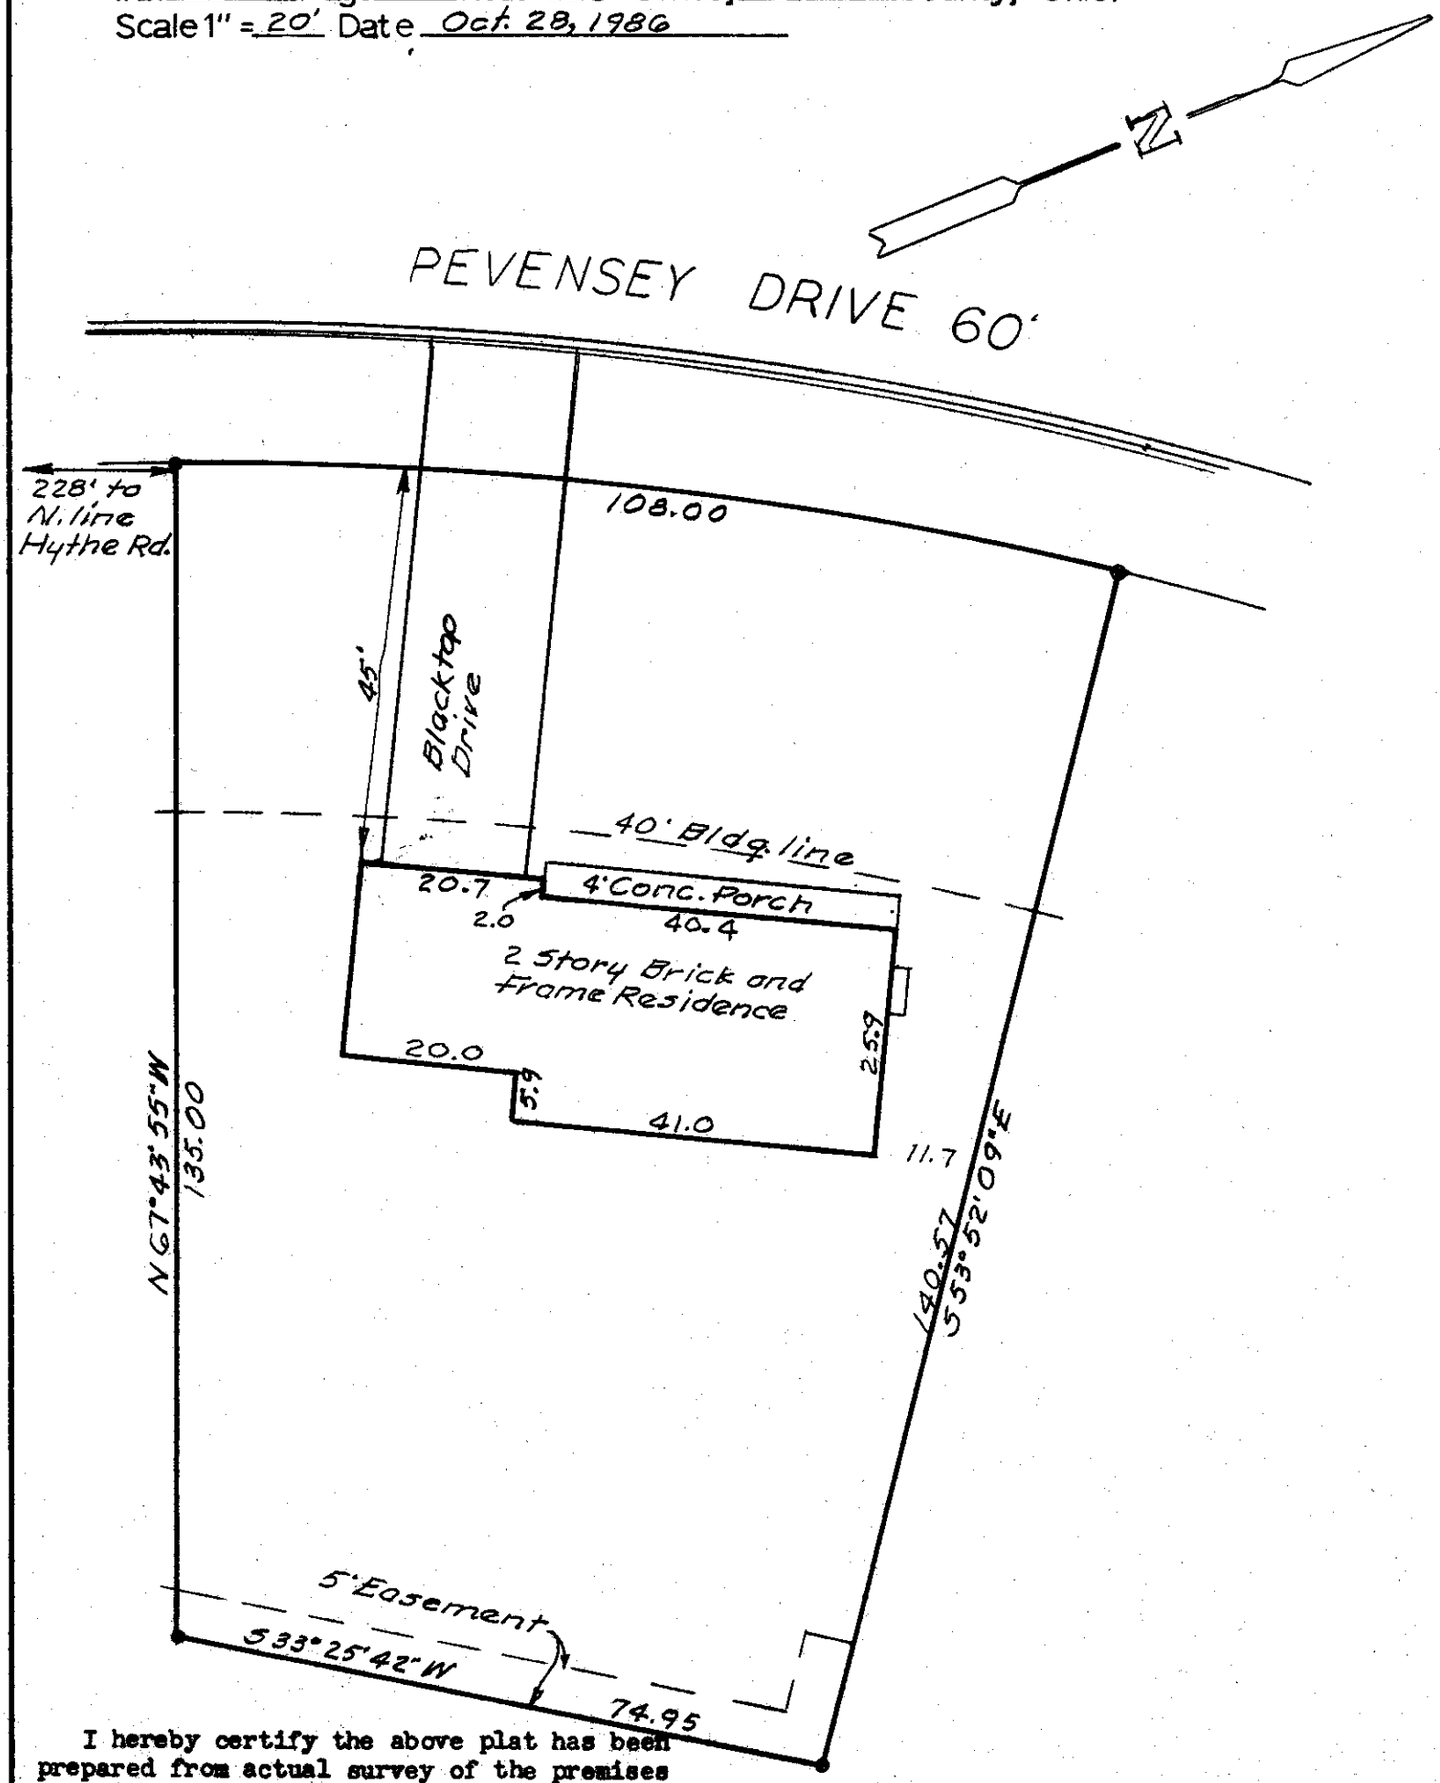

I hereby certify the above plat has been prepared from actual survey of the premises for use in mortgage loan and title purposes only. No sideline of principal building is less than dimension shown. Property corners not located unless shown thus -o-.

Harry L. Greene

Harry L. Greene, Registered Surveyor, No. 4058